SECTION 00 90 01 BIDDING AND CONTRACT REQUIREMENTS ADDENDUM NUMBER (06)

SmithGroup, Inc. 35 E Wacker Dr #900 Chicago, IL 60661 312.641.0770

To: Prospective Bidders

Issued: May 13, 2024

Re: ADDENDUM NUMBER (06) TO THE BIDDING DOCUMENTS FOR

Bid 24-032 Elgin Sports Complex Expansion

Architect's Project Number: 14106

This addendum forms a part of the bidding and contract documents and modifies the original bidding documents dated April 11, 2024. Acknowledge receipt of this addendum in the space provided on Bid Form. FAILURE TO DO SO MAY SUBJECT BIDDER TO DISQUALIFICATION.

ADDENDA TO THE PROJECT MANUAL – VOLUME 1

- 1. UPDATE Instructions to Bidders AWARD OF CONTRACT Date modified
- 2. Section 321813.10 S-Playground Turf, delete paragraph 2.1.K and replace with the following: K. Engineered playground underlayment shall consist of Safety Foam Pro or approved equal. Recycled rubber is not an acceptable underlayment material.
- Section 323300 S-Site Furnishings and Ornamental Fence, modify paragraph 2.5.A and 2.5.A.1 as follows: A. Manufacturers: Icon Shelter System, Inc., or Poligon, and 1. Models: Icon DS (Dual Slope) 36' x 64' TM or Poligon Northern Skyline 36' x 64'.

ADDENDA TO THE DRAWINGS - VOLUME 1

- 1. CD-100 SITE PREPARATION PLAN OVERALL: Added Keyed notes, revised Clear and Grub hatch, and modified sheet note.
- 2. CD-101-103 SITE PREPARATION PLAN AREA A-C: Added Keyed notes and revised Clear and Grub hatch.
- 3. CS-101: Revised Keynote D detail callout.
- 4. CS-401: Clarified Keynote G that cistern is aboveground. Added dimensions around transformers.
- 5. CS-500: Clarified Gravel Shoulder depth, Detail 4. Added clarifying text, Detail 19.
- 6. CS-503: Modified Detail 1.
- 7. CS-504, Detail 1: the callout "#6 gauge 1" mesh steel chain link fence galvanized after fabrication" should be changed to "#9 gauge 2" mesh galvanized chain link fence fabric"
- 8. CS-504, Detail 2: the callout "#6 gauge 1" mesh steel chain link fence galvanized after fabrication" should be changed to "#9 gauge 1" mesh galvanized chain link fence fabric" and applies to the panic gate and the first fence panel on either side of the panic gate.
- 9. CS-504: Modified Detail 5.
- 10. CS-505: Added Note to Detail 4.
- 11. CS-506: Modified Detail 3.
- 12. CS-508: Modified Detail 1, 2 & 3.
- 13. E-500 ELECTRICAL ONE-LINE DIAGRAM AND DETAILS Updated riser diagram, notes and schedule.

- 14. ALT-104 ALTERNATE 4 -PARKING LOT 2: Updated grading, site layout, planting, and added wall and guardrail.
- 15. ALT-500: Modified Detail 8 Xtower height.
- 16. S-500: STRUCTURAL DETAILS Updated Cistern Foundation Detail
- 17. CU-100 through CU-103 UTILITY PLAN: updates to water main design layout
- 18. CU-208 through CU-214 STORM SEWER PLAN AND PROFILE: updated pipe materials, structure, and storm sewer pipe depth/slope.
- 19. CU-215 Water Main: added profiles to provide design information for portions not previously released, updated sheet notes and legend, updated pipe materials, size, fittings/appurtenance, and depth/slope.

ADDENDA TO THE PROJECT MANUAL - VOLUME 2

1. NONE

ADDENDA TO THE DRAWINGS - VOLUME 2

- 1. A-501 TYPICAL ASSEMBLIES Detail updates.
- 2. A-611 OPENINGS SCHEDULES & TYPES Schedule updates.
- 3. A-631 MATERIAL, FINISH, & FIXTURE SCHEDULES Schedule updates.

CLARIFICATIONS – VOLUME 1:

- 1. Does allowance Items ordered by the engineer \$2,000,000 need to be bonded by the General Contractor? The allowance is part of the bid. Bonding requirements apply as specified in the Project Manual and accompanying documents.
- 2. I am reviewing the docs for what need to be submitted with the bid and it calls out Contractor Qualifications, but I am having difficulty locating what this entails. Do you just want an AIA 305? Any other requirements? Please provide a AIA 305 form and accompanying exhibits.
- 3. 1. Permits and Fees: o Will we be required to carry any permit or inspection fees in our bid or are they being waived for this project? Permits fees are anticipated to be waived for the City of Elgin, however any fees not waived are payable by the contractor. The contractor is required to secure necessary permits. Fees for inspections provided by the contractor are the contractor's responsibility.
- 4. Please advise as to whether the City of Elgin will require a building permit for the work to be provided under this contract. If so, clarify responsibility for any associated fees. Elgin does require a building permit. Fees for permits provided by the City of Elgin are expected to be waived.
- 5. Vol. 1 Page E101 Key note E108 does not appear on the drawings or any other drawing that we could locate, please provide location of this note and/or details for the site telecom scope. This keynote is in reference to telecom/fiber scope of work which was deferred to Addendum 3. Disregard this keynote and refer to Addendum 3 E-120 series drawings dated 5/2/2024 for all telecom/fiber/security scope of work.
- 6. The drawings show to bring a 2 ½" conduit into the Musco pole lights. In our electricians experience with Musco pole light bases they don't receive anything bigger than a 1 ¼" conduit. Please advise. Conduit size limitations with Musco are based on their pole size. Due to the pole size on this project, it's been confirmed that the prefab bases contain 2.5" conduit openings. No drawing changes.
- Detail 1 for the Synthetic Turf on Alternate 1 calls out the Turf Base P210 on top of the CA-7 Stone. It is our understanding that the P210 will fall into the voids that the CA-7 will create. Please advise on if there should be any additional layer of geofabric between the CA-7 and Turf Base P210. (see snip below for reference). Please bid as drawn/specified.

- Alternate 3 concerning the Playground calls our for Safety Fall Zones around the equipment. No details were provided identifying different turf in these areas. Please provide layer details for the Safety Fall Zones identified in Detail 8 on Drawing ALT-500. See Addendum 6 - ALT-500 update.
- 9. Addendum #5 listed the Nu-Edge X Tower as a 14' CFH. Please confirm that an 8' CFH is correct. **Please see updated fall heights on ALT-500 in Addendum 6**.
- 10. A keyed note for the wood benches was added to sheet CS-401 in Addendum #5. There are (11) bench locations shown on this sheet, some of which scale at 6'-0" long and some that scale at 8'-0" long. Does this bench location clarification supersede note #3 on 5/CS-506 that states we are to include (20) 8'-0" benches for bidding purposes? Please provide the number indicated on CS-506 (this number includes alternates). Additional benches are for incorporation at a later date.
- 11. Sheets IR-200, IR-201, ALT-200, and ALT-201 were re-issued in Addendum #5 with the same revision clouding and plan date as Addendum #3. We did overlays of the addendum plans (Addendum #5 in red, Addendum #3 in black) and could not find any revisions. Please clarify what changed on these plans or were the Addendum #3 plans re-issued in error. Only IR-100 was updated in the Addendum 5 issuance. This included changes to the IDPH Rainwater Re-Use and Approval Notes and The Trace Wire Notes.
- 12. After review of the site and CD's for the Tree Preservation, Removal and Salvage portion of the project, there appear to be numerous mid-size trees not addressed. Can you provide a range of tree diameters that might be considered a "maximum" size to be left on site or is Homer removing all trees? See updated CD Series sheets in Addendum 6.
- 13. Also, we feel it is likely the topsoil on site will be unusable due to the volume of brush growing onsite. To level the playing field for all bidders, can you address the potential need to import all topsoil. Contractors to determine the reusability of the topsoil based on requirements in the specifications, drawings and any site investigation/testing needed.
- 14. In the chain link specs, they call out for a 2" mesh but on Page CS-504, the chain link detail calls out for 1" mesh. See updated language in Addenda to the Drawings Volume 1
- 15. Please provide clarification on Alternate #2 for the irrigation system. There is no mention for the contractor to eliminate any scope of the base bid field 3 irrigation shown on IR-100 if Alternate #2 is selected. Please clarify. Nothing from base bid needs to be removed if Alternate 2 Field 3 Irrigation is selected.
- 16. Please clarify the quantities of the soccer and lacrosse goals required for Alternate #2. The plan view on sheet ALT-102 reissued in Addendum #3 shows two of each type, but Keyed Notes D & E on the same sheet call for four of each type. **Two of each type**.
- 17. On Page CU-214 you show multiple 24" concrete pipes going into 24" catch basins. This is not possible. There are other pages that show 12" pipe going into 12" catch basins or more 24" pipes into/ from a 24" basin as well. Please review and update the basin or pipe sizes to ones that are possible. See updated CU Series sheets in Addendum 6.

CLARIFICATIONS – VOLUME 2:

- 1. Wall type A-S, per the wall type schedule, the wall type shows that it goes to the underside of the finished ceiling. Should we include a Tear-a-way bead at this point, or tape it to the drywall ceiling? Also, this wall type runs from the corridor to the Mechanical and storage rooms, then the wall type goes to 6" above the finished corridor drywall ceiling. I am not sure what they want as Addendum #4 is not clear. Wall Type A-S3 only needs to go up to the finished ceiling, but may extend slightly above as needed for a finished wall-to-ceiling transition. Means-and-methods to achieve the finished condition may vary; tear-away bead is an acceptable solution.
- 2. For the wall type that goes to the underside of the Deck (A1S6), what is being used for the "Fire Resistive Joint System"? Are you stuffing the deck flutes and installing a metal flat stock before the Deflection Track so a "Castle Cut" is not needed for the drywall? On the exposed side, we plan on a Tear-a-way bead at the top of the wall. Additionally, we will include a tear-a-way bead at the exposed walls where there is no ceiling on the walls that go 6" above the finished ceilings. Wall Type A1S6 is a 1-hr rated partition, thus A1S6 must go to deck and be fire-sealed per 1/A-601,

means and methods to achieve the finished condition may vary, provided the rating is maintained. Please provide a submittal demonstrating compliance, for Architect's review.

- 4/A-501 Keynote 07.03 calls for (UL-1) Roofing underlayment per manufacturer requirements as specified (Div.-07), continuous entire roof deck. Is this by the standing seam roof contractor? Underlayment shall be provided as part of the standing seam roofing system, per roofing manufacturer's requirements and as needed to maintain roofing warranty; our assumption is this would be provided by the roofing contractor.
- Keynote 07.21 (Insul-2) Polyiso rigid board insulation as specified (Div.-07), 2 layers continuous between over framing members, provide (Min) thickness indicated, stagger seams. No thickness is shown. Thickness shall match the full-depth of overframing, 2X8 (7 1/4" actual) per Keynote 06.06, Sheet A-521. Drawings will be revised and dimension added for clarity, see Addendum 6, detail 4/A-501.
- Keynote 07.31 OSB/ Plywood sheathing W/ integral weather-resistive barrier as specified (Div.-07), tape seams and seal all seams and penetrations for continuous air-barrier in between the roof sections. The referenced division is incorrect, should be Division 06, see specification section 061600 B - Sheathing. Keynote will be corrected for clarity.
- All 3 Keynotes state what is specified in (Div. 07). Volume 1 Division 07 Thermal and Moisture Protection states NOT APPLICABLE. What do we include? See Volume 2 Sheet A-631, Material and Finish Schedule, 07 Thermal and Moisture Protection, INSUL-2; manufacturer may vary, please provide submittal for Architect's review and approval.
- 7. Drawing A-611, the Window Schedule shows C3 and F1 type windows going in at the Maintenance building and provides quantities. Please confirm where window types C3 and F1 are located on the maintenance building. The Type C3 windows where included in error, there are no windows of that type in the project at this time; you may disregard. The Window Schedule will be corrected, see Addendum 6 Volume 2 drawings. Type F1 is a fixed interior light between Office 2 M105 and Equipment Storage Area M106.
- 8. Please provide basis of design and spec sections for the Conc-1 and Conc-2 floor finished called out in the Room Finish Schedule. Refer to project specifications, Volume 2, "033546 B Concrete Floor Sealer and Hardener" and "096723 B Resinous Flooring."
- 9. Detail 9 Clerestory Window Head on Drawing A-531 identifies a grouted band sitting on a 2x8 above the clerestory windows in the Concession Building. Please confirm if there are any additional supports required to support the exterior facade above the clerestory windows. Refer to structural drawings for all structural requirements at headers; at the exterior facade above the window openings, the cladding is Fibercement Vented Rainscreen Siding as indicated in the Volume 2 drawing and specifications: see Exterior Elevations on sheet A-201, assembly details on sheet A-501, material schedule on sheet A-631, and specifications section "074646 B Fiber-Cement Siding." For attachment of the rainscreen cladding, provide thermally-broken fiberglass girts (GreenGirt, or equivalent) and furring strips to attach the cladding per manufacturer requirements.
- 10. The drawings call for an 8"x16" Structural Glazed Tile at the Concession Building. 8"x16" structural glazed tile is not manufactured anymore and will only come in 8"x8" units. Please confirm if we can utilize this ILO the 8"x16" glazed units. Design intent is 8"x16" running bond, per the elevations. Noted that Elgin Butler series 4W is only available in 8"x8", however the 8W series may be available in 8"x16" Please check 8W series and provide if available. Drawings will be corrected for clarity, see Volume 2, Sheet A-631, Material and Finish Schedule. If 8W series is not available, 4W 8"x8" may be submitted for review by the Architect and Engineer for approval if it meets design and structural requirements, final approval pending review of submittal.
- 11. Detail 1/A511 cut section refers to 1/A-551 which calls for the benches in the Restrooms is noted as Salvaged Wood, Section/Elevations 2&8/A-211 calls out these same benches to be SS-1. Drawing A-631 Material and Finish schedule calls out SS-1 as Solid Surface Corian. Please Clarify if Salvaged Wood or SS-1 Corian. Confirmed bench is to be solid surface (SS-1). Drawings and notes are corrected for clarity see Addendum 4, sheet A-551.
- 12. Section 5/A311 and Detail 2/A-531 the sill/counter outside the service window is not called out. On the inside you call out the Stainless Steel counter however we do not see on the exterior material

being called out, Please identify **Confirmed: Provide stainless steel, grade 316, at exterior** sill/counter at Service Window.

- 13. Please advise if Chief Buildings and/or Ceco Buildings are acceptable manufacturers for consideration in specification section 133419—Metal Building Systems. Chief Buildings and/or Ceco Buildings may be approved for this project, subject to compliance with requirements and ability to meet all aspects of the design intent per the design drawings and specifications; final approval is subject to review of a full submittal by the project Architect.
- 14. There is a conflicting Keynote on the wood soffit. This can be found on A-501 Keynote 06.05; Wood soffit by Prefabricator, confirm species, color, and finish. This is shown on Elevations 13 & 15 of the Maintenance Building soffit. "Stated conflict is not clear. The design intent is for a wood soffit at the Maintenance Building, both at the exposed underside of all eaves and at the exposed underside of the Porch. See 2/A-112 Reflected Ceiling Plan Maintenance Building for representation of the extent of soffit. Wood soffit may be provided by the prefabricator as indicated in the Keynote, or as delegated design if the prefabricator cannot meet the design intent. In either case, please provide samples for architect's review to confirm species, color, and finish, per the keynote."
- 15. 3. Related to question #8 from the previous email below, specification section 083313 references an alternate bid for stainless steel doors. If coiling counter doors are required, please advise where the alternate bid for stainless steel should be entered on the bid form. None of the scheduled alternates are related to coiling counter doors. Confirmed: lockable coiling OH counter doors are required, in addition to the sliding service windows; Galvanized or Stainless steel may be provided, meeting the design intent, no bid alternate required.

This addendum consists of (6) pages, excluding attachments.

END 00 90 01.

Attachments:

- 1. <u>Specifications Volume 1:</u>
 - a. INSTRUCTIONS TO BIDDERS
- 2. Drawings Volume 1:
 - a. CD-100 SITE PREPARATION PLAN OVERALL
 - b. CD-101 SITE PREPARATION PLAN AREA A
 - c. CD-102 SITE PREPARATION PLAN AREA B
 - d. CD-103 SITE PREPARATION PLAN AREA C
 - e. CS-101 LAYOUT AND MATERIALS PLAN AREA A
 - f. CS-401 PLAZA ENLARGEMENT
 - g. CS-500 SITE DETAILS HARDSCAPE
 - h. CS-503 SITE DETAILS NETTING
 - i. CS-504 SITE DETAILS FENCE
 - j. CS-505 SITE DETAILS SYNTHETIC FIELD
 - k. CS-506 SITE DETAILS SITE FURNISHINGS
 - I. CS-508 SITE DETAILS TRASH ENCLOSURE
 - m. S-500 STRUCTURAL DETAILS
 - n. CU-100 UTILITY PLAN OVERALL
 - o. CU-101 UTILITY PLAN AREA A
 - p. CU-102 UTILITY PLAN AREA B
 - q. CU-103 UTILITY PLAN AREA C
 - r. CU-208 STORM SEWER PLAN AND PROFILE
 - s. CU- 209 STORM SEWER PLAN AND PROFILE
 - t. CU-210 STORM SEWER PLAN AND PROFILE
 - u. CU-211 STORM SEWER PLAN AND PROFILE
 - v. CU-212 STORM SEWER PLAN AND PROFILE

- w. CU-213 STORM SEWER PLAN AND PROFILE
- x. CU-214 STORM SEWER PLAN AND PROFILE
- y. CU-215 WATER MAIN PLAN AND PROFILE z. ALT-104 ALTERNATE 4 PARKING LOT 2
- aa. ALT-500 ALTERNATE DETAILS

3. <u>Specifications – Volume 2:</u>

a. None

4. Drawings – Volume 2:

- a. A-501 TYPICAL ASSEMBLIES
- b. A-611 OPENINGS SCHEDULES & TYPES
- c. A-631 MATERIAL, FINISH, & FIXTURE SCHEDULES

INFORMATION FOR AND INSTRUCTIONS TO BIDDERS

1. DEFINITIONS AND TERMINOLOGY

Definitions, of the General Terms and Conditions of the Contract ("General Terms and Conditions") included in the Project Manual are incorporated by reference as if fully rewritten herein. In the event of a conflict between the definitions herein and those found in the General Terms and Conditions, the former shall govern for the purpose of this section only. All other terms which are not herein defined have their ordinary dictionary meaning.

ADDENDUM (ADDENDA, PLURAL)-An Addendum is a document issued by the City prior to the opening of the General Bids which clarifies, amends, or modifies the Bidding Documents or the Contract Documents.

ALTERNATE BID-An Alternate Bid (or An Alternate) is a proposal for work which is bid alternatively to the original bid proposal pursuant to instructions contained in the Bid Form. Such alternative bids may include proposals for work that is different in scope from that contained in the Base Bid.

BASE BID-A Base Bid is the sum proposed by a Bidder to perform the Work and does not include any Alternate Bids.

BID-A Bid is a proposal to do the Work for a specified sum and includes accompanying forms which are required to be submitted.

BIDDER-A Bidder is an entity that submits a Bid.

BIDDING DOCUMENTS-The Bidding Documents are comprised of the entire Project Manual, which includes, but is not limited to, the Invitation to Bid (advertisement), the Instructions to Bidders, all of the forms (e.g., Bid forms, sample Agreement form, bond forms), the wage rates, the General Terms and Conditions of the Contract, any supplementary terms and conditions thereto, the Drawings, the Specifications, and all addenda.

BUSINESS DAYS-Business days are defined as all days of the week excluding Saturdays, Sundays, and those holidays for which the City offices are closed for observance.

CONTRACT DOCUMENTS- The Contract Documents consist of the Agreement, the Certificates of Insurance, Bonds, Notice of Award, Notice to Proceed, General Conditions, Supplementary Conditions, Specifications, Drawings, Addenda, Contractor's Bid, City Forms, and any subsequent written amendments to the documents listed herein.

PROJECT-The Project is the total Construction to be provided under the Contract Documents and the Work may be the whole or a part of the Project as indicated elsewhere in the Contract Documents and may include construction by the City or by separate contractors. The Project is the Work described in the Bidding Documents.

PURCHASING DEPARTMENT-The Purchasing Department refers to the City of Elgin Purchasing Department located at 150 Dexter Court, Elgin IL.

WORK-Work refers to the services and the entire completed construction or the various separately identifiable parts thereof required by the Contract Documents, including all labor, materials, and equipment furnished, furnished and incorporated into the Project, or to be provided by the Contractor to fulfill the Contractor's obligations. The Work may constitute the whole or a part of the Project.

2. COPIES OF BIDDING DOCUMENTS

A Bidder may obtain complete sets of Bidding Documents <u>https://cityofelgin.ionwave.net/VendorRegistration/PreliminaryInfo.aspx</u>,

No partial sets of Bidding Documents shall be issued.

It is the responsibility of the Bidder to insure that it has obtained a complete set of Bidding Documents. Complete sets of Bidding Documents shall be used in preparing Bids. The City shall not be liable for errors or misinterpretations resulting from the use of incomplete sets of Bidding Documents, or any other reason, in preparing the Bids.

Distribution of the Bidding Documents is for the sole purpose of obtaining Bids and does not confer a license or grant permission for any other use of the Bidding Documents.

3. STATE WAGE RATE REQUIREMENTS

The minimum prevailing wage rates are included with the Bidding Documents and apply to this Project. Bidder shall comply with all statutory requirements regarding prevailing wage rates.

Bidder, if awarded the contract, will keep accurate records showing the name, address, telephone number, social security number, occupation, hourly wages (including itemized hourly cash and fringe rates), hours worked each day, gross and net weekly wages for each laborer, worker and mechanic employed on the Work. The records shall be provided on a weekly basis to the City. The bidder shall collect and forward to the City the certified payrolls of all its subcontractors. The prevailing wage for any trade may change during the life of the Project. The selected Bidder and all its subcontractors shall be responsible for checking the Illinois Department of Labor web page (http://www.state.il.us/agency/idol/) to ensure that they are paying the current rate. If the City discovers any discrepancies between the prevailing wage rates as apply to the Work and the Bidder's payrolls, or if the Bidder or a subcontractor fails to submit payrolls, no further payments shall be made to the Bidder until the discrepancy is corrected.

4. QUESTIONS AND INTERPRETATIONS

All questions about the meaning or intent of the Bidding Documents shall be submitted in writing to the City's Purchasing Director or applicable department contact specified in the Invitation no later than five calendar days prior to the date set for the opening of Bids. Any questions received after such time shall be answered at the discretion of the City.

Written clarifications or interpretations shall be issued by the Purchasing Department in the form of an Addendum. Only questions answered by an Addendum shall be binding. Oral clarifications or interpretations shall be without legal effect. Addenda shall either be faxed or emailed to all persons having received Bidding Documents from the Purchasing Department.

Each Bidder shall be responsible for determining that it has received all Addenda issued.

A Mandatory Pre-Bid meeting will be held on April 24, 2024 at 3:00 pm CDT. The meeting will be held at the Centre of Elgin, 100 Symphony Way, Elgin, IL 60120 in the Administration Offices conference room. The Mandatory Pre-Bid meeting will also be held via ZOOM at this link <u>https://us06web.zoom.us/j/5244460513?pwd=QXkzSkIOMjI2T1hKTVh2eG9hbG9Odz09&omn=89574</u> 302964. Meeting ID: 524 446 0513, Passcode: 0K70sB. Or one tap mobile 13126266799,,5244460513#.Any entity planning to submit a Bid must attend or participate.

5. THE BID

BIDDER'S REPRESENTATIONS.

In submitting a Bid, the Bidder represents that:

- it has read and examined the Bidding Documents thoroughly;
- it understands the Bidding Documents;
- the Bid is made in accordance with the Bidding Documents;
- it has visited the site, has become familiar with the conditions of the site and the surrounding area, and has familiarized itself with local conditions that may in any manner affect cost, progress, or performance of the Work;
- it has correlated its own observations with the Bidding Documents;
- it has found no errors, conflicts, ambiguities, or omissions in the Bidding Documents, except for those that it has brought to the City's attention either orally at a pre-bid conference or in writing at least five (5) calendar days prior to submitting its Bid;
- it is familiar with all of the applicable Federal, State, and City laws, rules, regulations, and procedures affecting its Bid and its Bid is in conformity with those laws, rules, regulations, and procedures;
- the Bidder has complied with every requirement of these Instructions and that the Bidding Documents are sufficient in scope and detail to indicate and convey an understanding of all terms and conditions for the performance of the Work; and
- Bidder hereby waives and releases any and all rights it may have pursuant to the Public Construction Contract Act, 30 ILCS 557/1 et.seq.

BID CONTENTS.

The checklists below are included for the bidders' convenience only and shall not be construed to constitute a waiver or abridgement of the City's right to reject any or all bids.

A Bid shall include:

- a completed Bid form
- a Bid deposit;
- Certification Requirements
- Bidder's Employee Utilization
- Sexual Harassment Forms
- Responsible Bidder's Affidavit
- Qualifications of Bidder
- Signed Agreement

RIGHT TO WAIVE INFORMALITIES AND PERMIT CURATIVE MEASURES.

The City reserves the right to waive any Bid informalities. The City may permit bidders who fail to include forms not otherwise required by law to cure such omission(s) within five days of bid opening, in the City's sole discretion.

Bid Deposits: Unless otherwise stated, every Bid shall be accompanied by a Bid deposit in the form of an original Bid bond, certified check or a treasurer's, or cashier's check issued by a responsible bank or trust company, payable to the City of Elgin. The Bid bond shall be (a) in a form satisfactory to the City; (b) with a surety company qualified to do business in the state of Illinois and satisfactory to the City; and (c) conditioned upon the faithful performance by the bidder of the terms contained in the Bid. The Bid deposit shall be not less than <u>five</u> percent (<u>5 %</u>) of the value of the Bid.

Bids Forms. Each Bid shall be submitted on the Bid form included in the Project Manual. In the case of a conflict between dollar figures and words, written amounts shall control over dollar figures. All blank spaces shall be filled. Any and all blank spaces shall constitute sufficient cause to reject any bid. The Bid form shall be completed in ink or by typewriter.

Acknowledgment of Addenda. Each Bidder shall acknowledge the receipt of all Addenda (the numbers of which are to be filled in on the Bid form by the Bidder). A Bidder's failure to acknowledge any Addendum shall constitute sufficient cause for rejection of a bid at the City's sole discretion.

SUBMISSION OF A BID.

Prior to the deadline for receipt of Bids, each Bid Bond shall be submitted to the Purchasing Department in a sealed envelope which is plainly marked on the outside with the name and address of the Bidder, the title of the Project, and the date and time of the Bid opening no later than <u>May 9, 2024 at noon</u> <u>CDT</u>. All Bid submissions must be entered into the City of Elgin's web portal at <u>https://cityofelgin.ionwave.net/VendorRegistration/PreliminaryInfo.aspx</u>, no later than <u>May 9, 2024 at 3:00</u> <u>pm CDT</u>. Any Bid received after the deadline shall not be accepted. Any Bid submitted to any other office or department of the City and received by the Purchasing Department after the deadline for receipt of Bids shall not be accepted. It is the responsibility of the Bidder to ensure that its Bid is received by the Purchasing Department in a timely fashion. The deadline for receipt of Bids can be extended by Addendum only.

Bids may not be submitted orally, by facsimile, by telephone, or by any other method except for the method described above.

MODIFICATION OF A BID.

A Bid may be modified only by submitting any such modification executed in the same manner as portal Bid. through the City of Elgin's web at а https://cityofelgin.ionwave.net/VendorRegistration/PreliminaryInfo.aspx. Contact the Purchasing Department for instructions.

WITHDRAWAL OF A BID.

Prior to Bid opening. A Bid may be withdrawn before the time designated for opening Bids. All requests for withdrawal of a bid shall go through the City of Elgin's web portal at <u>https://cityofelgin.ionwave.net/VendorRegistration/PreliminaryInfo.aspx</u>. Contact the Purchasing Department for instructions. Withdrawal of a Bid prior to the Bid opening time shall not prejudice the right of a Bidder to resubmit a Bid. A Bid cannot be withdrawn after the Bid opening time except as provided in the Bidding Documents.

After Bid opening. In the case of death, disability, clearly apparent clerical error, a Bidder may withdraw its Bid after the time designated for Bid opening, if within five (5) days of the date designated for opening its Bid, such Bidder submits a statement under the penalties of perjury to the Purchasing Department detailing the basis for withdrawal. The City shall then make a determination as to whether

such Bidder shall be permitted to withdraw such bid. Such a determination shall be in the City's sole discretion. In such case, the Bid Deposit shall be returned to the Bidder.

BID OPENING.

All Bids received prior to the date and time designated for the Bid opening shall be available on the City's electronic web portal at <u>https://cityofelgin.ionwave.net/AwardedSourcingEvents.aspx</u>.

PUBLIC BID REVIEW AND INSPECTION.

Upon opening, all Bids become public records except for any portions thereof that are not subject to public disclosure as a matter of law.

Bids may be reviewed by the public in a manner set forth by the Purchasing Department.

Any Bidder who objects to a Bid may protest the Bid. Bid protests shall be governed by Elgin Municipal Code Chapter 5.26.

LOCAL PURCHASING PREFERENCE: Bids from responsible and responsive local businesses that do not exceed the lowest bid price from a responsive and responsible nonlocal business by more than two percent (2%) but no more than \$500 for contracts of \$25,000 or less or by more than one percent (1%) but no more than \$2,500 for contracts in excess of \$25,000 shall be awarded to the local businesses. A local business is a business authorized to do business under the laws of the City of Elgin, a business with its principal place of business located within the corporate limits of the City of Elgin, which has the majority of its regular, full-time workforce located within the City of Elgin and is subject to City of Elgin taxes including, but not limited to, sales taxes.

6. RESERVATION OF RIGHTS TO REJECT BIDS

The City reserves the right to reject any or all Bids, if it is in the public interest to do so.

The City reserves the right to reject the Bid of any Bidder who, either in its own right or through an affiliation with another entity which the City has determined has not completed a prior project, whether with the City or elsewhere, because of the fault of the Bidder, its Subcontractors or employees; has been declared in default on a prior contract whether with the City or elsewhere; has failed to complete a prior project in a timely fashion whether with the City or elsewhere; based on its work record, is not capable of performing the within Contract whether due to lack of sufficient prior experience, as determined by the City, or any other reason; has a work record of its Subcontractors demanding direct payment from the owner; has a work record of its Subcontractors, employees or material suppliers complaining to the City or other awarding authority by persons offended by the behavior of the Bidder, its Subcontractors or employees; or has a record of its failure to comply with State of Illinois and/or City laws or requirements. "Work record" or "record" constitutes a minimum of one event in the work history of the Bidder.

The City shall reject every Bid that is not accompanied by a Bid deposit.

7. AWARD OF CONTRACT

The City shall award the contract to the lowest responsible (as defined in Elgin Municipal Code Chapter 5.04) and responsive (as defined in Elgin Municipal Code Chapter 5.04) Bidder within <u>90</u> days after the date of the opening of the Bids. If the successful Bidder fails to execute a contract in accordance with the terms of its Bid and to furnish all applicable bonds, an award shall be made to the next lowest

responsible and responsive Bidder. The time limit provided above shall not be applicable to a second or subsequent award.

Any Bidder who fails to execute a contract and furnish applicable bonds shall forfeit its Bid deposit which shall become the property of the City. The amount retained by the City shall not exceed the difference between the lowest Bid price and the Bid price of the next lowest responsible and eligible bidder.

The City shall notify the selected Bidder and all other Bidders of the award.

The City shall submit to the selected Bidder a Notice of Award and at least four (4) unsigned copies of the Agreement between the City and the Contractor. The Bidder shall return all executed copies of the Agreement, all bonds and insurance certificates to the City's Purchasing Director within 10 Business Days of the notice of the notice of award.

The selected bidder will be required to furnish a Performance and Payment Bond equal to one hundred percent (100%) of the total contract price in accordance with the provisions stated in the Information for Bidders.

The selected Bidder shall also provide a written substance abuse program that conforms with the requirements of Public Act 095-0635, or a copy of its union contract that establishes a drug/alcohol testing program, prior to the performance of the Work.

Failure of the selected Bidder to submit such documents in a timely fashion as provided above may result in the withdrawal of the award, at the City's discretion. The City shall return one executed copy of the Agreement to the Contractor. Time is of the essence in the performance of the Agreement.

ALL certified payroll must be submitted with an Application for Payment. All invoices go to City of Elgin Parks and Recreation Department, 100 Symphony Way, Elgin, IL 60120. All certified payroll should be submitted on a flash drive and mailed to City of Elgin Purchasing Department, 150 Dexter Court, Elgin, IL 60120 or emailed on a monthly basis to denye_d@cityofelgin.org.


8. COMPLETION TIME

The selected Bidder shall commence work not less than 10 days following receipt of a written "Notice to Proceed" and shall substantially complete the project within 15 Months from the date of the Notice to Proceed but not later than September 15, 2025. If any conflict exists between the date provided in the Agreement and these instructions, the Agreement shall prevail. Selected Bidder shall also pay as liquidated damages the sum of **\$1,000** for each calendar day thereafter that the work remains unfinished.


Selected Bidder agrees that such liquidated damages constitute a reasonable, good faith estimate of damages actually incurred by the City and do not constitute a penalty. Such aforementioned liquidated damages shall constitute the sole recourse for the City for violation of this paragraph.


DAINA L. DENYE PURCHASING DIRECTOR


END OF INFORMATION FOR AND INSTRUCTIONS TO BIDDERS

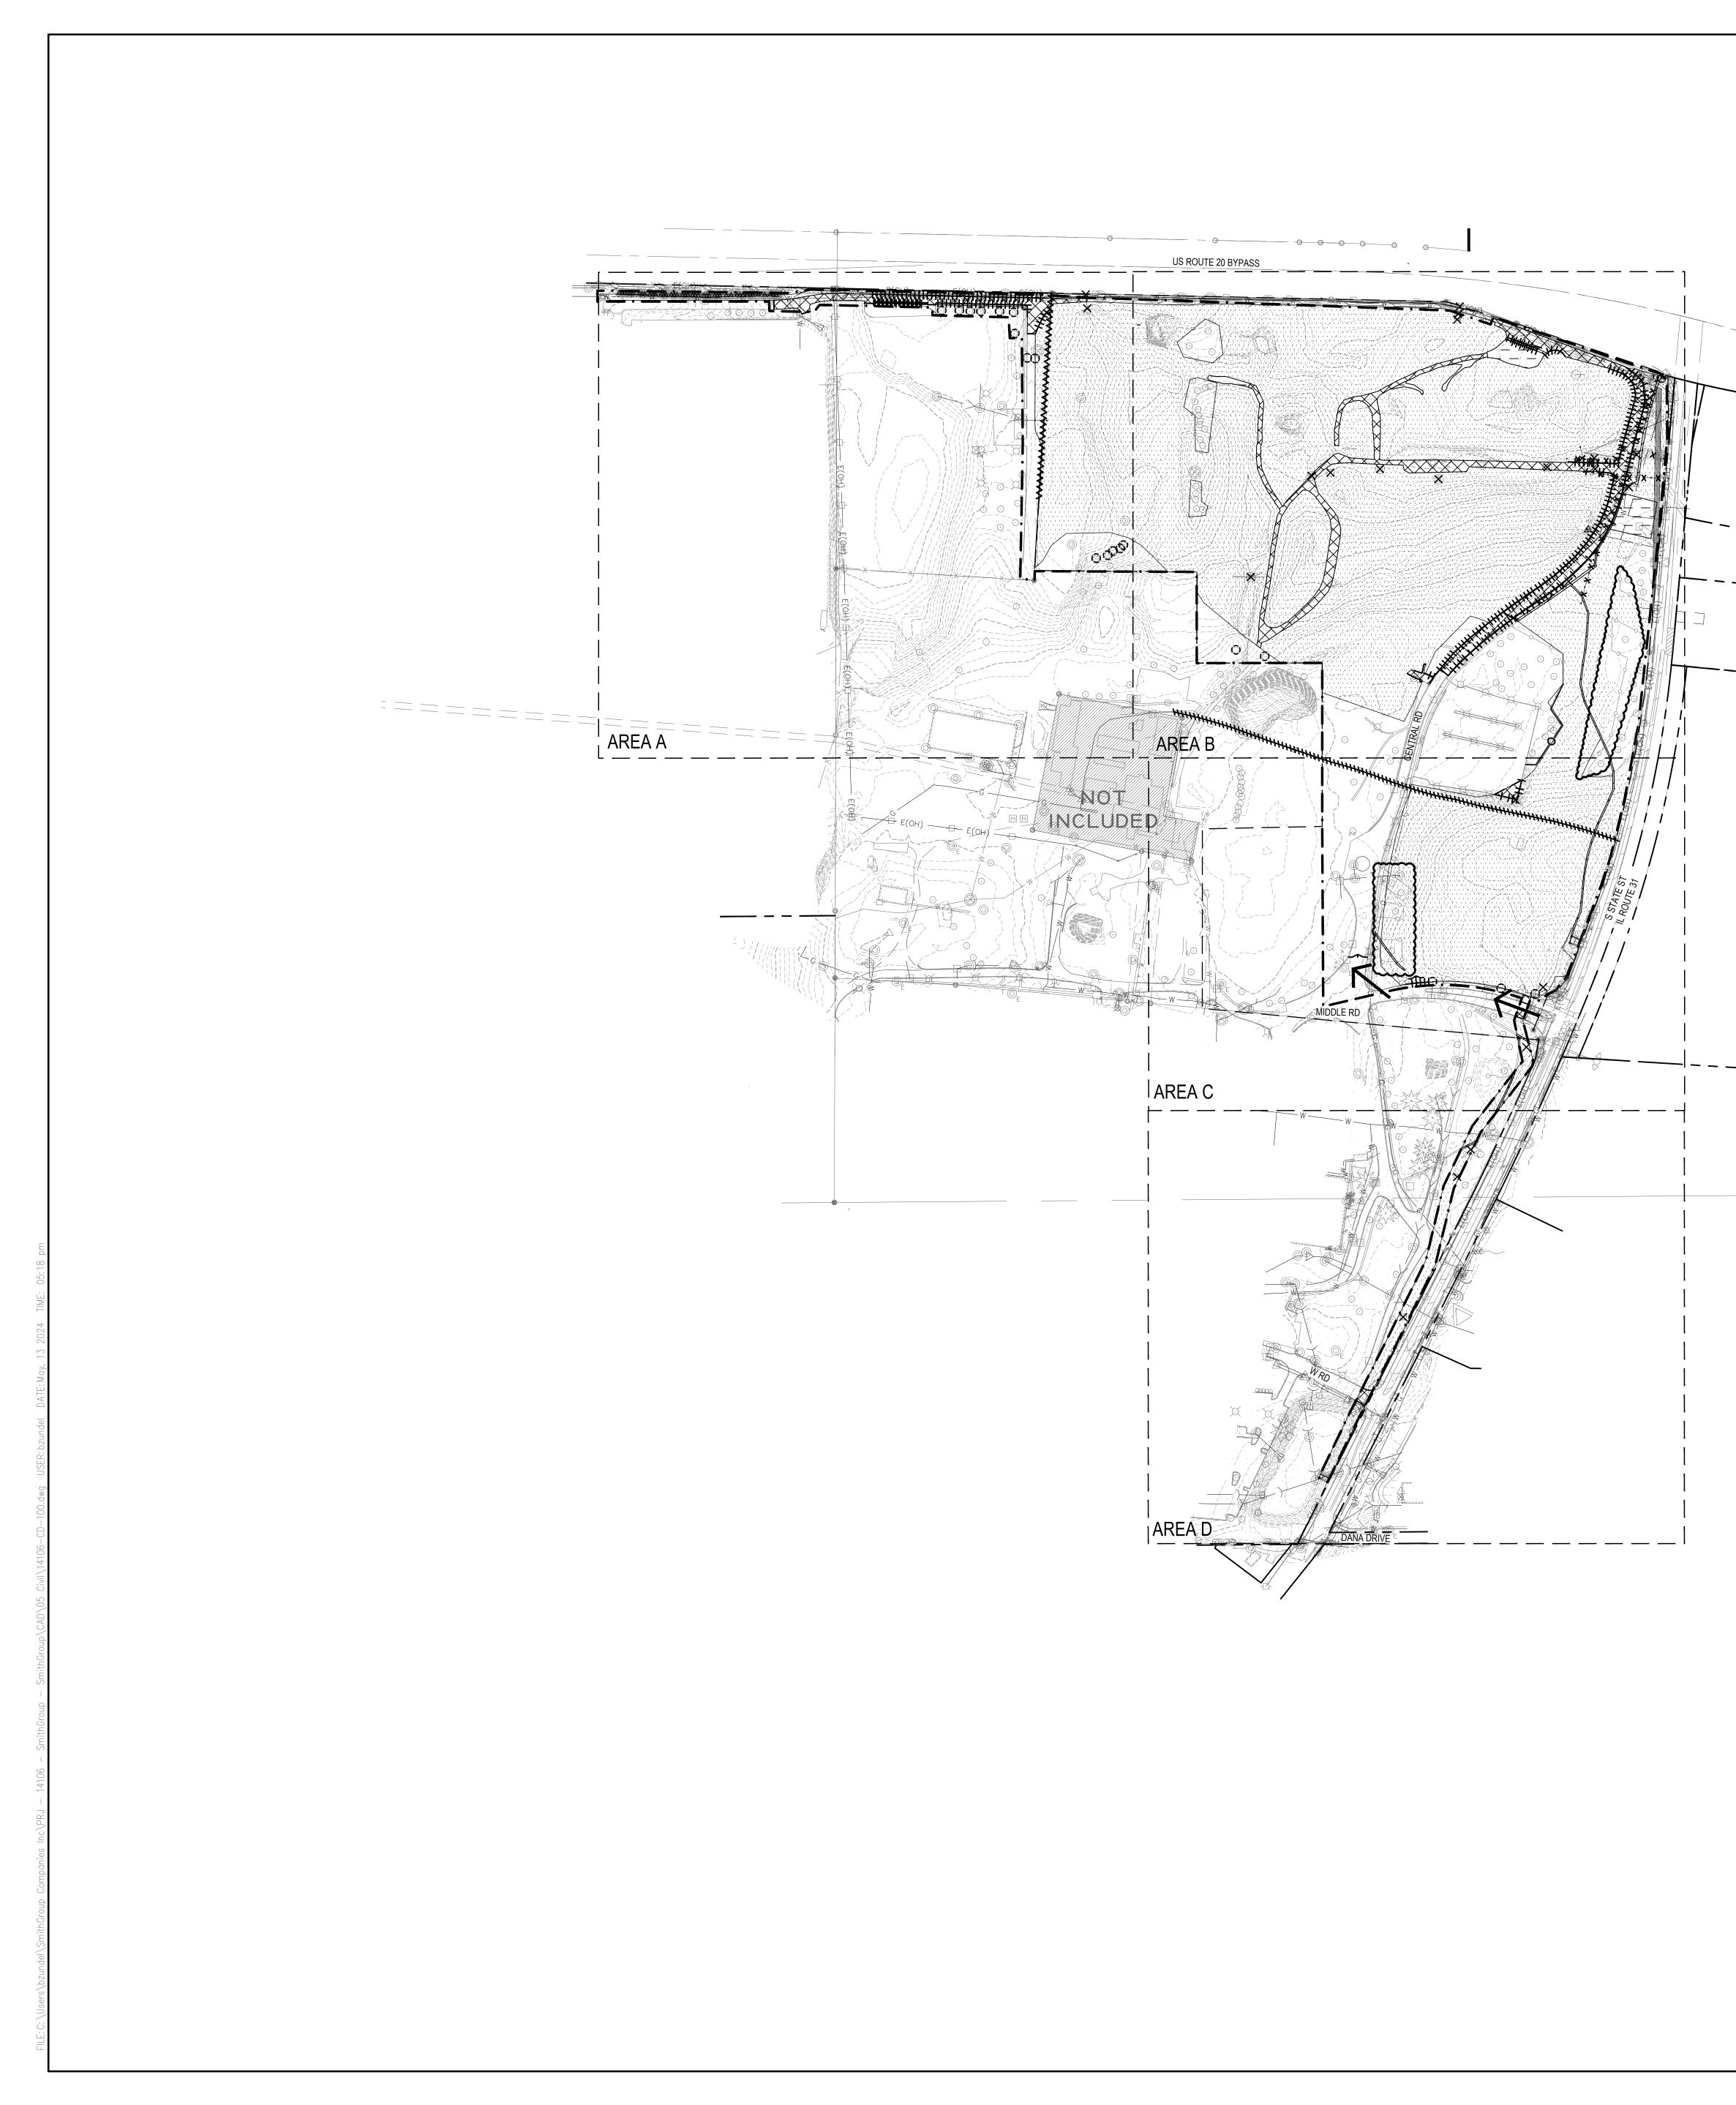

Ņ	
	SHEET NOTES SUBMIT PROJECT LOGISTICS PLAN, INDICATING CONSTRUCTION
	ACCESS AND AREAS OF DISTURBANCE. ALL STRUCTURES, UTILITIES, PAVEMENT AND TREES NOT DESIGNATED TO BE REMOVED SHALL BE PROTECTED DURING CONSTRUCTION. ANY DAMAGE CAUSED BY THE CONTRACTOR TO ITEMS AND STRUCTURES TO REMAIN SHALL BE REPAIRED AT NO COST TO THE OWNER.
	 ELECTRICAL PULL BOXES, ETC. SHALL BE ADJUSTED TO FINISH GRADE, UNLESS NOTED OTHERWISE. ALL MATERIAL TO BE REMOVED AND NOT INDICATED FOR SALVAGE, SHALL BECOME THE PROPERTY OF THE CONTRACTOR AND SHALL BE DISPOSED OFF SITE IN ACCORDANCE WITH ALL STATE, LOCAL AND FEDERAL GUIDELINES, UNLESS OTHERWISE NOTED. INSTALL MIN. 6' HEIGHT CONSTRUCTION FENCING WHERE INDICATED ON THE PLANS. MODIFY PLACEMENT OF FENCE WITH ENGINEER REPRESENTATIVE TO ACCOMMODATE PHASING OF
6	CONSTRUCTION, EMERGENCY ACCESS AND CONSTRUCTION INGRESS/EGRESS AS NECESSARY. CLEANLY SAWCUT PAVEMENT AT THE JOINT CLOSEST TO WHERE
	 INDICATED ON THE DRAWINGS TO THE FULL PAVEMENT DEPTH UNLESS OTHERWISE NOTED ON PLANS. HATCH PATTERNS SHOWING LIMITS OF REMOVALS ARE APPROXIMATE AND FOR REFERENCE PURPOSES ONLY. CONTRACTOR RESPONSIBLE FOR VERIFYING MATERIALS. PRIOR TO THE START OF DEMOLITION, THE CONTRACTOR SHALL MEET WITH THE OWNER'S REPRESENTATIVE TO REVIEW LIMITS OF REMOVALS, RESTORATION AND REPAIRS. CONTRACTOR MAY ADJUST CONSTRUCTION ACCESS ROUTES WITH APPROVAL FROM THE ENGINEER AND MAY REQUIRE NOTIFICATION TO DO IT.
TF	REE PROTECTION NOTES
1.	TREES TO REMAIN. PREVENT ANY DISTURBANCE OF EXISTING TREES. PROTECT EXISTING TREES TO REMAIN AGAINST UNNECESSARY CUTTING, BREAKING OR SKINNING OF ROOTS, BRUISING OF BARK, SMOTHERING TREES BY STOCKPILING EXCAVATION AND CONSTRUCTION MATERIALS OR PARKING VEHICLES WITHIN THE DRIP ANY DAMAGE BY CONTRACTOR TO EXISTING TREES TO REMAIN SHALL BE REPAIRED/REPLACED AT NO COST TO THE OWNER. TOXIC CHEMICALS, GASOLINE AND OTHER INJURIOUS SUBSTANCES SHALL NOT BE STORED OR ALLOWED TO SEEP, DRAIN OR EMPTY
3. 4. 5.	OR OTHER DEVICE OR MATERIAL SHALL BE SECURED OR FASTENED AROUND OR THROUGH A PROTECTED TREE. INSTALL TREE PROTECTION FOR ALL TREES TO REMAIN PER DETAIL 5/CE-500. MAINTAIN FENCED AREA FREE OF WEEDS AND TRASH.
	KEYED NOTES
2	A > REMOVE EXISTING LIGHT POLE AND FOOTINGS COMPLETE (25 QTY.).
X	 CONTRACTOR TO FIELD VERIFY QUANTITY. B REMOVE CONCRETE HEADWALL INCLUDING FOUNDATION TO MINIMUM OF 36" BELOW PROPOSED GRADE.
	 C EXISTING TREES TO BE TRANSPLANTED, REFER TO LANDSCAPE. D GAS SERVICE TO ELGIN HEALTH CENTER POWER PLANT TO BE DECOMMISSIONED BY UTILITY PROVIDER UNDER SEPARATE CONTRACT. DECOMMISIONING IS ANTICIPATED TO BE COMPLETED BY JUNE 2024. COORDINATE AND SCHEDULE CONSTRUCTION ACTIVITIES WITH UTILITY PROVIDER AND OWNER'S REPRESENTATIVE.
	E > EXISTING LOT TO REMAIN FOR CONTINUED ELGIN USE F > SEE TREE PROTECTION NOTES, THIS SHEET.
8	G EXISTING TREE PRESERVATION FENCE AND TREES TO PROTECT
	PROPERTY LINE PROPERTY LINE SETBACK LINE LIMITS OF CONSTRUCTION ASPHALT PAVEMENT REMOVAL CONCRETE PAVEMENT REMOVAL GRAVEL REMOVAL GRAVEL REMOVAL CLEAR AND GRUB PAVEMENT SAWCUT INITIAL CURB REMOVAL CURB REMOVAL FENCE REMOVAL EXISTING TREE PROTECTION FENCE K
	 X · X · X · X · VIILITY REMOVAL CAP UTILITY CONSTRUCTION FENCE CONSTRUCTION ENTRANCE JERSEY BARRIER UTILITY ABANDON
	RELOCATE

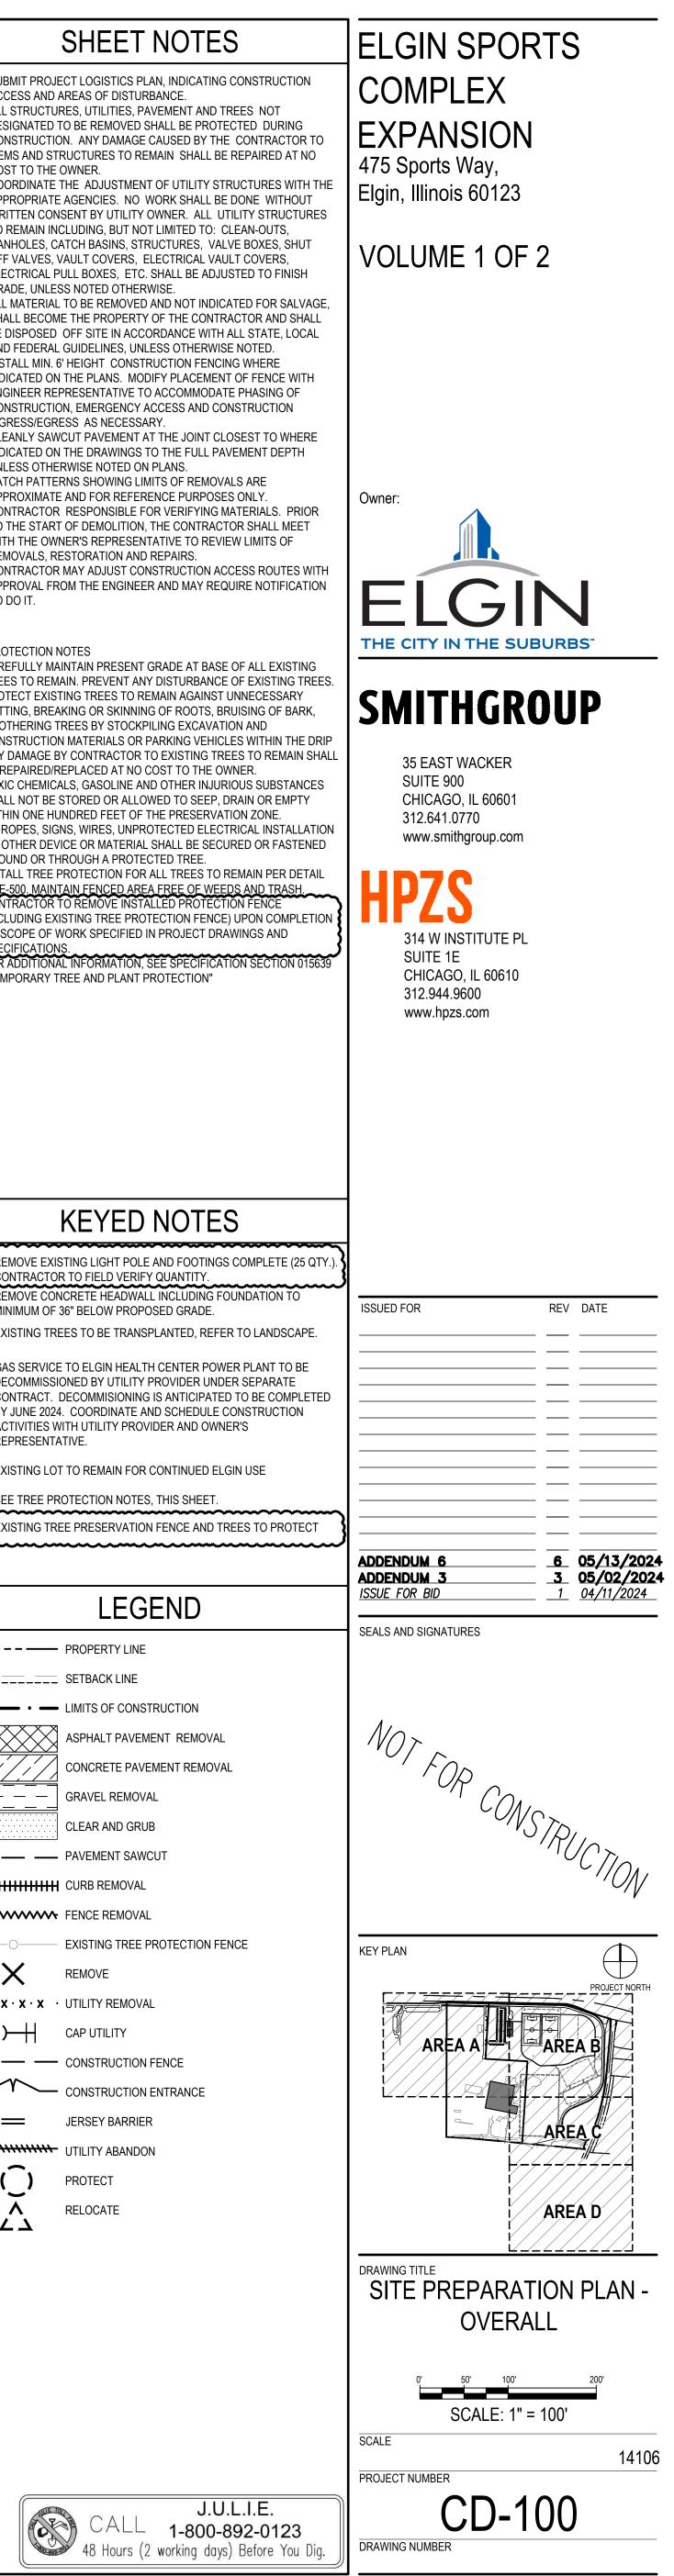

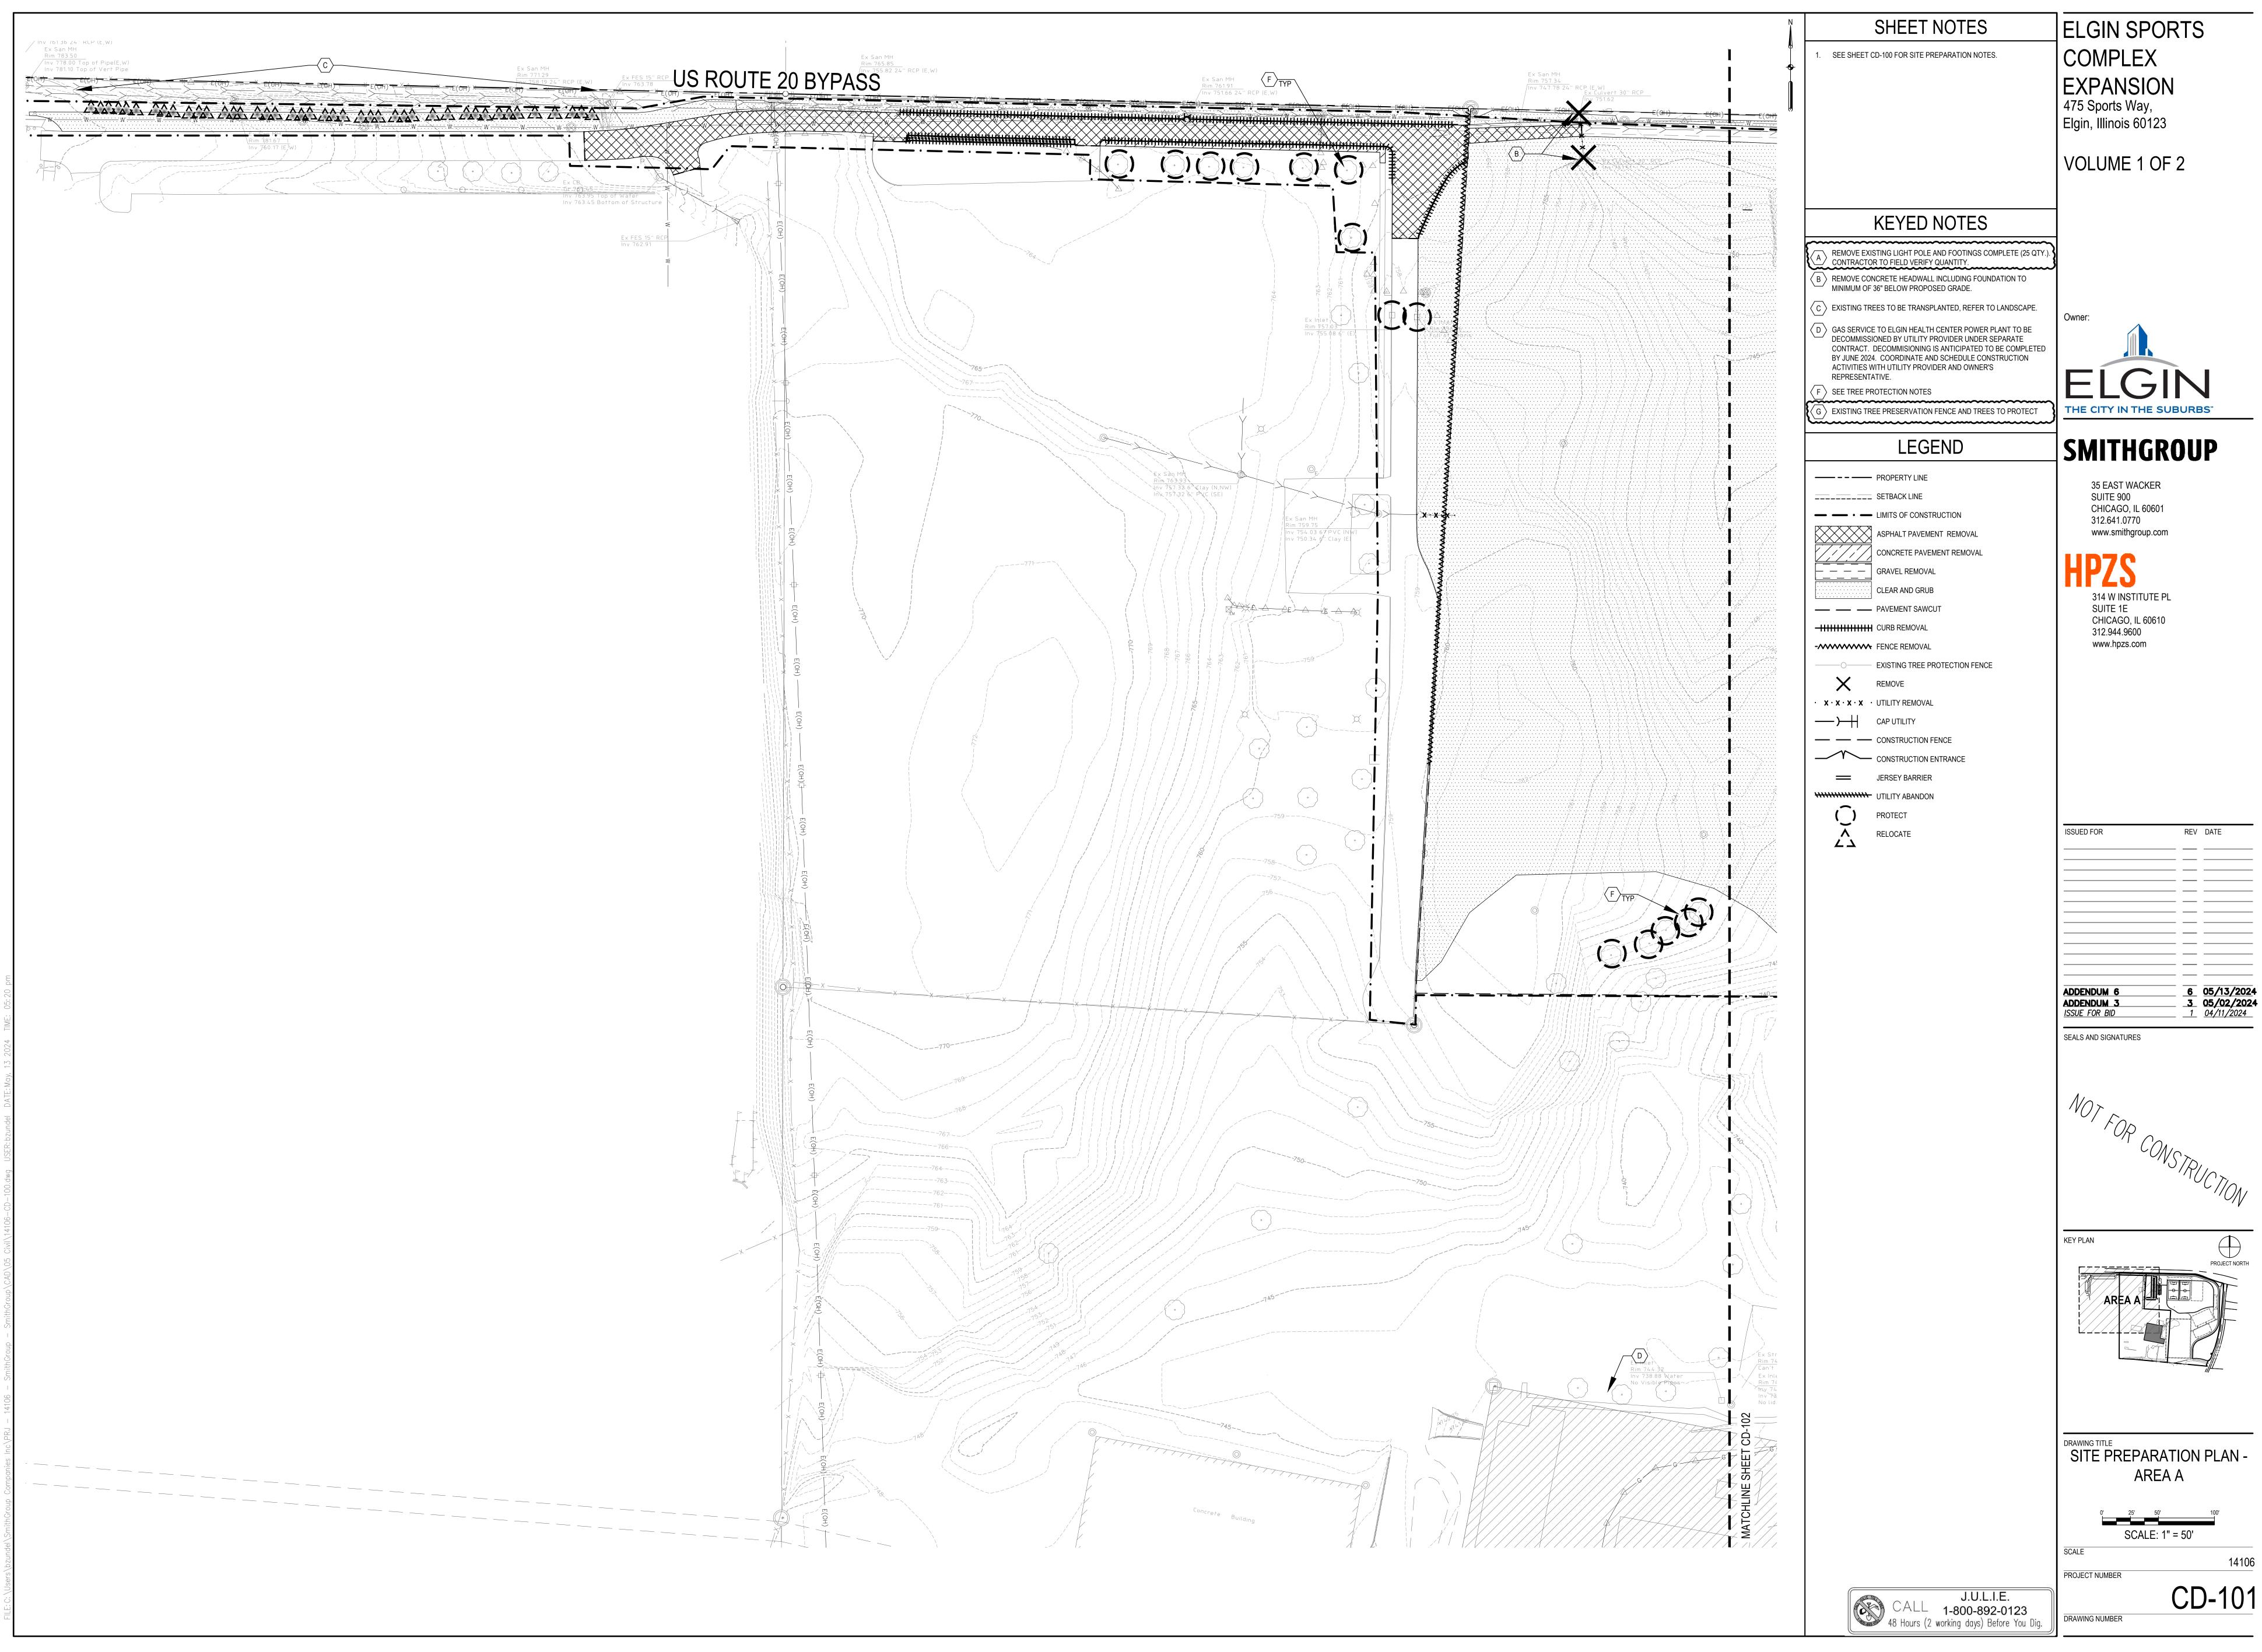

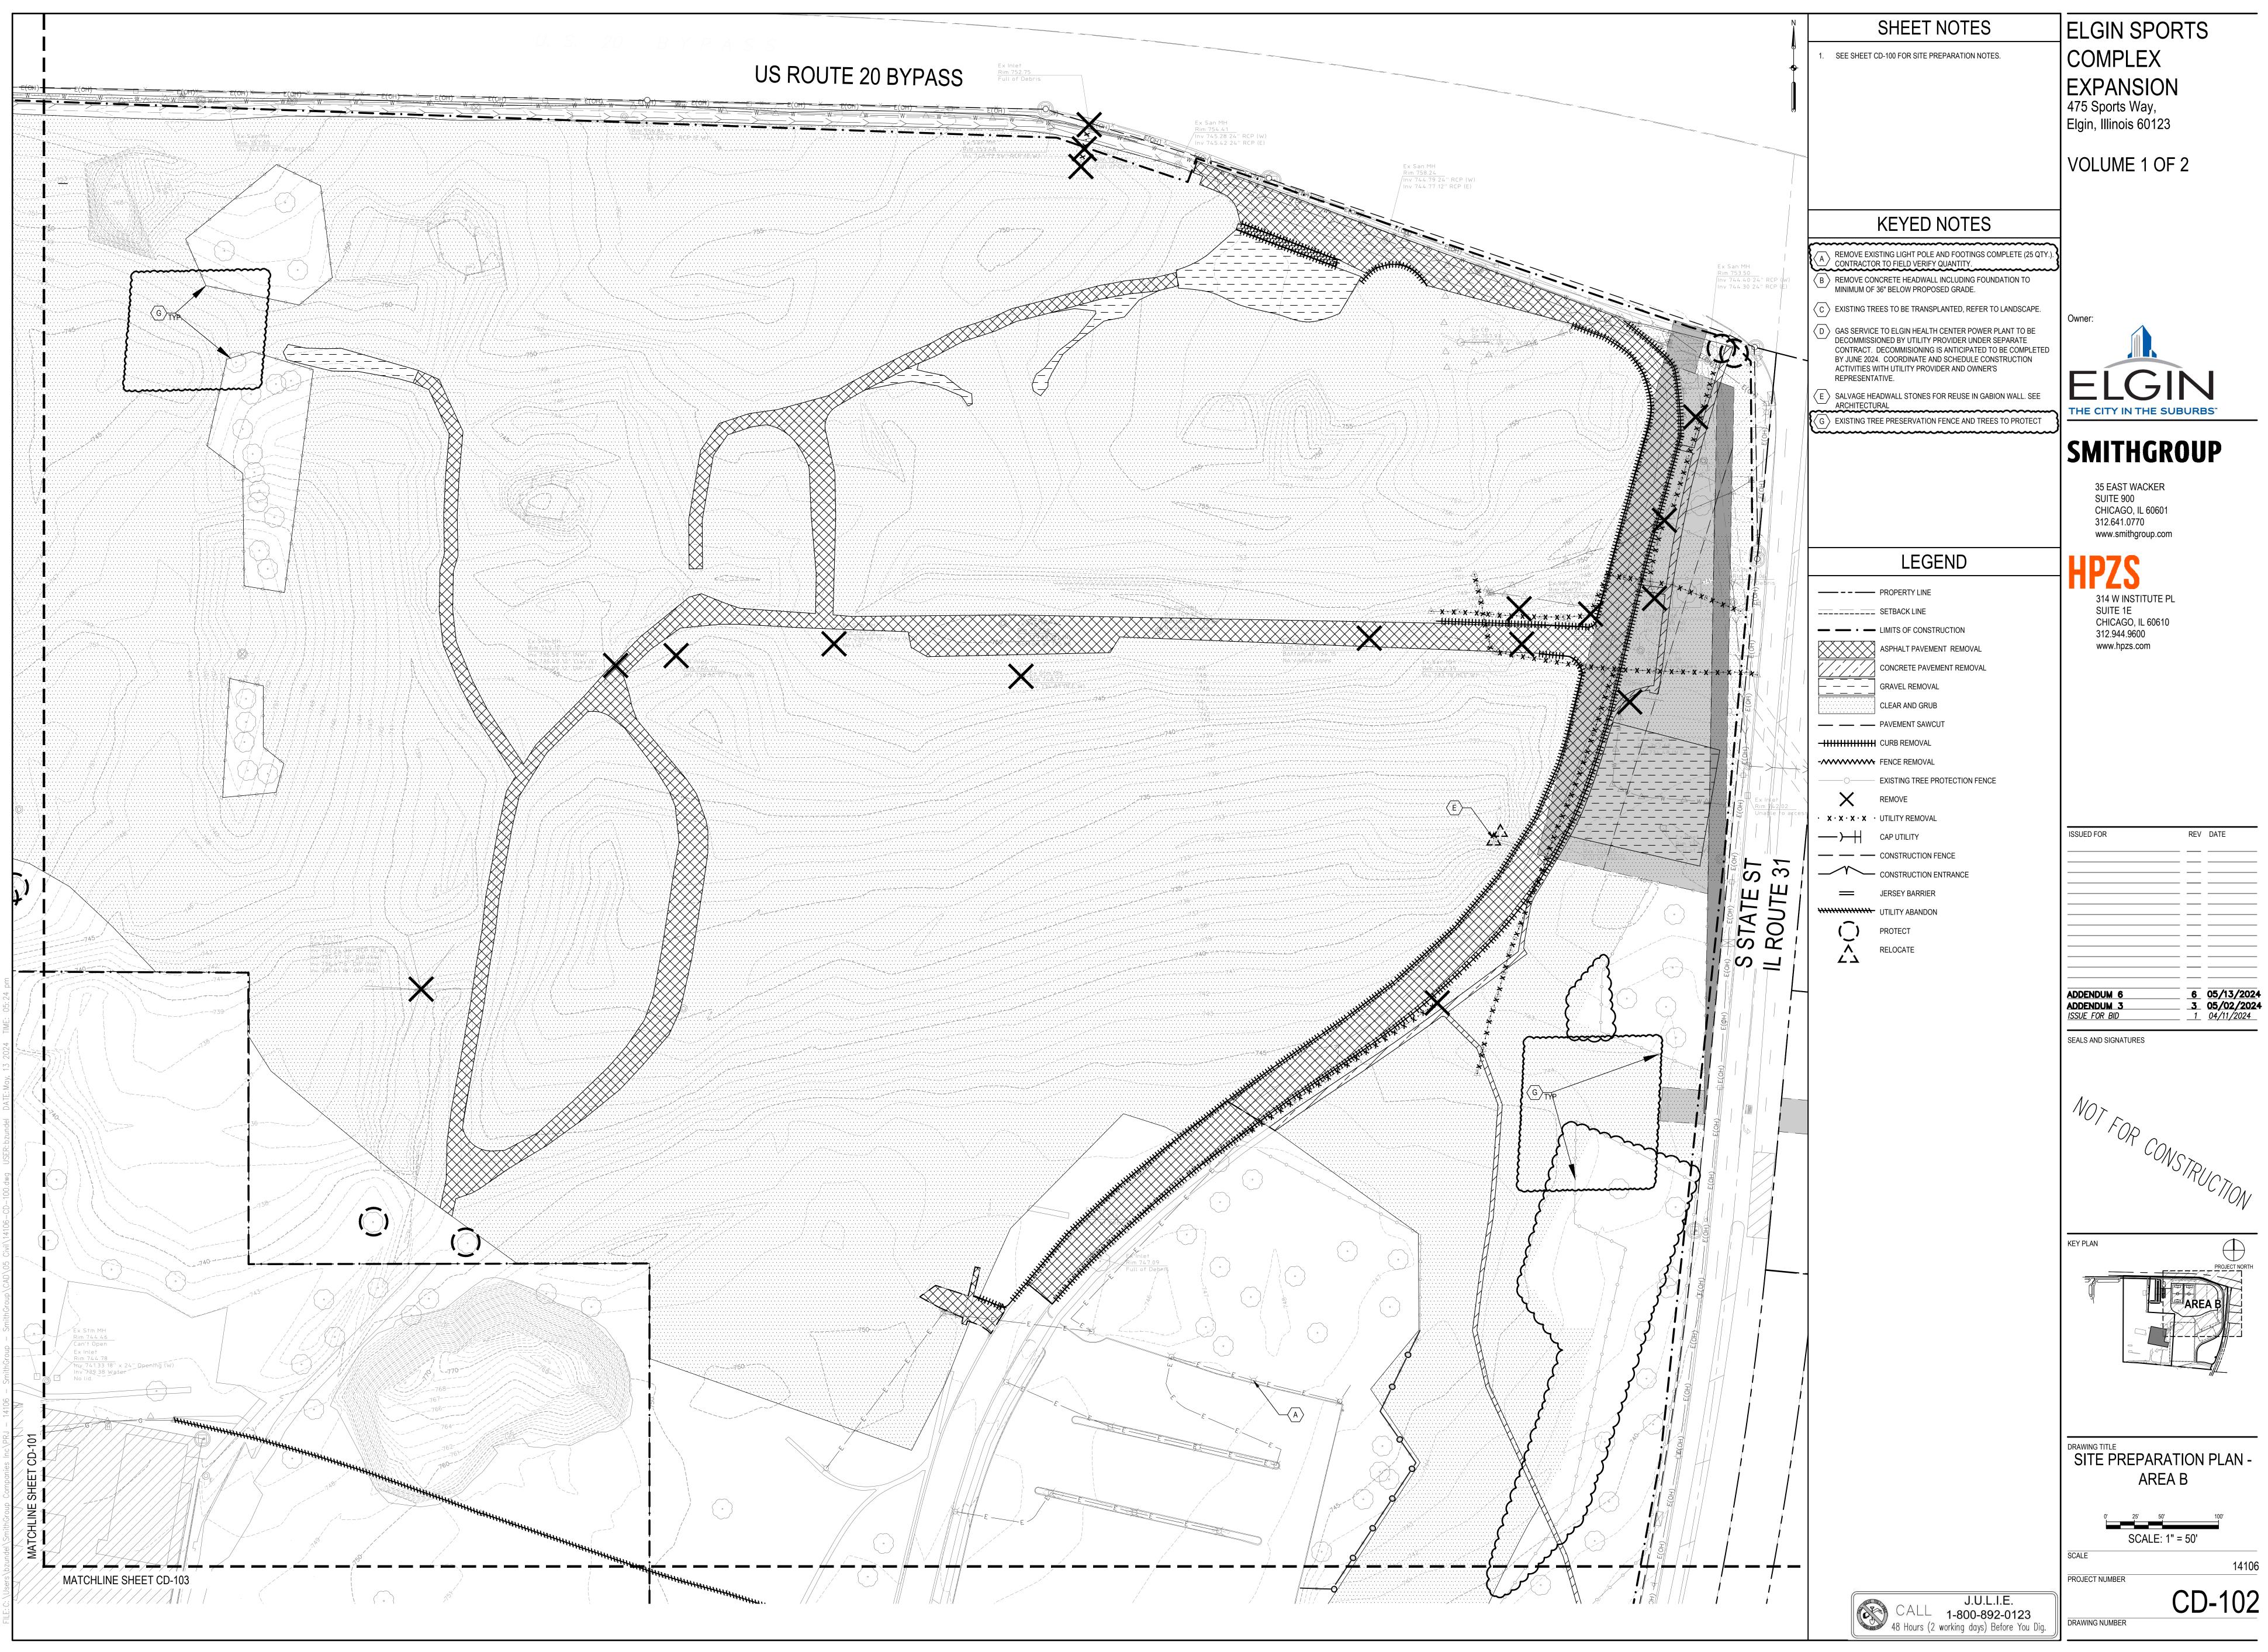





SHEET NOTES
1. SEE SHEET CD-100 FOR SITE PREPARATION NOTES.
KEYED NOTES
A REMOVE EXISTING LIGHT POLE AND FOOTINGS COMPLETE (25 CONTRACTOR TO FIELD VERIFY QUANTITY.
B REMOVE CONCRETE HEADWALL INCLUDING FOUNDATION TO MINIMUM OF 36" BELOW PROPOSED GRADE.
$\langle C \rangle$ EXISTING TREES TO BE TRANSPLANTED, REFER TO LANDSCA
D GAS SERVICE TO ELGIN HEALTH CENTER POWER PLANT TO B DECOMMISSIONED BY UTILITY PROVIDER UNDER SEPARATE
CONTRACT. DECOMMISIONING IS ANTICIPATED TO BE COMPL BY JUNE 2024. COORDINATE AND SCHEDULE CONSTRUCTION
ACTIVITIES WITH UTILITY PROVIDER AND OWNER'S REPRESENTATIVE.
$\langle \mathbf{G} \rangle$ EXISTING TREE PRESERVATION FENCE AND TREES TO PROTE
LEGEND

	PROPERTY LINE
	SETBACK LINE
— — · —	LIMITS OF CONSTRUCTION
	ASPHALT PAVEMENT REMOVAL
	CONCRETE PAVEMENT REMOVAL
	GRAVEL REMOVAL
	CLEAR AND GRUB
	PAVEMENT SAWCUT
	CURB REMOVAL
	FENCE REMOVAL
O	EXISTING TREE PROTECTION FENCE
X	REMOVE
$\cdot \mathbf{x} \cdot \mathbf{x} \cdot \mathbf{x} \cdot \mathbf{x} \cdot \mathbf{x}$	UTILITY REMOVAL
—) –+	CAP UTILITY
	CONSTRUCTION FENCE
	CONSTRUCTION ENTRANCE
—	JERSEY BARRIER
·····	UTILITY ABANDON
(_)	PROTECT
$\overline{\wedge}$	RELOCATE



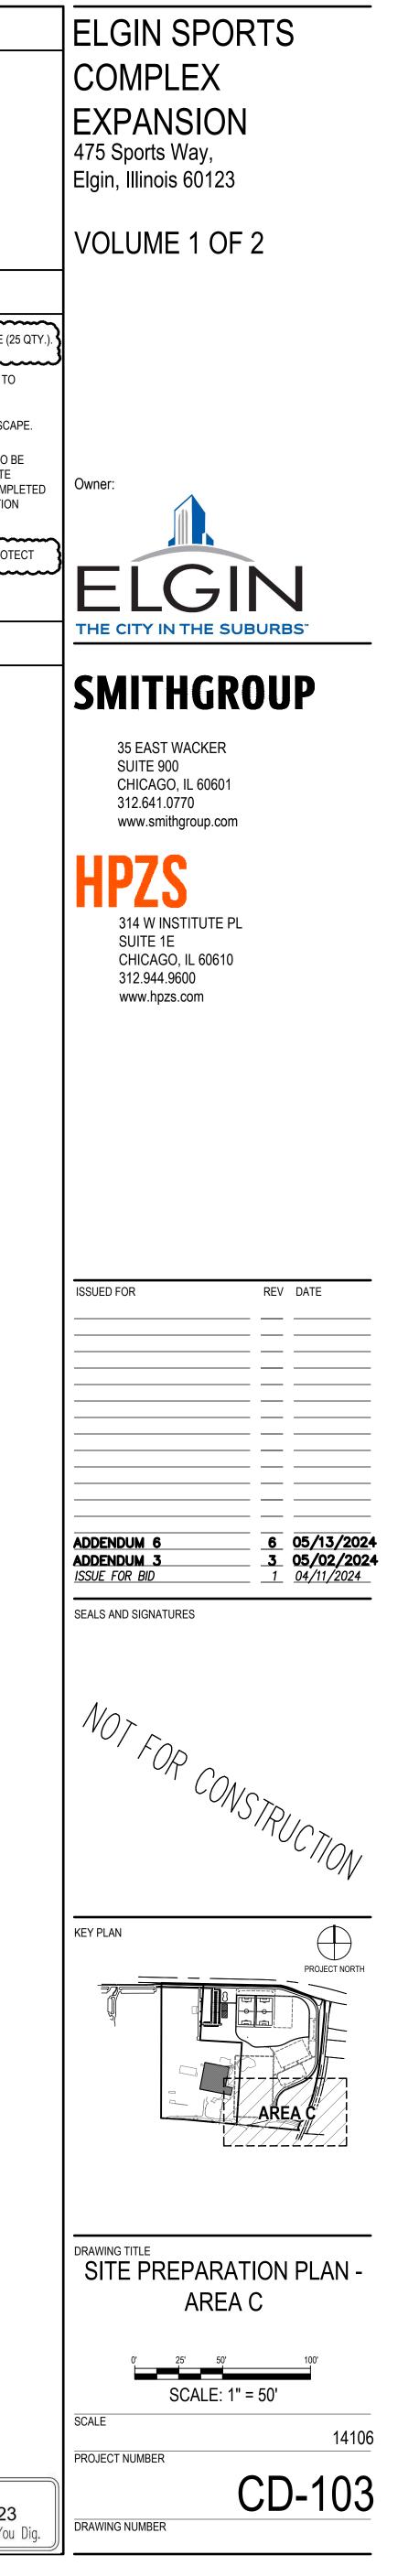

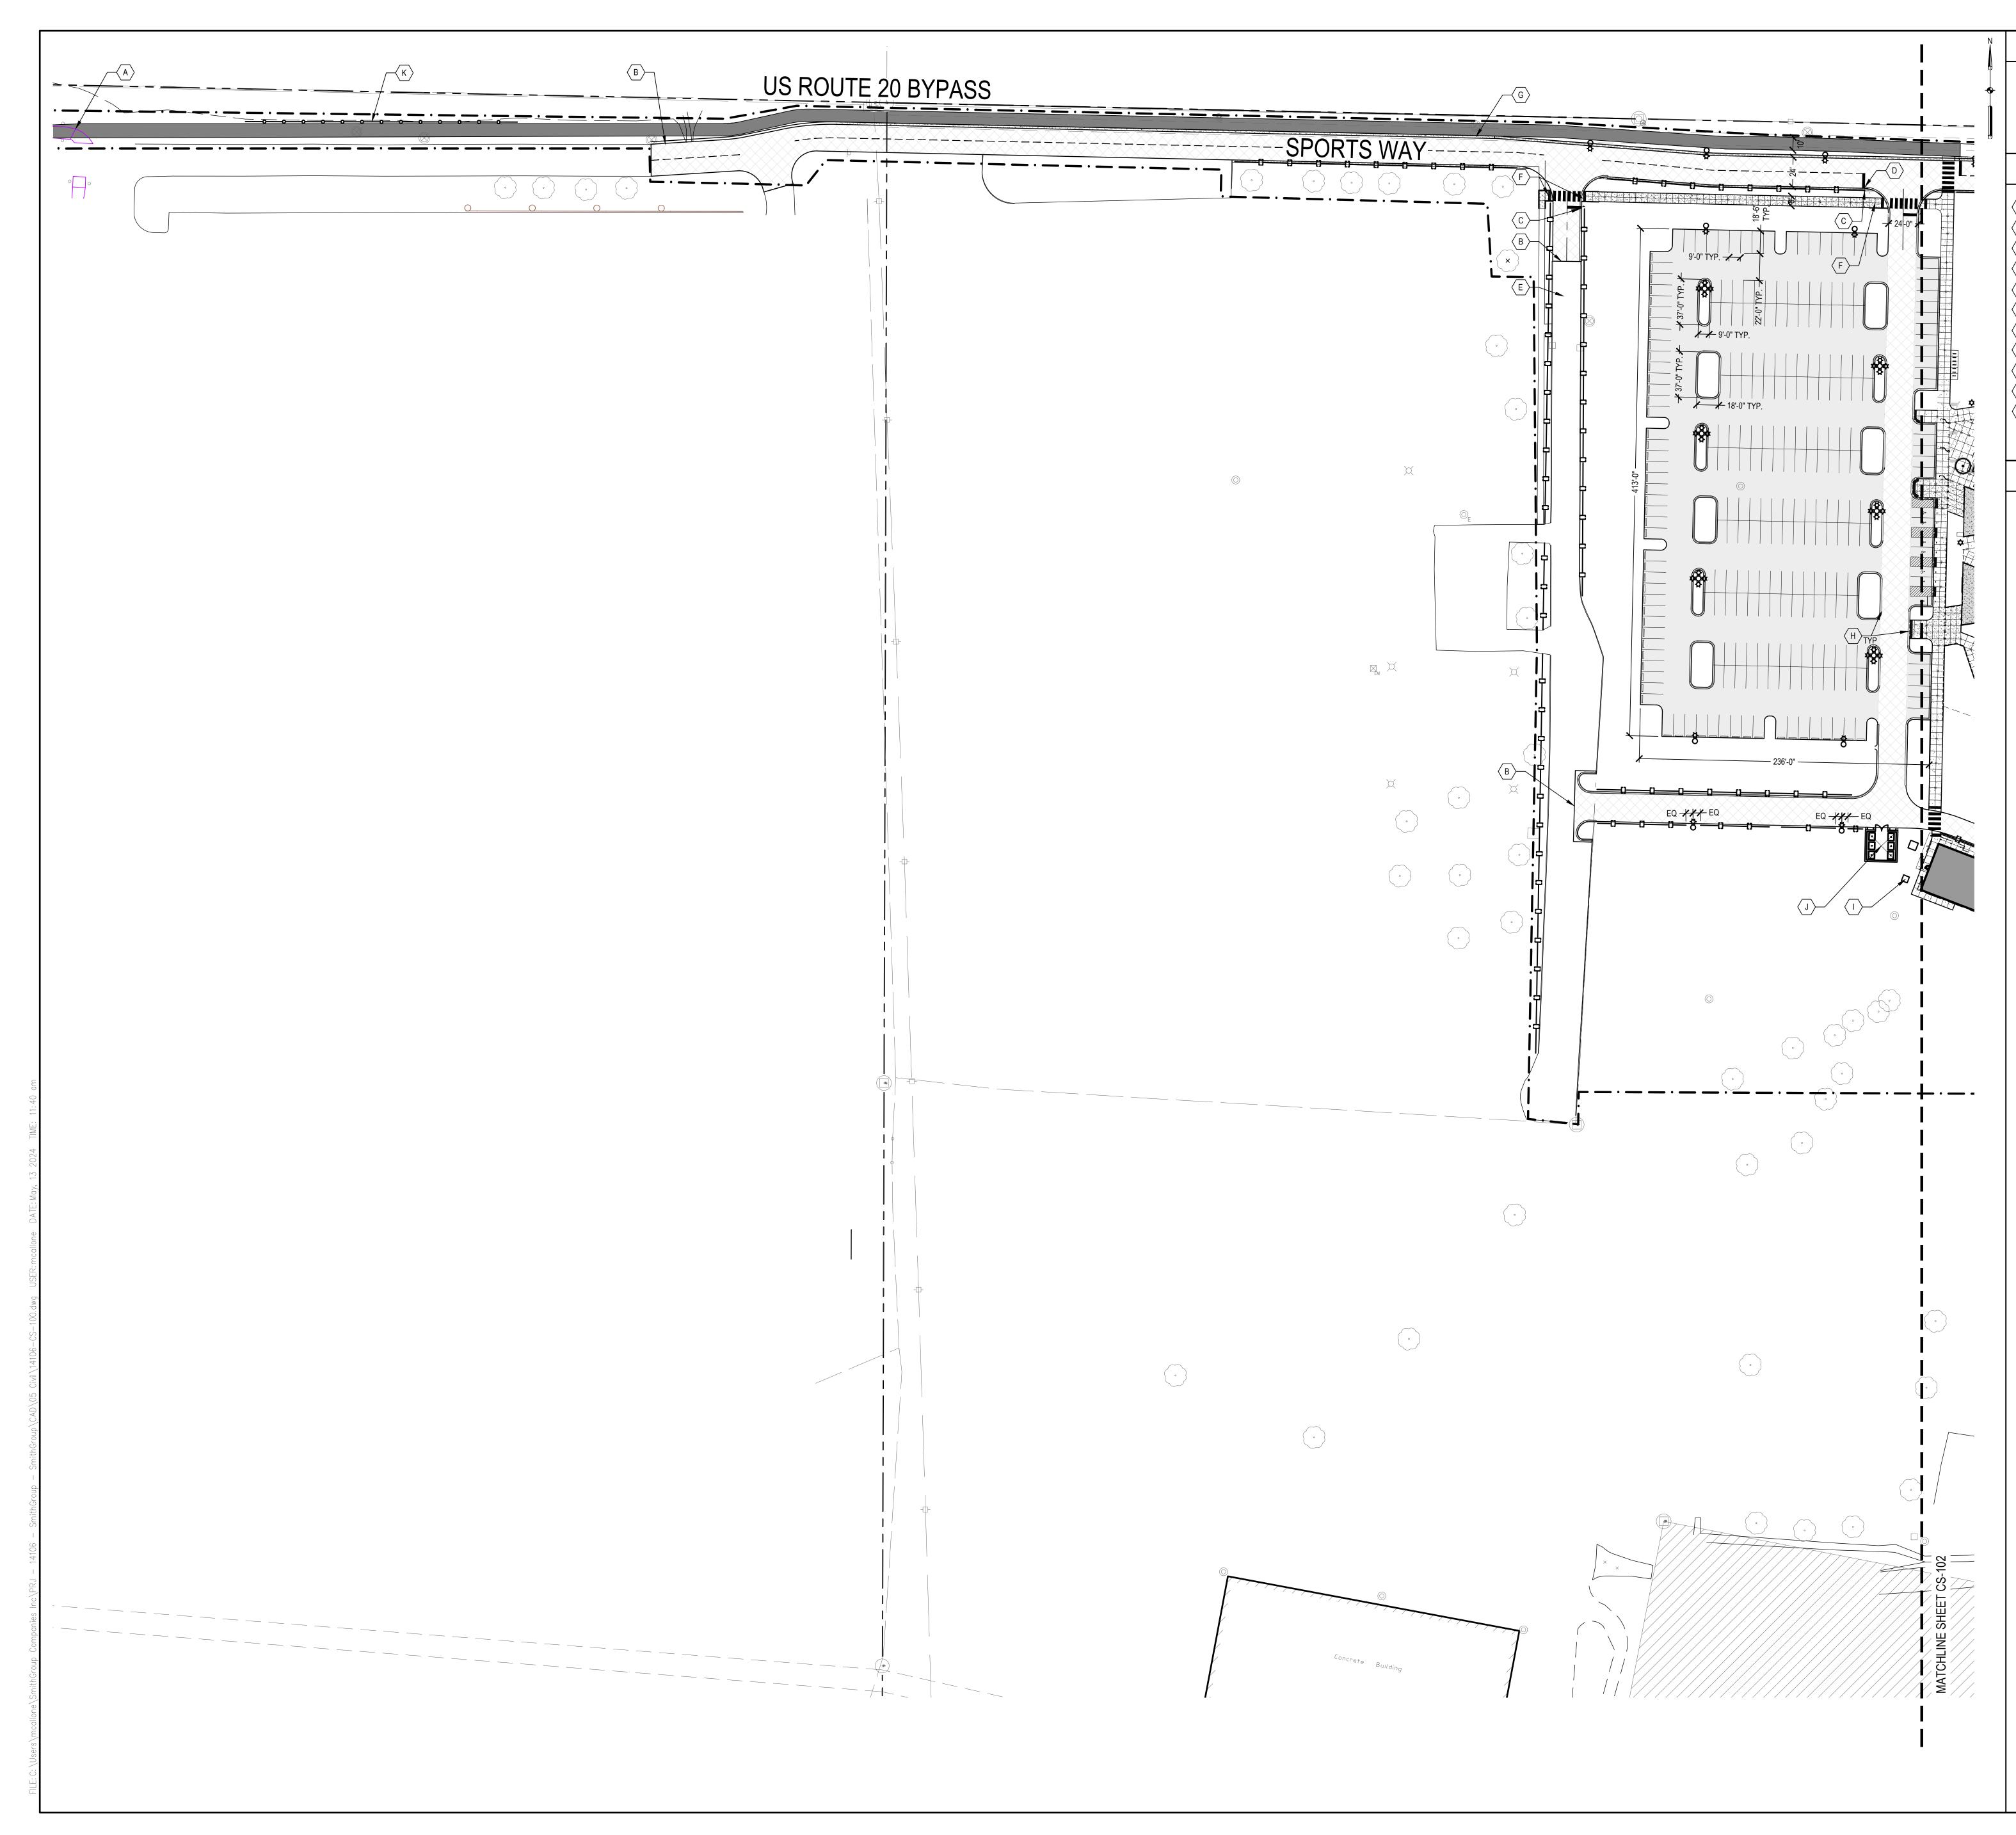


KEYED NOTES $\langle A \rangle$ PROPOSED BIKE PATH CONNECTS TO EXISTING $\langle B \rangle$ ROAD IMPROVEMENTS CONNECT TO EXISTING ROAD \bigcirc STOP BAR AND STOP SIGN $\bigcirc 2$ CS-507 D END OF STANDARD CURB AND GUTTER $\langle E \rangle$ EXISTING ROAD TO REMAIN $\langle F \rangle$ ADA RAMP - TYPE A $\begin{pmatrix} 14 \\ CS-500 \end{pmatrix}$ G BICYCLE BARRIER CURB (17 (CS-500) $\langle H \rangle$ FIRE LANE MARKING, PAINTED RED, TYP TRANSFORMER PADS, SEE ELECTRICAL $\langle J \rangle$ TRASH ENCLOSURE $\begin{pmatrix} 1,2,3\\ CS-508 \end{pmatrix}$ K BICYCLE GUARDRAIL 6 CS-504 LEGEND


SHEET NOTES

SEE SHEET CS-100 FOR LAYOUT AND MATERIALS NOTES.

	PROPERTY LINE
	EASEMENT
	LIMIT OF CONSTRUCTION
	MEDIUM DUTY ASPHALT PAVMENT
	LIGHT DUTY ASPHALT PAVEMENT
	CITY OF ELGIN PAVEMENT STANDARD
	HEAVY DUTY INTEGRAL COLORED 6 CONCRETE PAVEMENT
	HEAVY DUTY CONCRETE PAVEMENT
* *	CONCRETE PAVEMENT
	GRAVEL SHOULDER
	ADA TACTILE WARNING
	CONTROL JOINT (CS-500)
	ISOLATION (EXPANSION) JOINT
	CONCRETE TURNDOWN
	STANDARD CURB AND GUTTER
	RETAINING WALL
 oo	
xx	
	POST AND CHAIN (5) (CS-504)
 O O	GUARDRAIL $\begin{pmatrix} 4 \\ CS-504 \end{pmatrix} \begin{pmatrix} 6 \\ CS-504 \end{pmatrix}$
	6FT MASONRY DUMPSTER ENCLOSURE
	WOOD BENCH ON CONCRETE PAD WITH PLINT
\sim	FLAGPOLES (CS-506)
¢0	ROADWAY LIGHT POLE (SEE ELECTRICAL)
4 0 0 0	PARKING LOT LIGHT POLE (SEE ELECTRICAL)
\$	SPORTS FIELD LIGHT POLE (SEE ELECTRICAL)
¢	LIGHT POLE (SEE ELECTRICAL)
Ø	REMOVABLE BOLLARDS, TYP. (3) (CS-506)
Ø	BOLLARDS, TYP. (4) CS-506



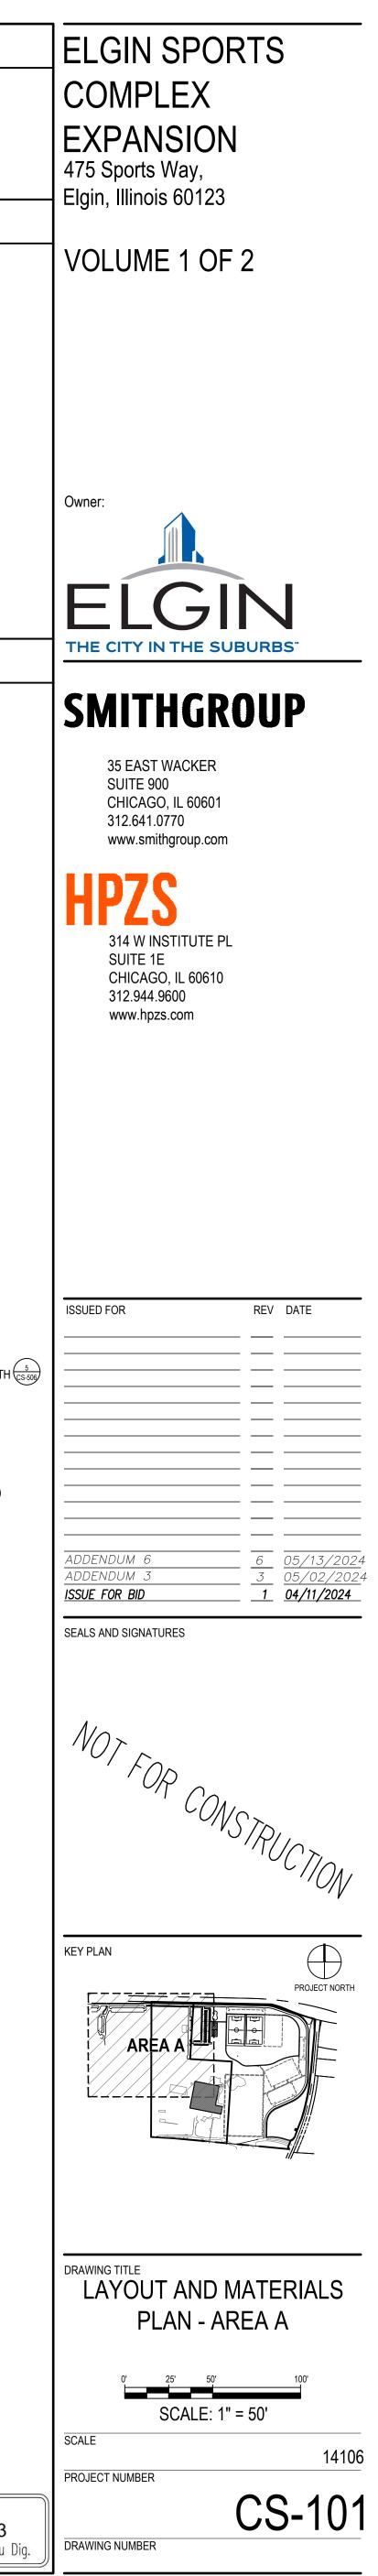


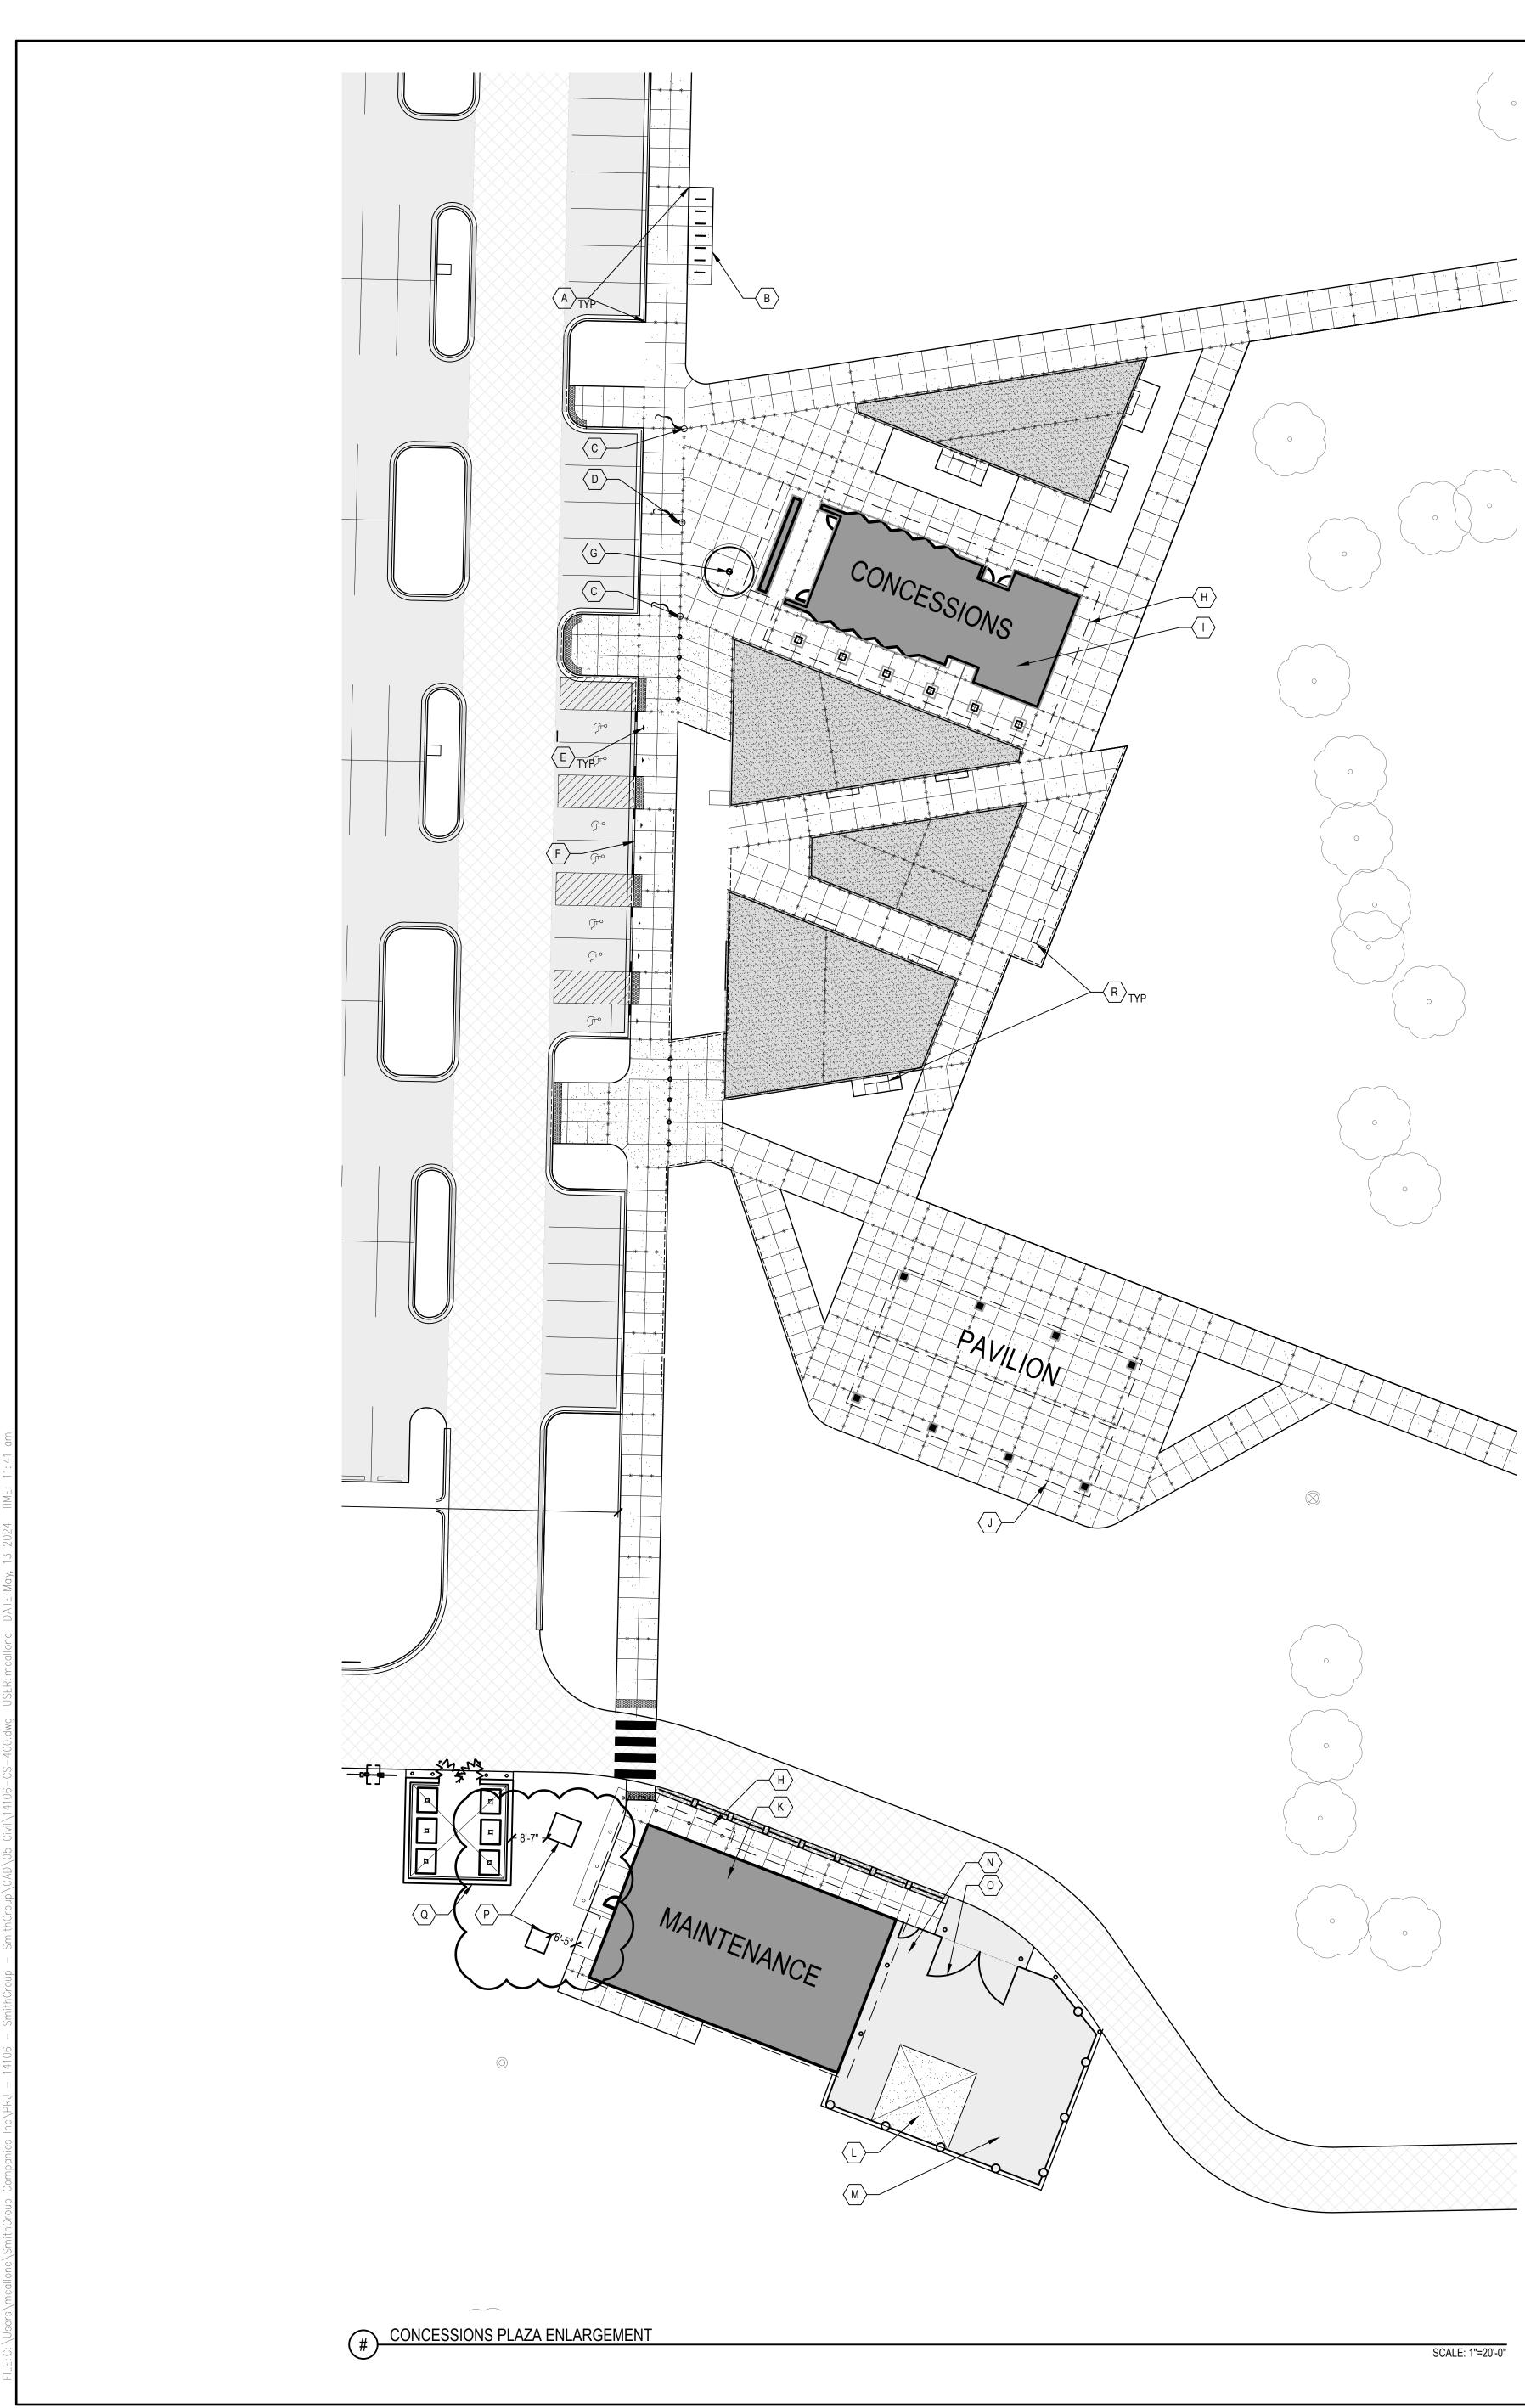


SHEET NOTES
1. SEE SHEET CS-100 FOR LAYOUT AND MATERIALS NOTES.
KEYED NOTES
A ALIGN JOINT, TYP
$\left< C \right>$ FLAGPOLE - 25' HEIGHT $\left(\frac{7}{CS-506} \right)$
D FLAGPOLE - 35' HEIGHT
E ADA PARKING SIGNS
F ADA BARRIER CURB
G ABOVEGROUND RAINWATER COLLECTION CISTERN FOR IRRIG
H BUILDING ROOF OVERHEAD
$\langle I \rangle$ PROPOSED CONCESSIONS BUILDING, SEE ARCHITECTURAL SI
J PROPOSED SHELTER PAVILLION $6 \\ CS-506$
$\langle K \rangle$ PROPOSED MAINTENANCE BUILDING, SEE ARCHITECTURAL SE
L WASH DOWN AREA WITH HEAVY DUTY CONCRETE PAVEMENT
M PROPOSED MAINTENANCE YARD
$\langle N \rangle$ SINGLE LEAF 4 FOOT PEDESTRIAN GATE WITH PANIC EXIT
O DOUBLE SWING GATE WITH 10 FOOT LEAFS (VEHICULAR)
P TRANSFORMER, SEE ELECTRICAL PLANS
$\langle Q \rangle$ TRASH ENCLOSURE, SEE SITE DETAILS SHEET CS-508
$\left< \frac{1}{R} \right>$ WOOD BENCH $\left(\frac{5}{CS-506} \right)$

LEGEND

	PROPERTY LINE
= = =	EASEMENT
	LIMIT OF CONSTRUCTION
	MEDIUM DUTY ASPHALT PAVMENT
	LIGHT DUTY ASPHALT PAVEMENT
	CITY OF ELGIN PAVEMENT STANDARD
	HEAVY DUTY INTEGRAL COLORED
	HEAVY DUTY CONCRETE PAVEMENT
* *	CONCRETE PAVEMENT
	GRAVEL SHOULDER
	ADA TACTILE WARNING
	CONTROL JOINT
	ISOLATION (EXPANSION) JOINT
	STANDARD CURB AND GUTTER
======	RETAINING WALL
│	
xx	
	POST AND CHAIN (5) CS-504
·····	$GUARDRAIL \stackrel{4}{\underset{(S-504)}{(S-504)}} \stackrel{6}{\underset{(S-504)}{(S-504)}}$
	6FT MASONRY DUMPSTER ENCLOSURE
	WOOD BENCH ON CONCRETE PAD WITH PLINTH
\sim	FLAGPOLES (7 CS-506
\$ 0	ROADWAY LIGHT POLE (SEE ELECTRICAL)
	PARKING LOT LIGHT POLE (SEE ELECTRICAL)
	SPORTS FIELD LIGHT POLE (SEE ELECTRICAL)
\$	LIGHT POLE (SEE ELECTRICAL)
Ø	REMOVABLE BOLLARDS, TYP.
Ø	BOLLARDS, TYP. 4 CS-506

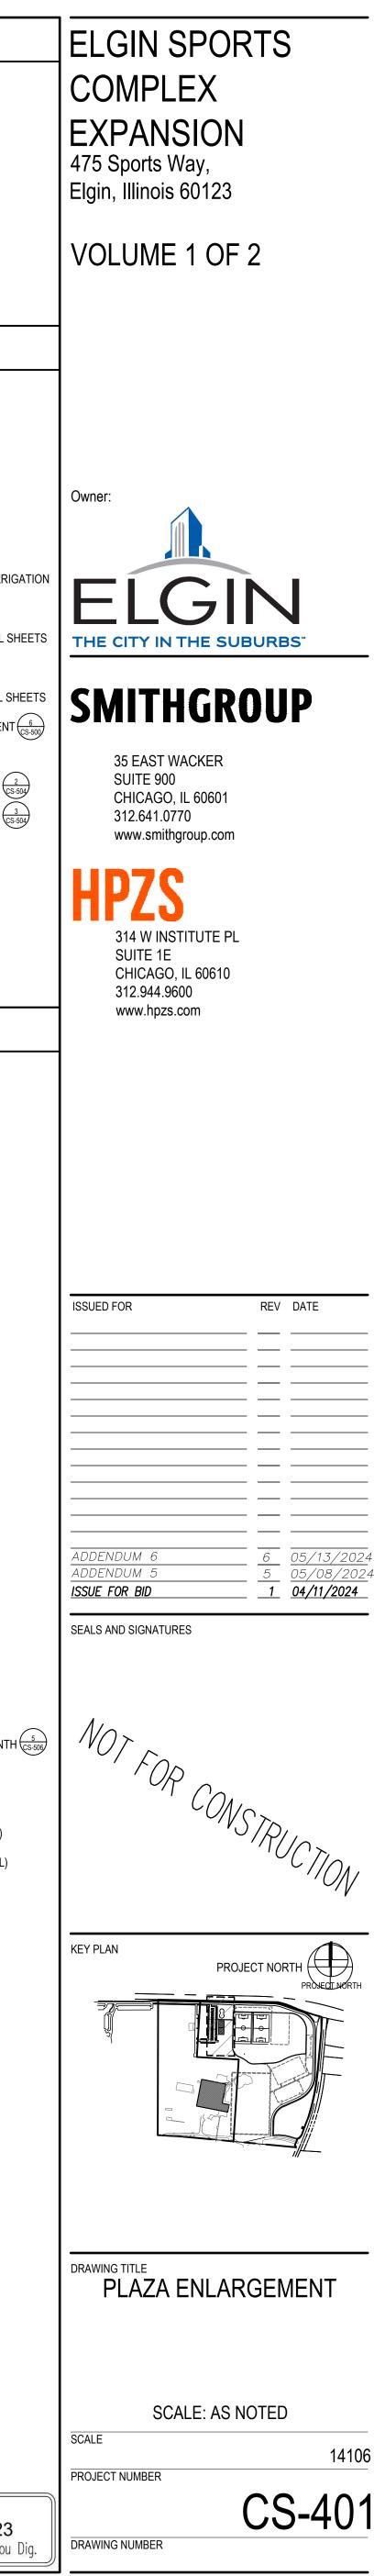

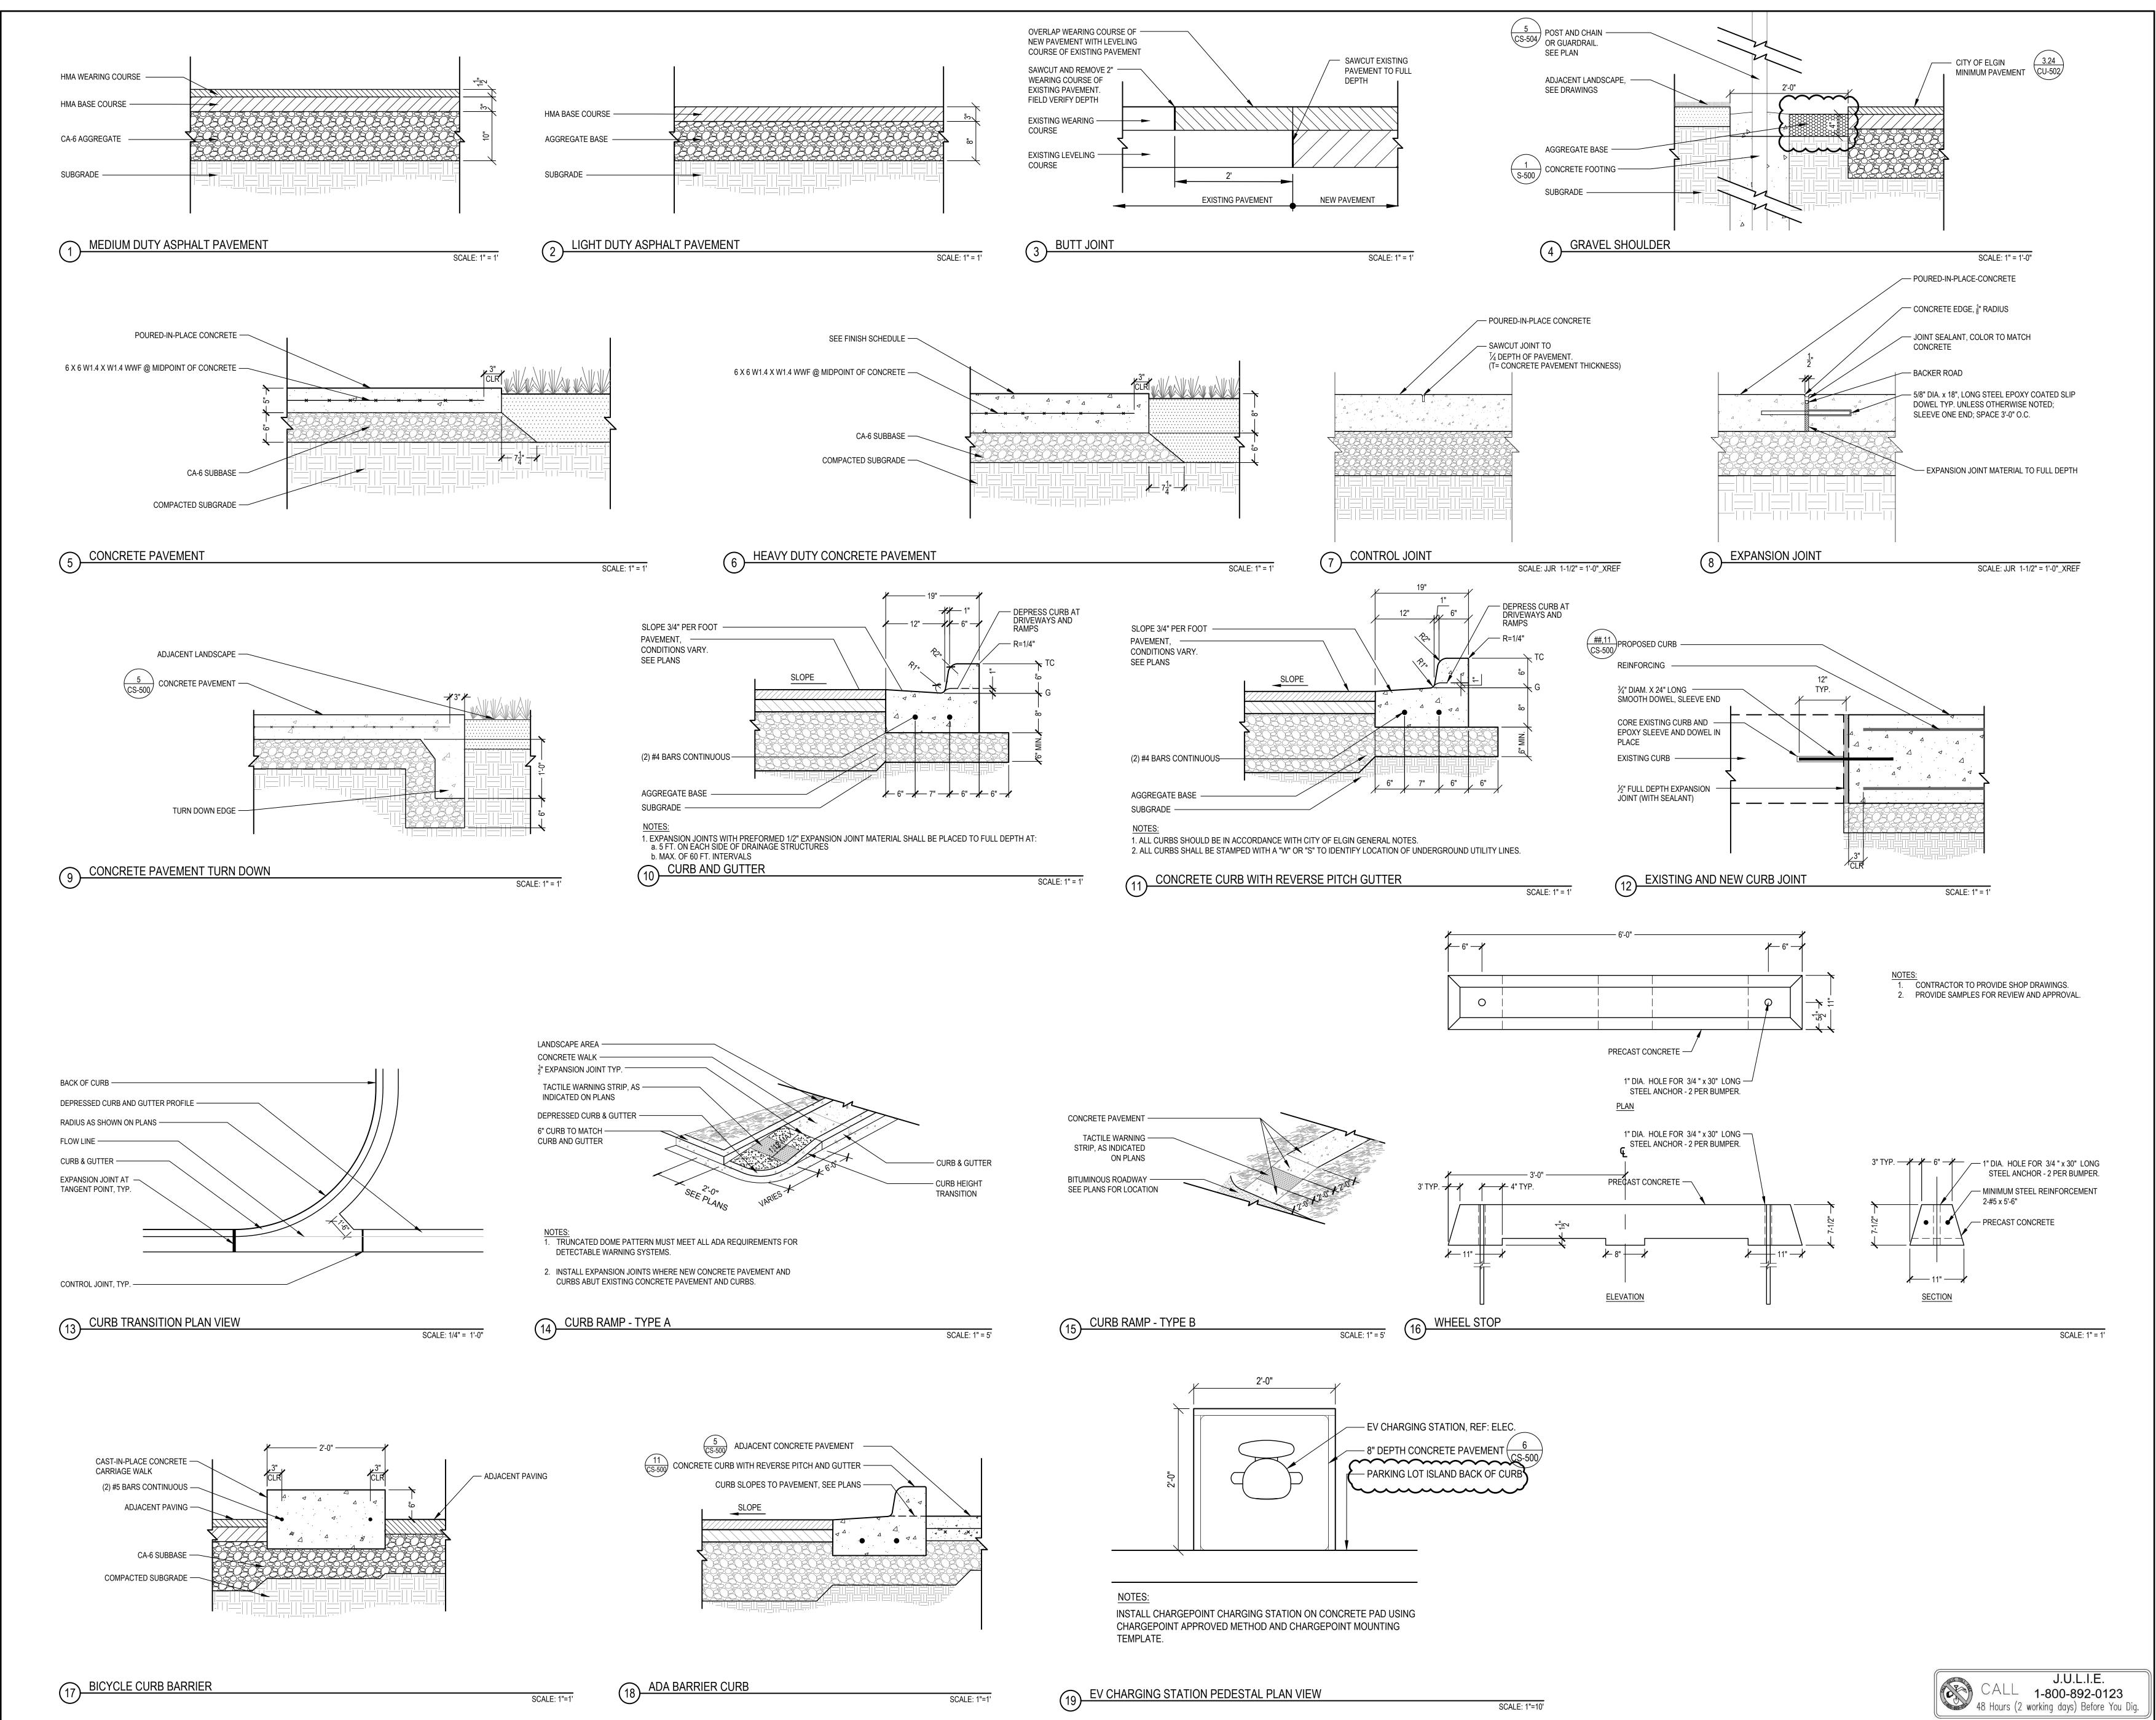


(17) BICYCLE CURB BARRIER


SCALE: 1"=1'


SCALE: 1"=1'


19 EV CHARGING STATION PEDESTAL PLAN VIEW


SCALE: 1"=10'

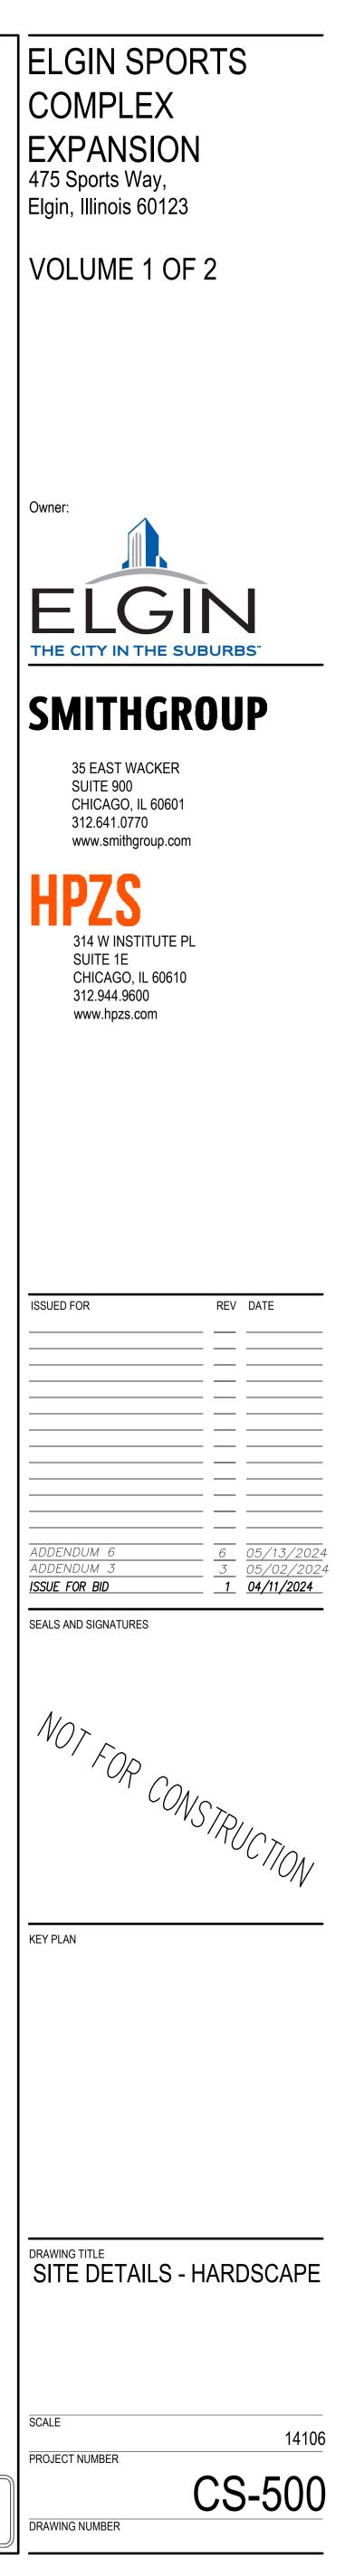

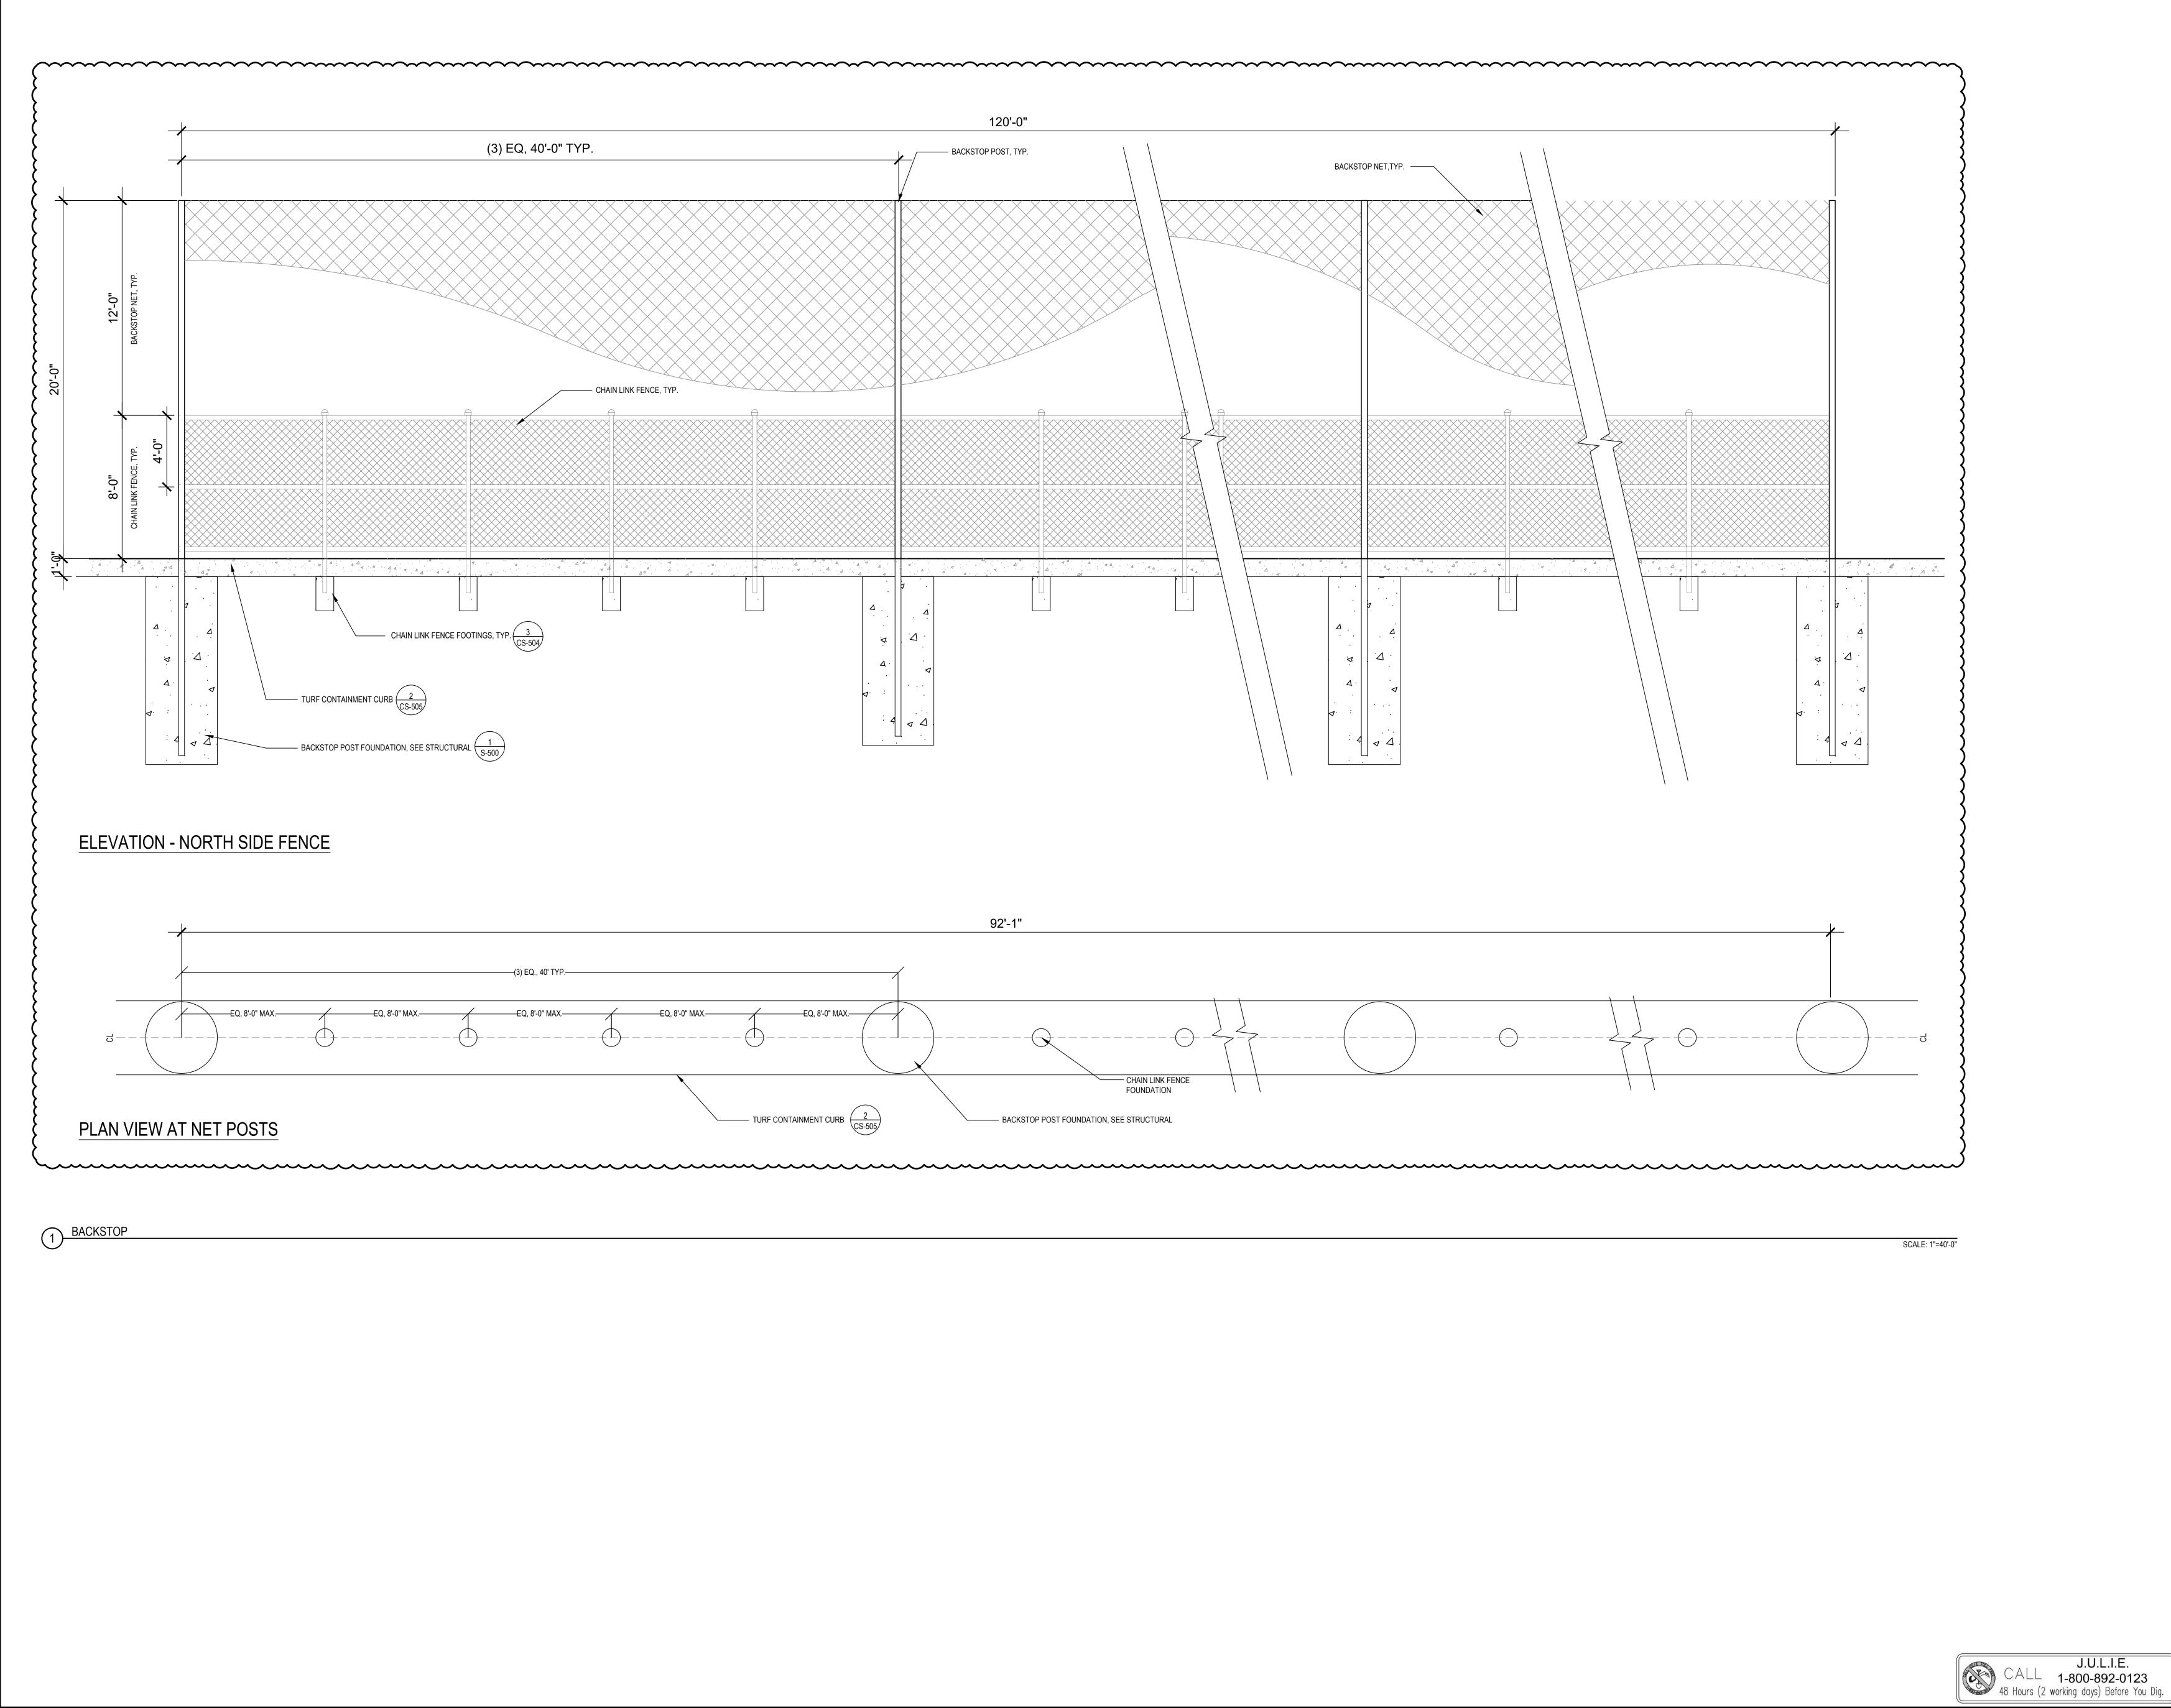


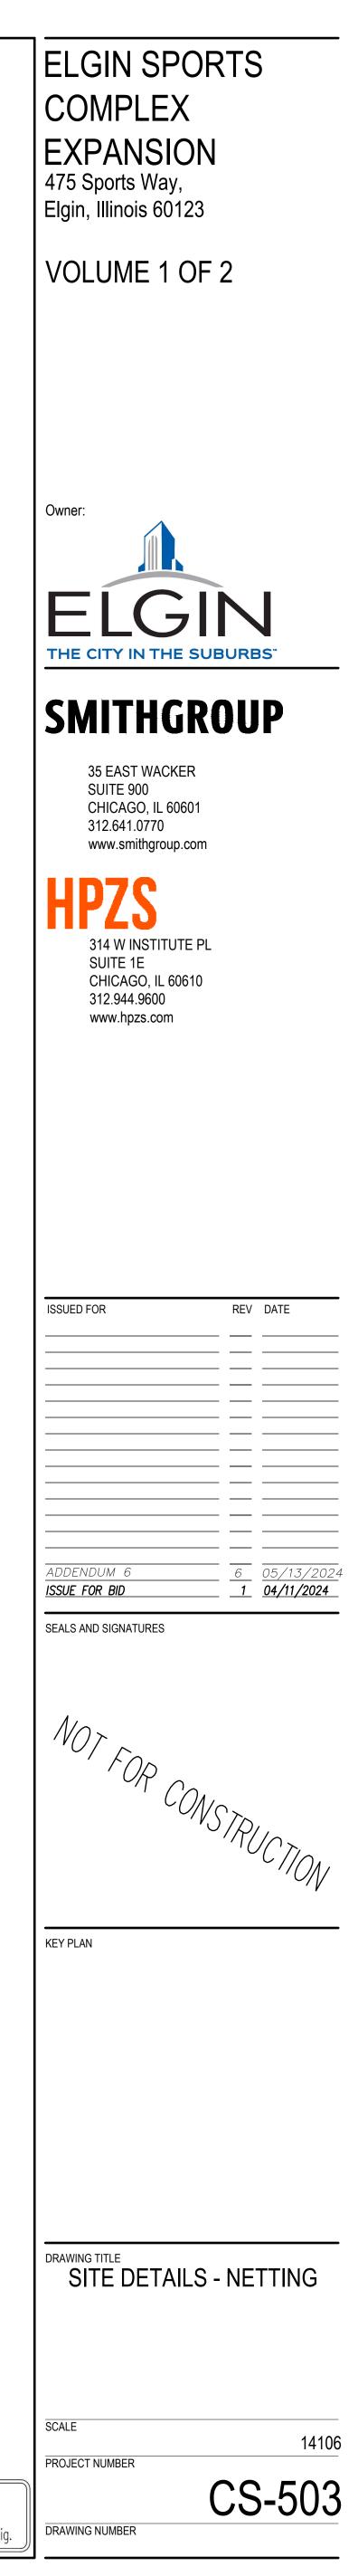


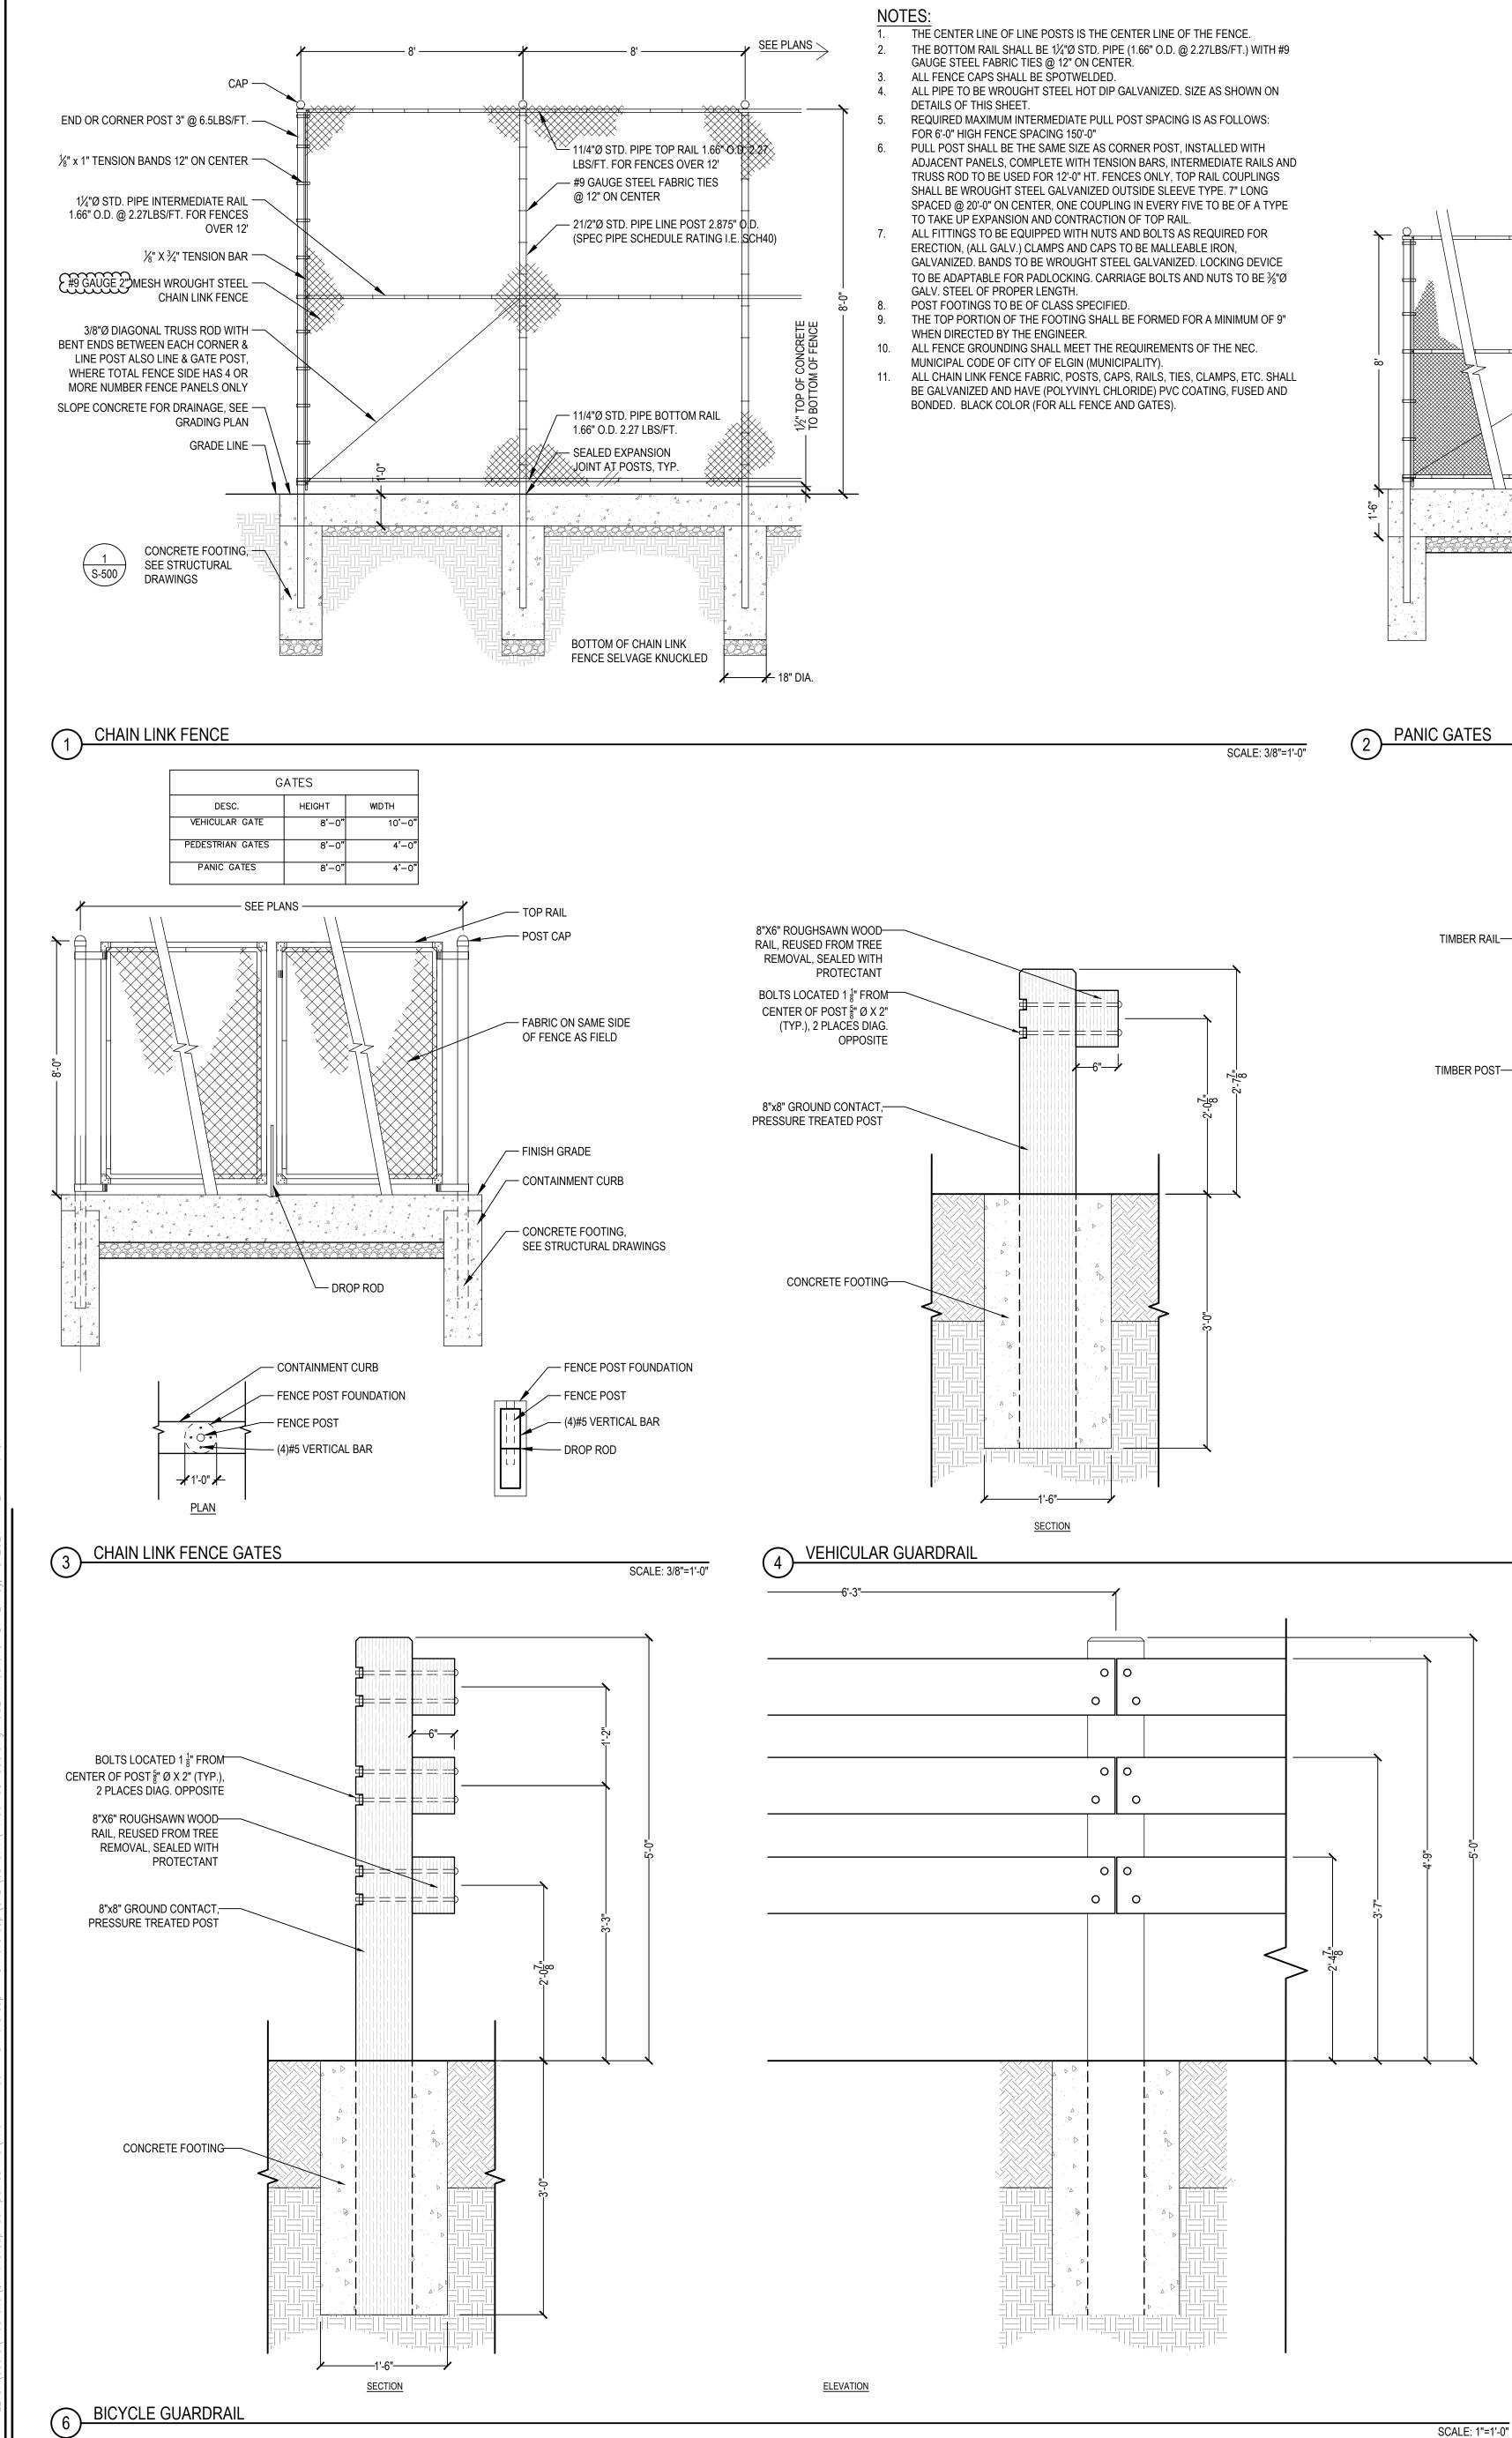

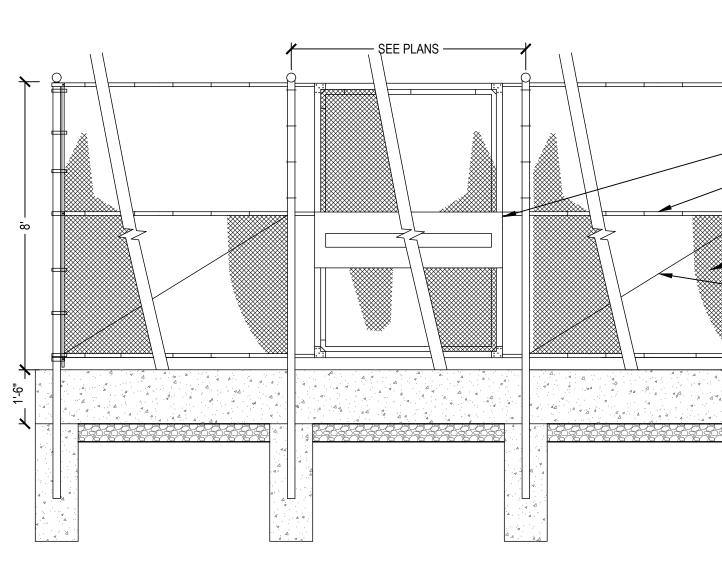

PANIC GATES

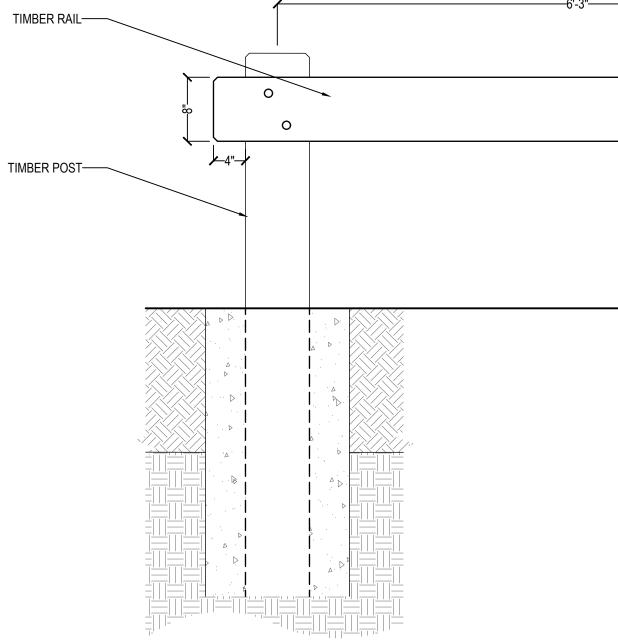

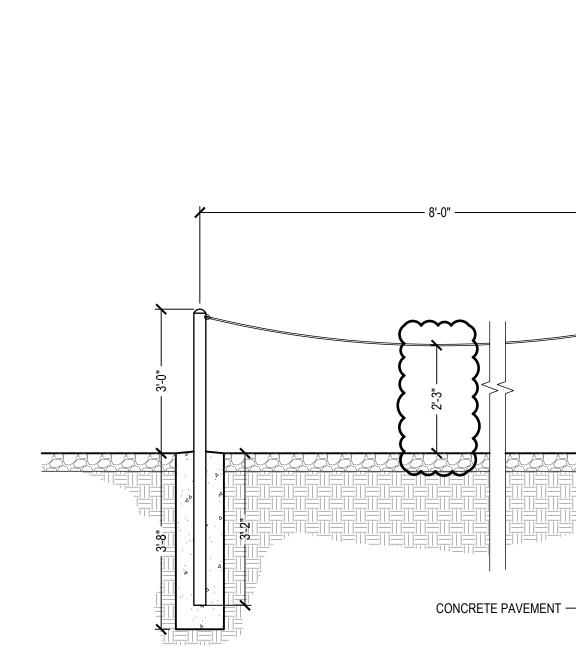


ELEVATION

- /// 1/2 TENSION BANDS 12" ON CENTER — PANIC HARDWARE
- 1¼"Ø STD. PIPE INTERMEDIATE RAIL 1.66" O.D. @ 2.27LBS/FT. FOR FENCES OVER 12'
- /8" X ¾" TENSION BAR #9 GAUGE 1" MESH WROUGHT STEEL CHAIN LINK FENCE GALV. AFTER FABRICATION
- 3/8"Ø DIAGONAL TRUSS ROD WITH BENT ENDS BETWEEN EACH CORNER & LINE POST ALSO LINE & GATE POST, WHERE TOTAL FENCE SIDE HAS 4 OR MORE NUMBER FENCE PANELS ONLY
- SLOPE CONCRETE FOR DRAINAGE, SEE GRADING PLAN — FINISH GRADE
- CONTAINMENT CURB


- NOTES
- 1. SHOP DRAWINGS TO BE PROVIDED FOR ALL FENCING AND GATES.
- 2. ALL CHAIN LINK FENCE FABRIC, POSTS, CAPS, RAILS, TIES, CLAMPS, ETC. SHALL BE GALVANIZED AND HAVE (POLYVINYL CHLORIDE) PVC COATING, FUSED AND BONDED. BLACK COLOR (FOR ALL FENCE AND GATES).
- PANIC HARDWARE: 1. ALL PANIC HARDWARE TO COMPLY WITH APPLICABLE FIRE / LIFE
- SAFETY CODES. ALL HARDWARE TO COMPLY WITH APPLICABLE BUILDING AND ACCESSIBILITY CODES.

SCALE: 3/8" - 1'-0"


- 2. PLACE ON PANIC GATES ONLY. 3. SURFACE MOUNT EXIT BAR.
- 4. MOUNTING PLATE. 5. ADJUSTABLE RECEIVER BRACKET.
- 6. STAINLESS STEEL SCREWS AND FASTENERS. 7. COLOR: BLACK.

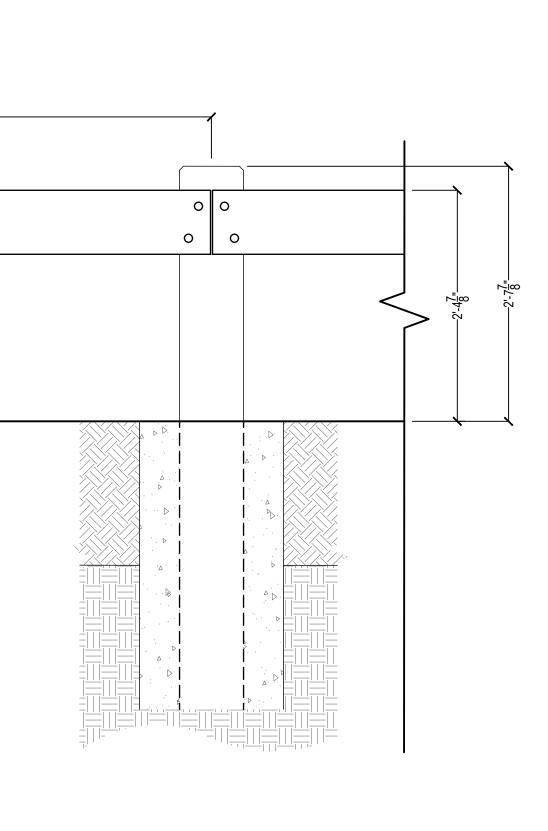


SCALE: 1"=1'-0"

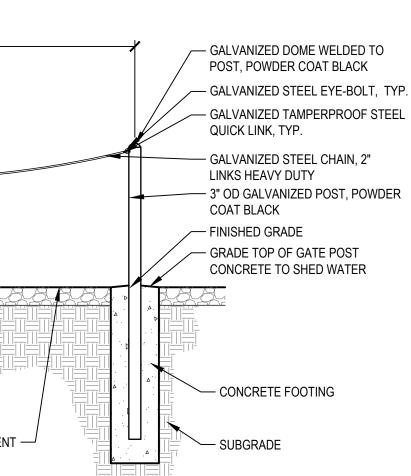


SCALE: 1/2"=1'-0"

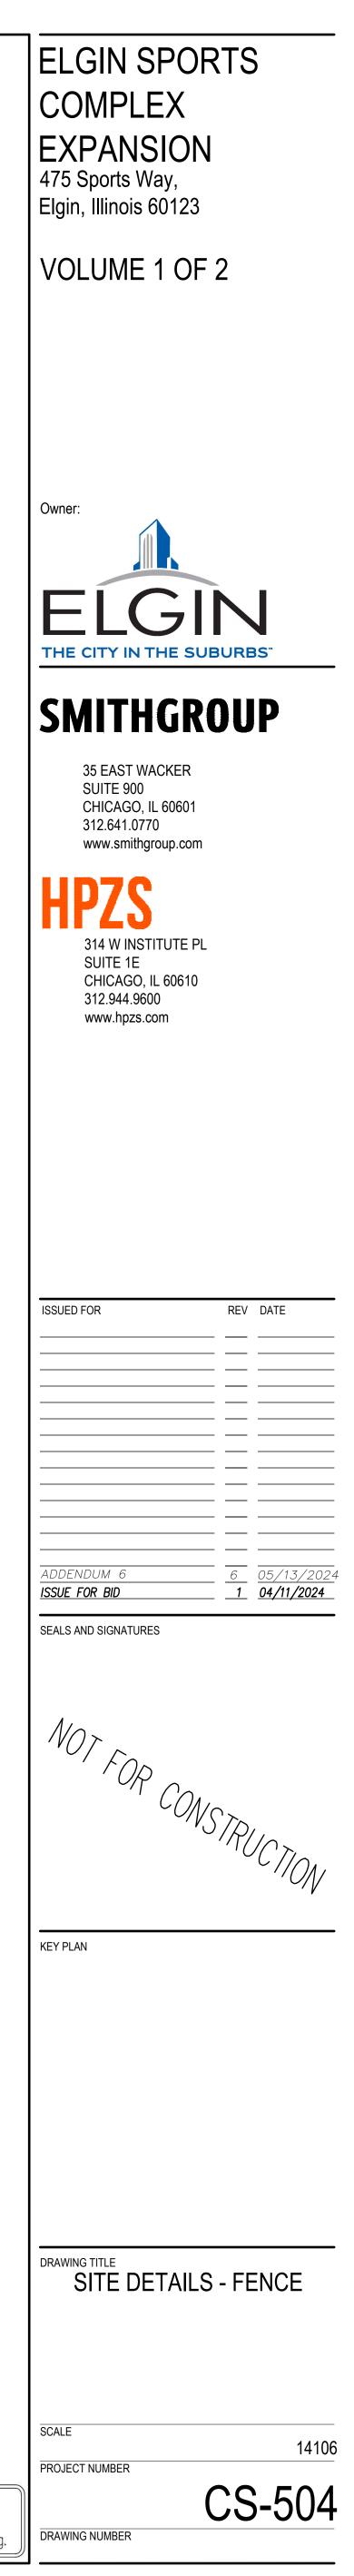


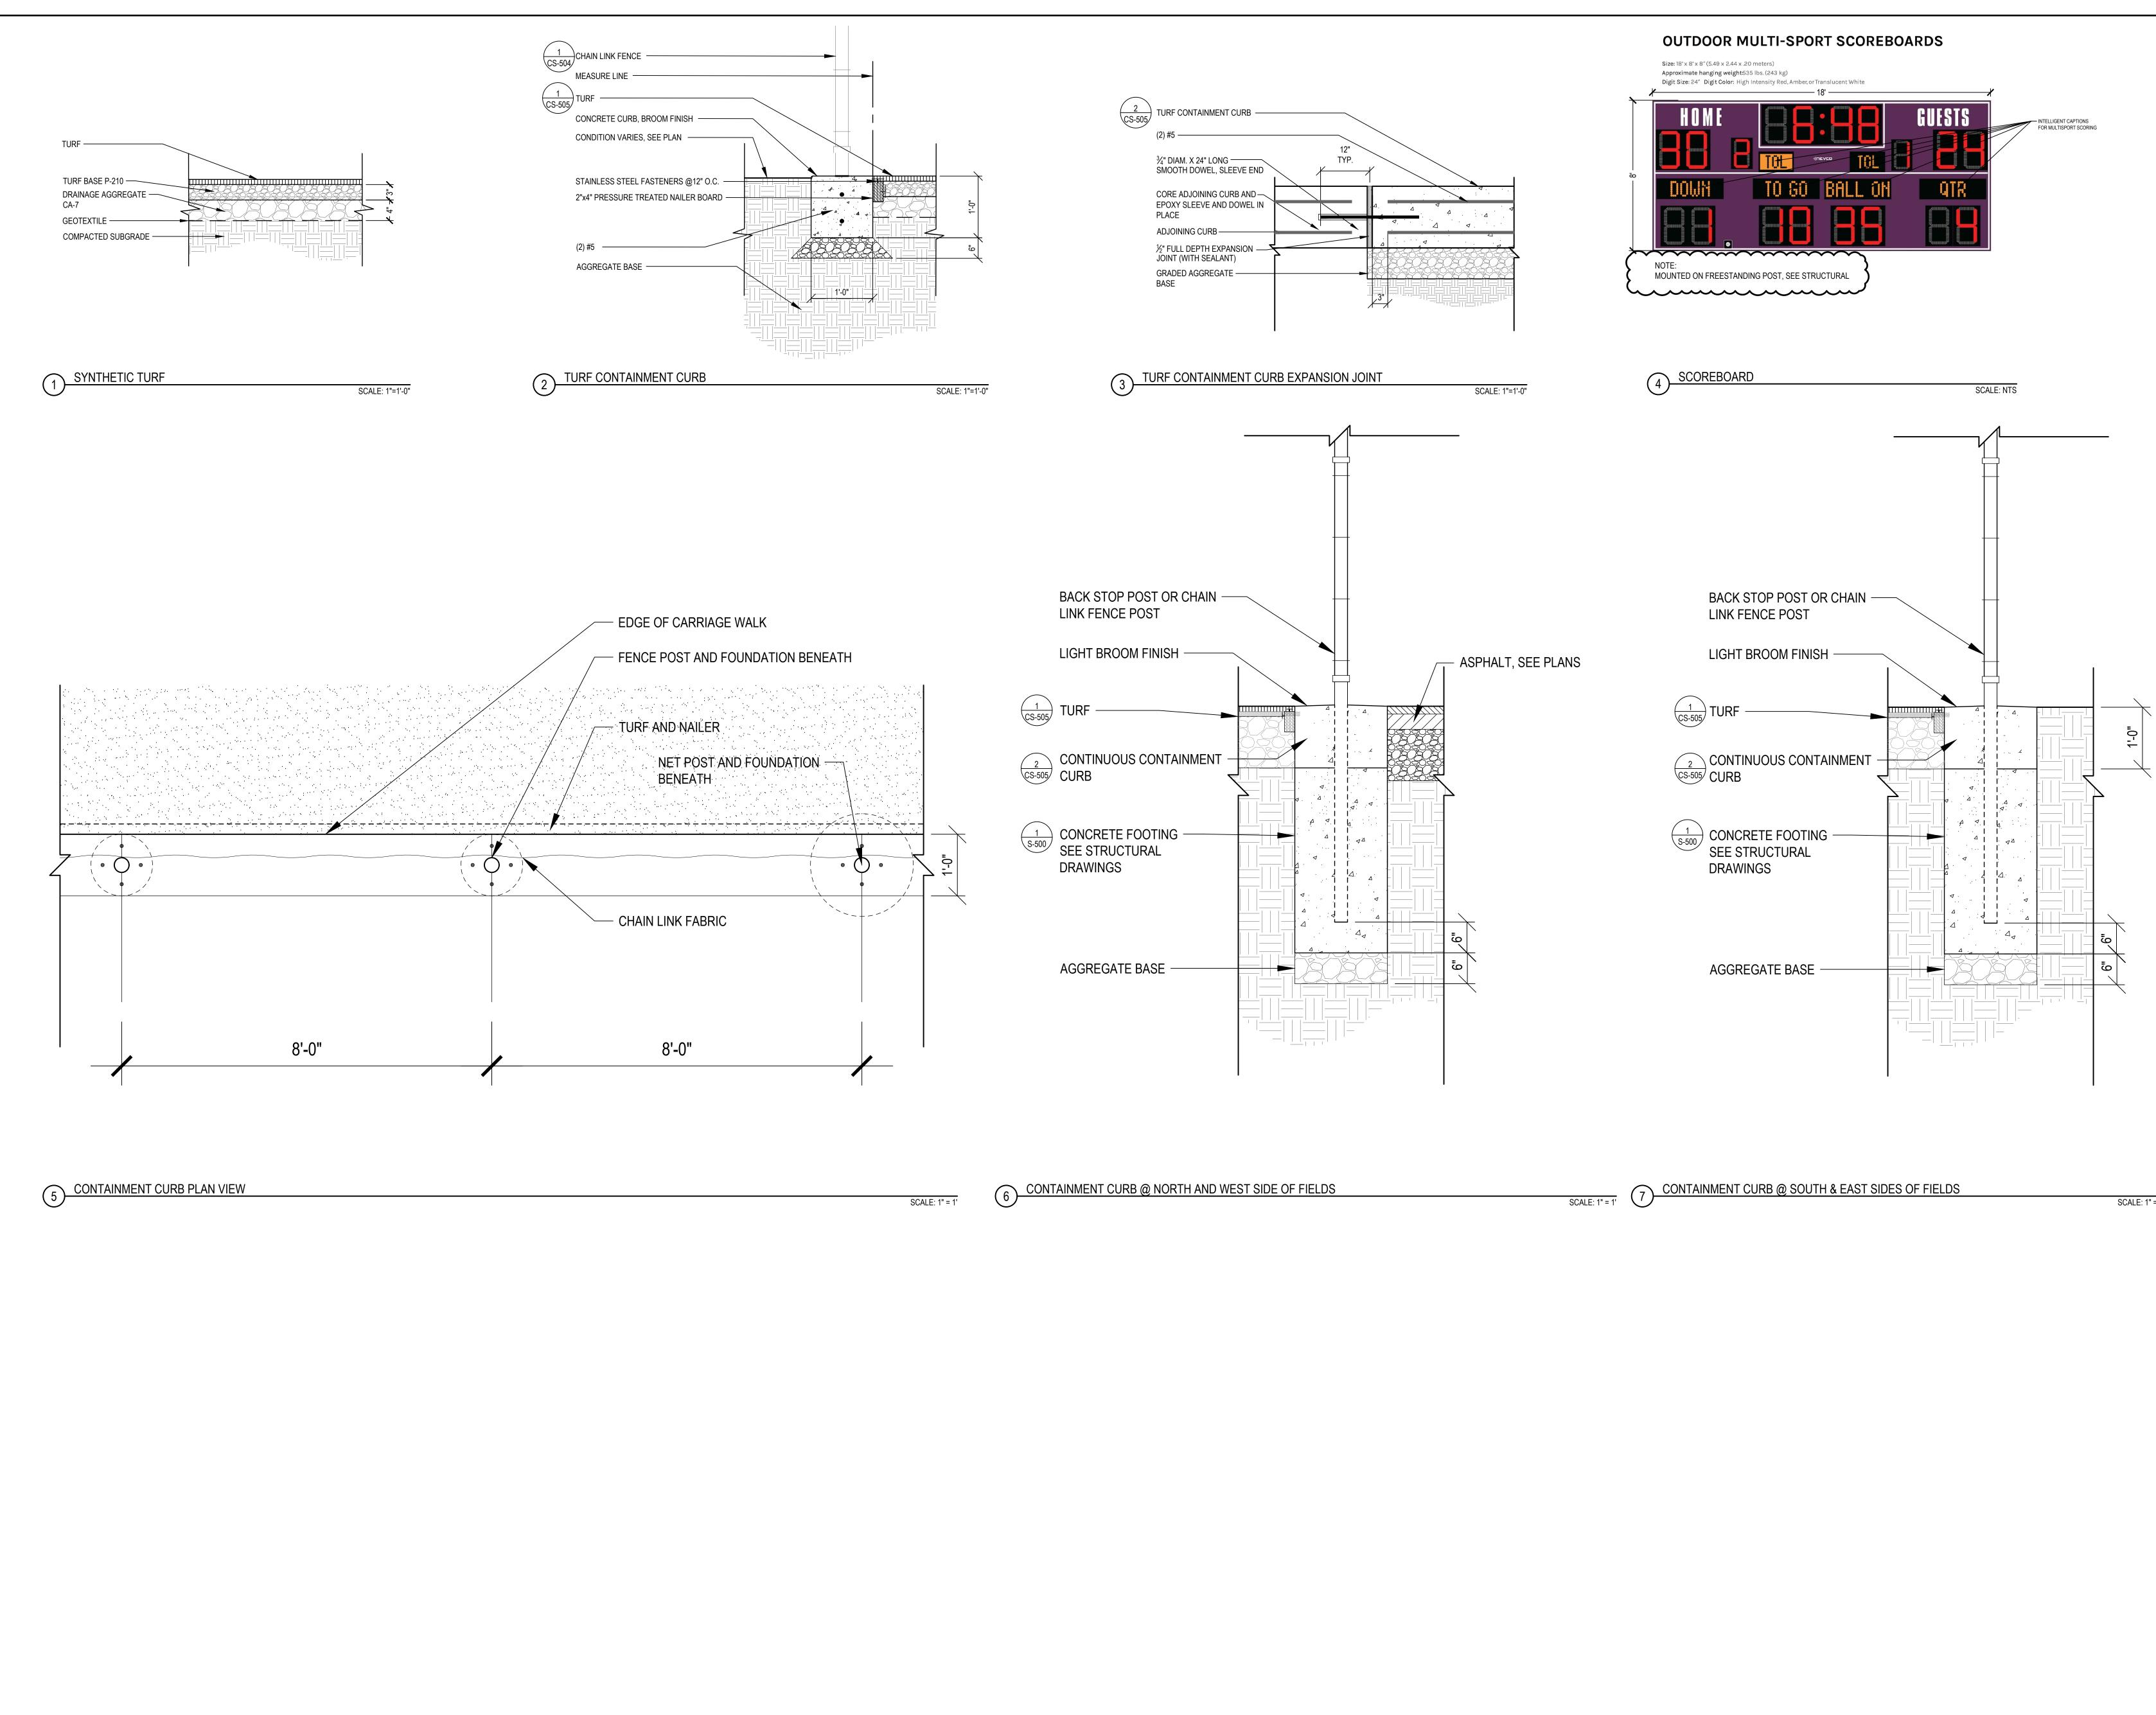



SCALE: 1" = 1'




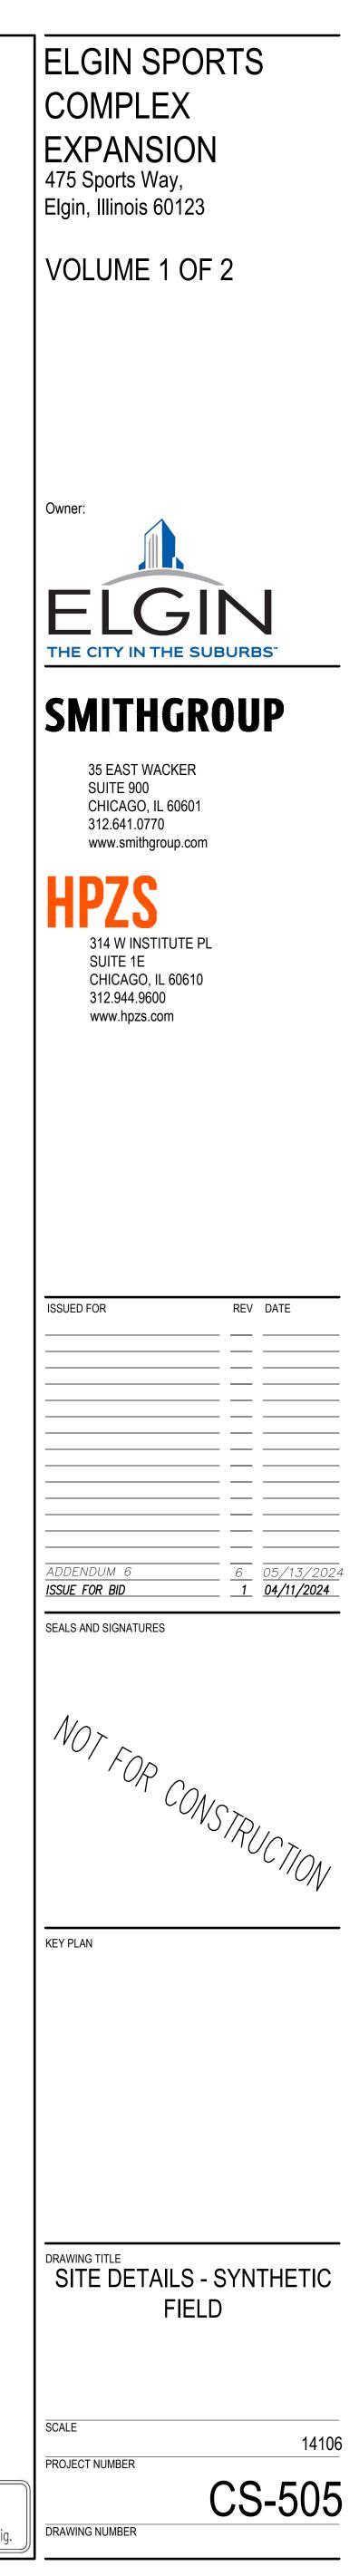

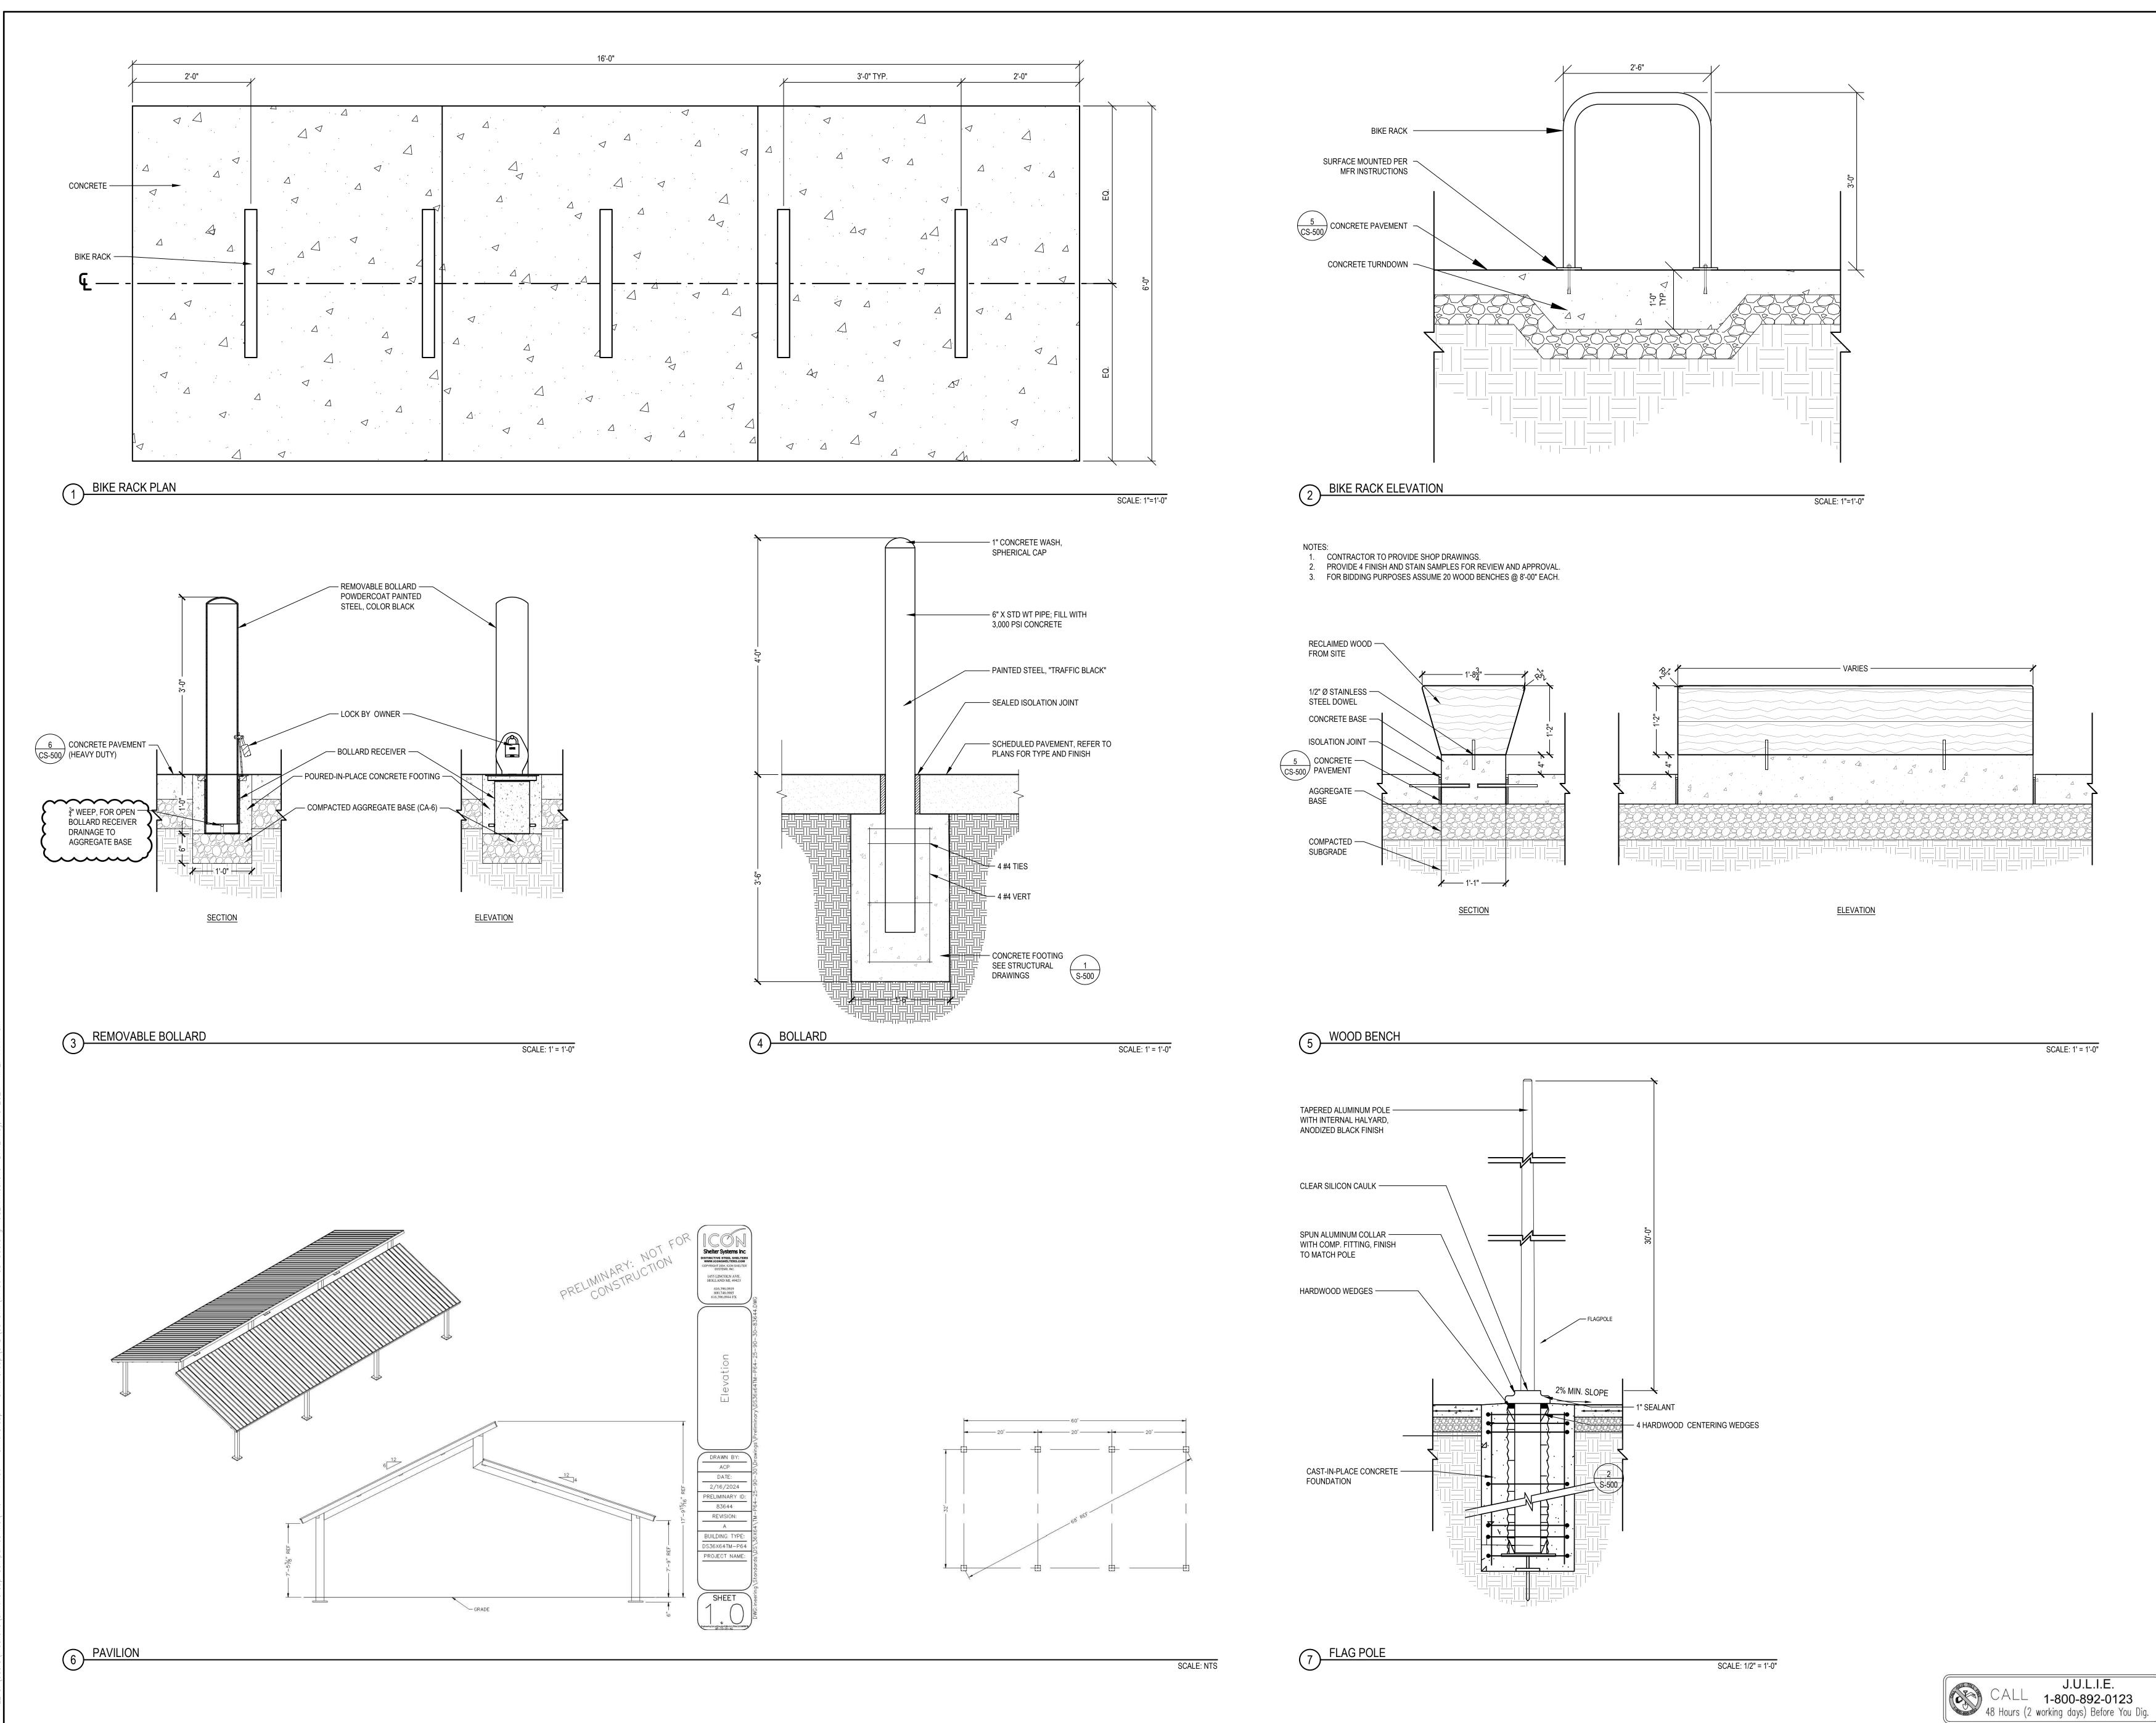


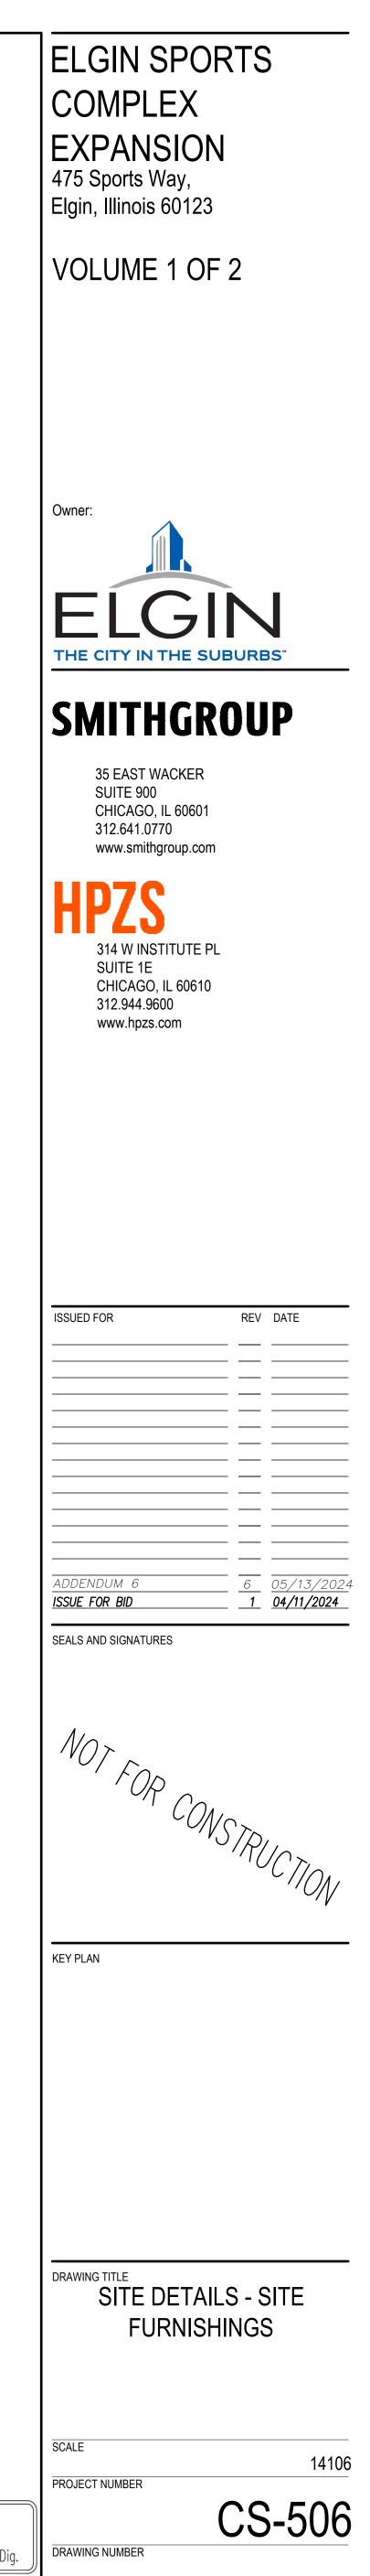

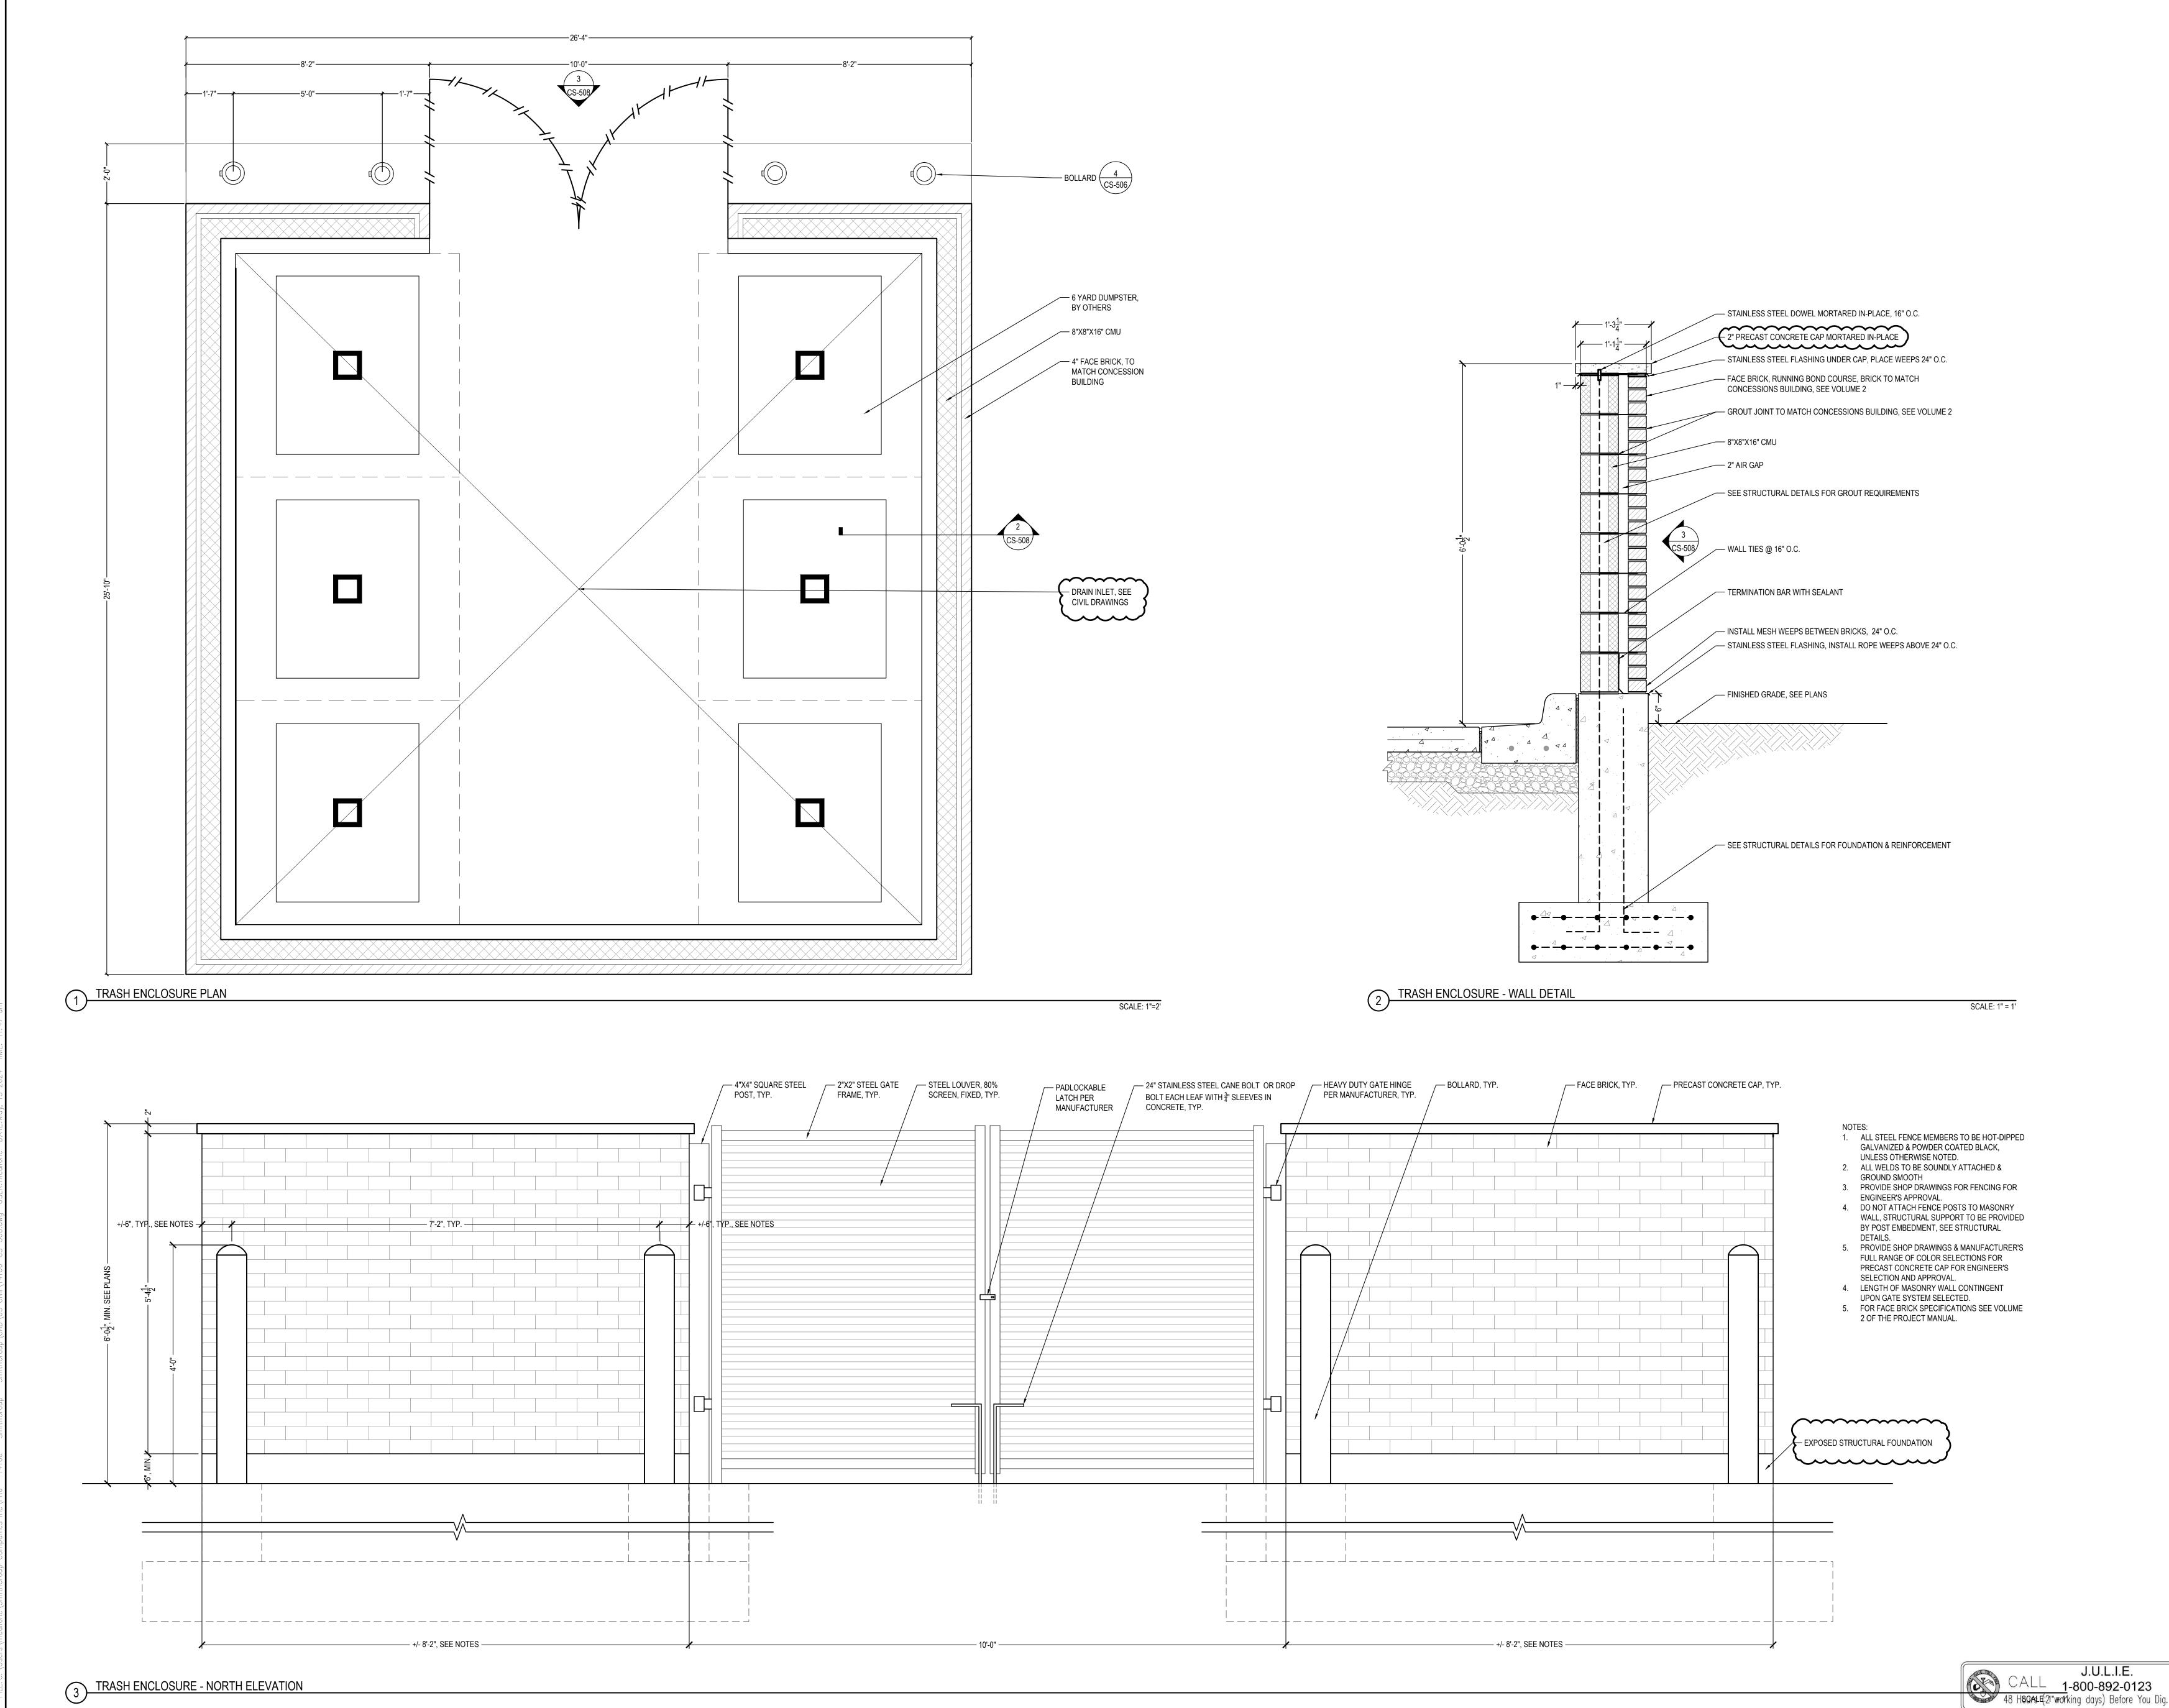


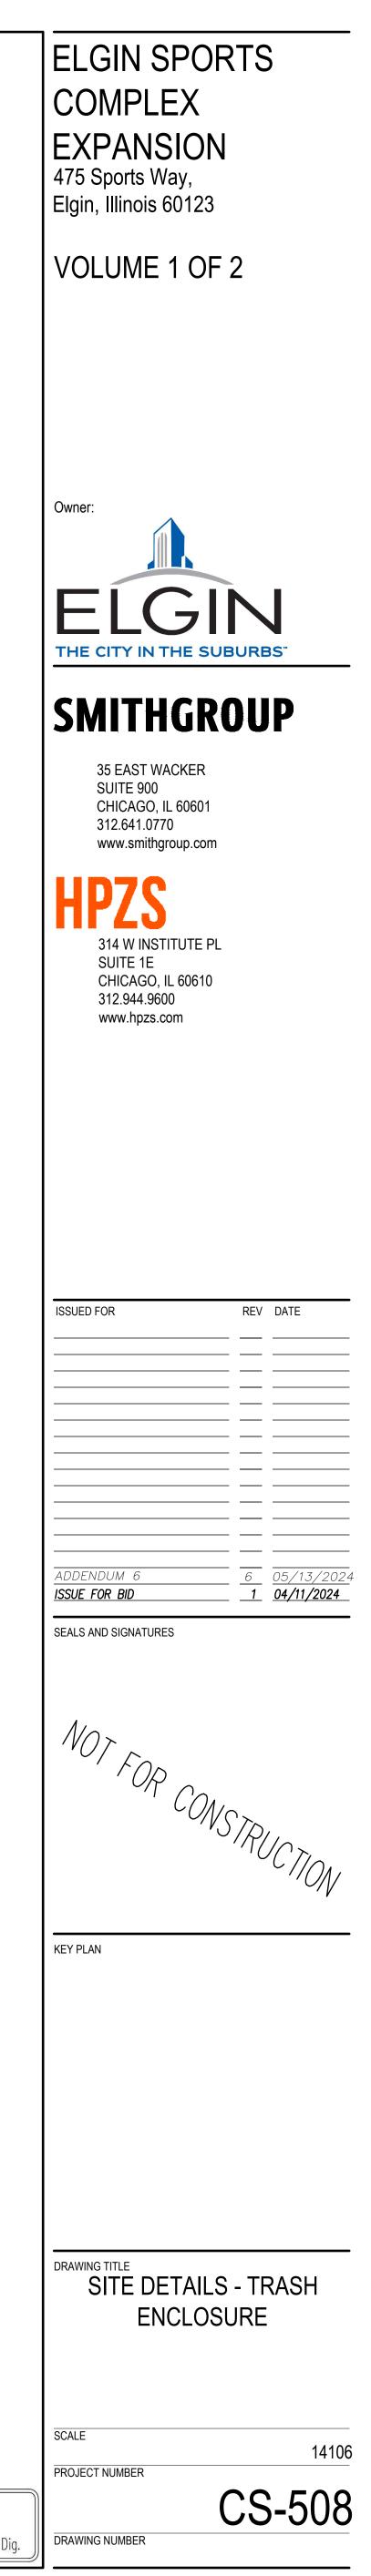


Inv 763.95 Top of Water Inv 763.45956505"0RGPructure Inv 762.91

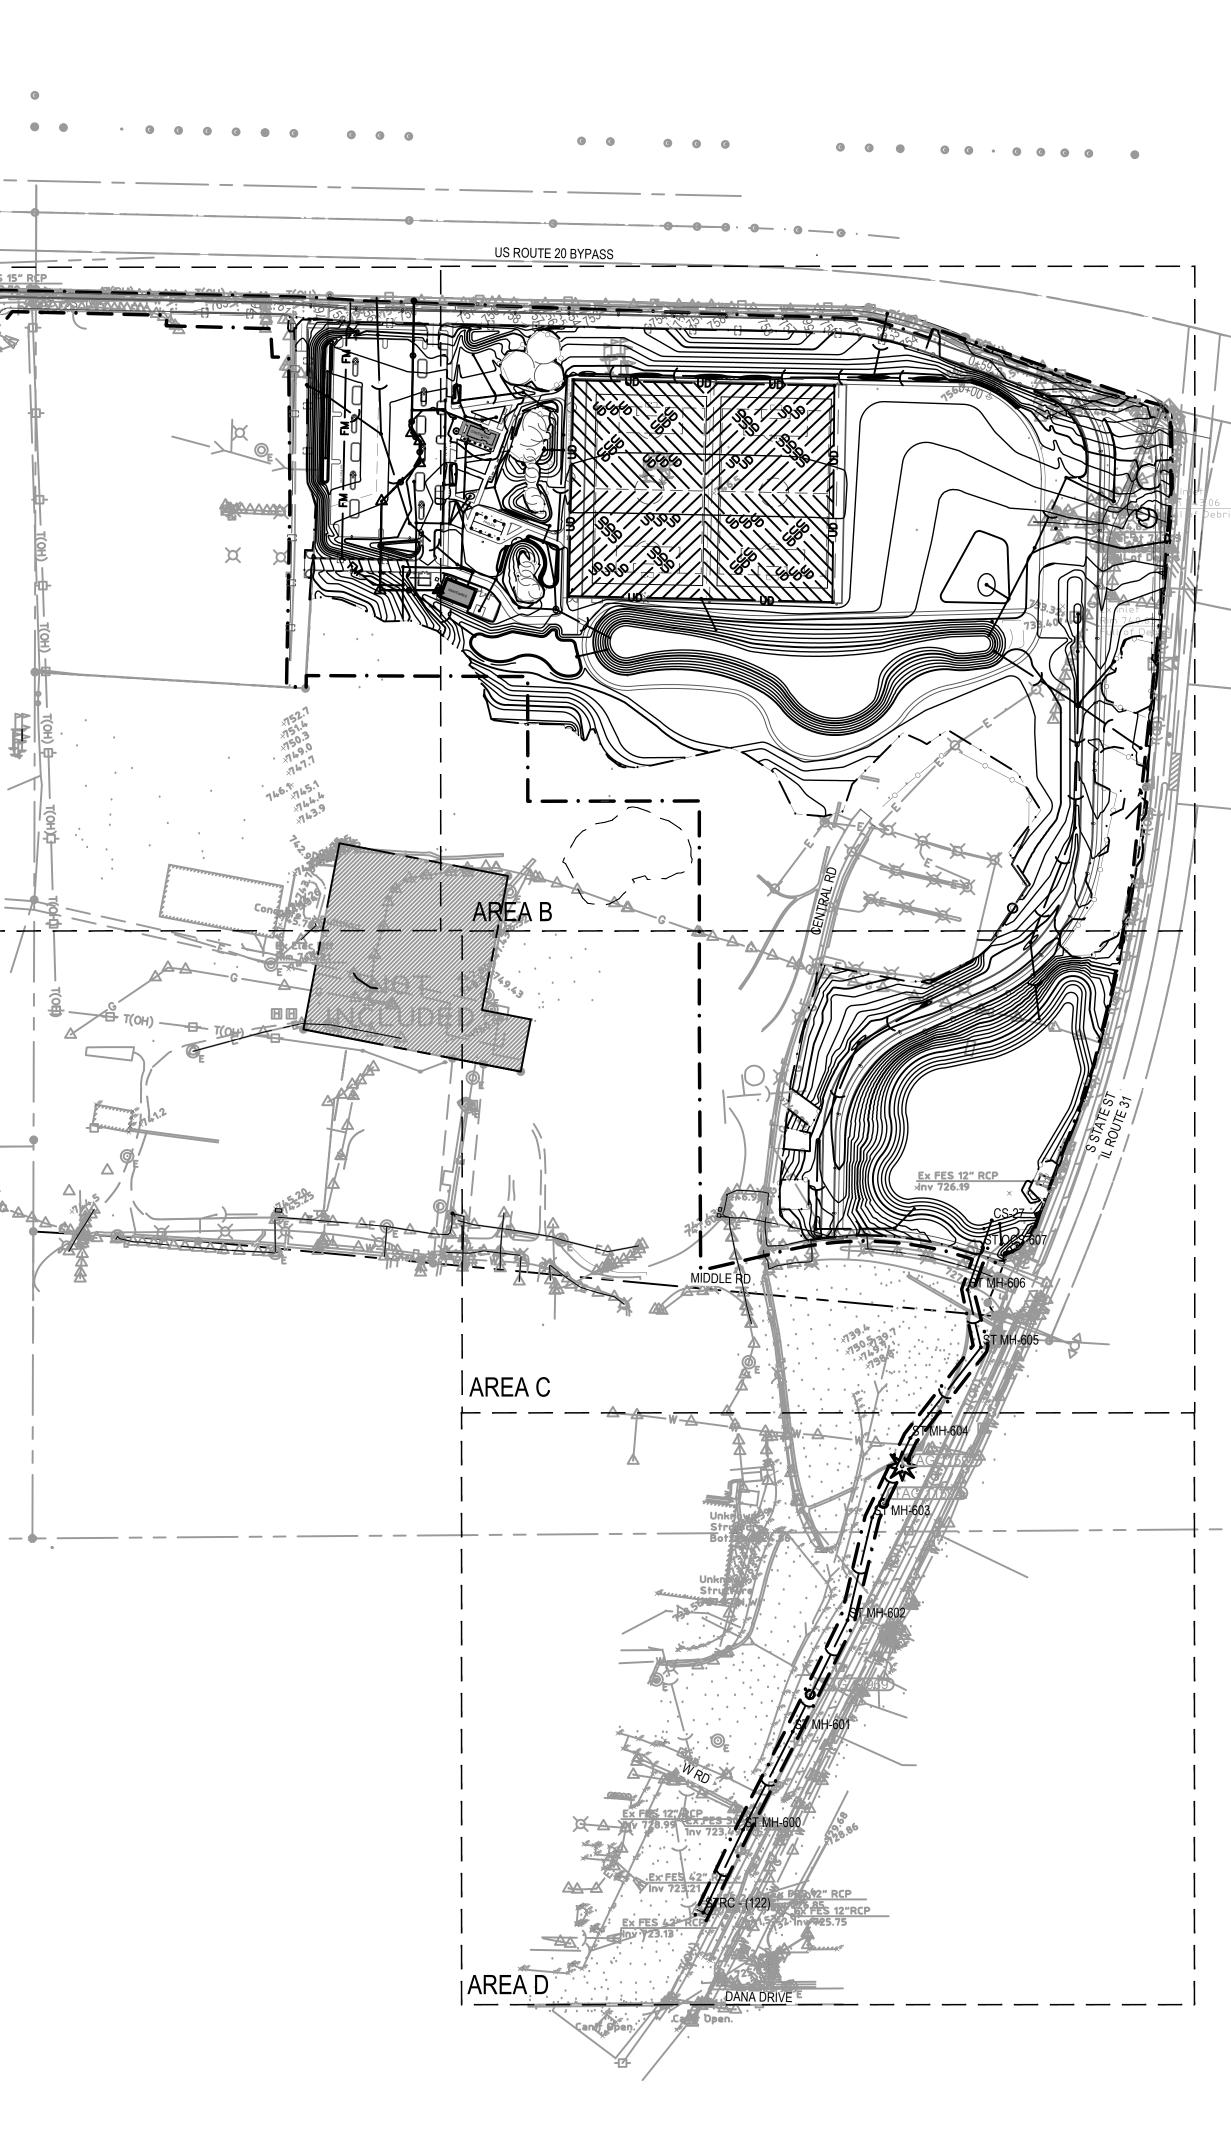

N	SHEET NOTES	
	 BEFORE ANY EXCAVATION ON THE SITE, CALL 811 TO LOCAT EXISTING UTILITIES ON THE SITE. THE CONTRACTOR SHALL FAMILIAR WITH THE LOCATION OF ALL BURIED UTILITIES IN AREAS OF WORK BEFORE STARTING OPERATIONS. THE COI SHALL BE LIABLE FOR THE COST OF REPAIRING OR REPLAC BURIED CONDUIT, CABLES, OR PIPING DAMAGED DURING TH INSTALLATION OF THIS WORK. VERIFY DEPTH AND LOCATION OF EXISTING SEWER AND MA PRIOR TO START OF ANY SEWER CONSTRUCTION. REPORT DISCREPANCIES OR CONFLICTS TO THE ARCHITECT/ENGINE ALL UTILITY STRUCTURES, INCLUDING BUT NOT LIMITED TO CLEAN-OUTS, MANHOLES, CATCH BASINS, STRUCTURES, VA BOXES, SHUT OFF VALVES, VAULT COVERS, ELECTRICAL VA COVERS, ELECTRICAL PULL BOXES, ETC., TO REMAIN SHALL ADJUSTED TO FINISH GRADE UNLESS OTHERWISE NOTED. WHEREVER A SEWER CROSSES UNDER A WATER MAIN, THE VERTICAL DISTANCE FROM THE TOP OF THE SEWER TO THE OF THE WATER MAIN SHALL BE 18 INCHES. FURTHERMORE, MINIMUM HORIZONTAL DISTANCE OF 10 FEET BETWEEN SAN SEWERS AND WATER MAINS SHALL BE MAINTAINED UNLESS SEWER IS LAID IN A SEPARATE TRENCH, KEEPING A MINIMU VERTICAL SEPARATION; OR THE SEWER IS LAID IN THE SAM WITH THE WATER MAIN LOCATED AT THE OPPOSITE SIDE OI OF UNDISTURBED EARTH, KEEPING A MINIMUM 18" VERTICA SEPARATION. IF EITHER THE VERTICAL OR HORIZONTAL DIS DESCRIBED ABOVE CANNOT BE MAINTAINED, OR <u>THE SEWER CROSSES ABOVE THE WATER MAIN</u> STANDARDS. ALL WATER SERVICE LINE AND WATER MAIN STANDARD SPECIFICATIO WATER & SEWER MAIN CONSTRUCTION IN ILLINOIS, SEVENT EDITION. 	BECC THE NTRAC ING A IE NHOL ANY ER LVE ULT BE MINI E BOT A NITAR STHE N A BE L STANC R G ANE IE CIT NS FO
	KEYED NOTES	
	LEGEND	

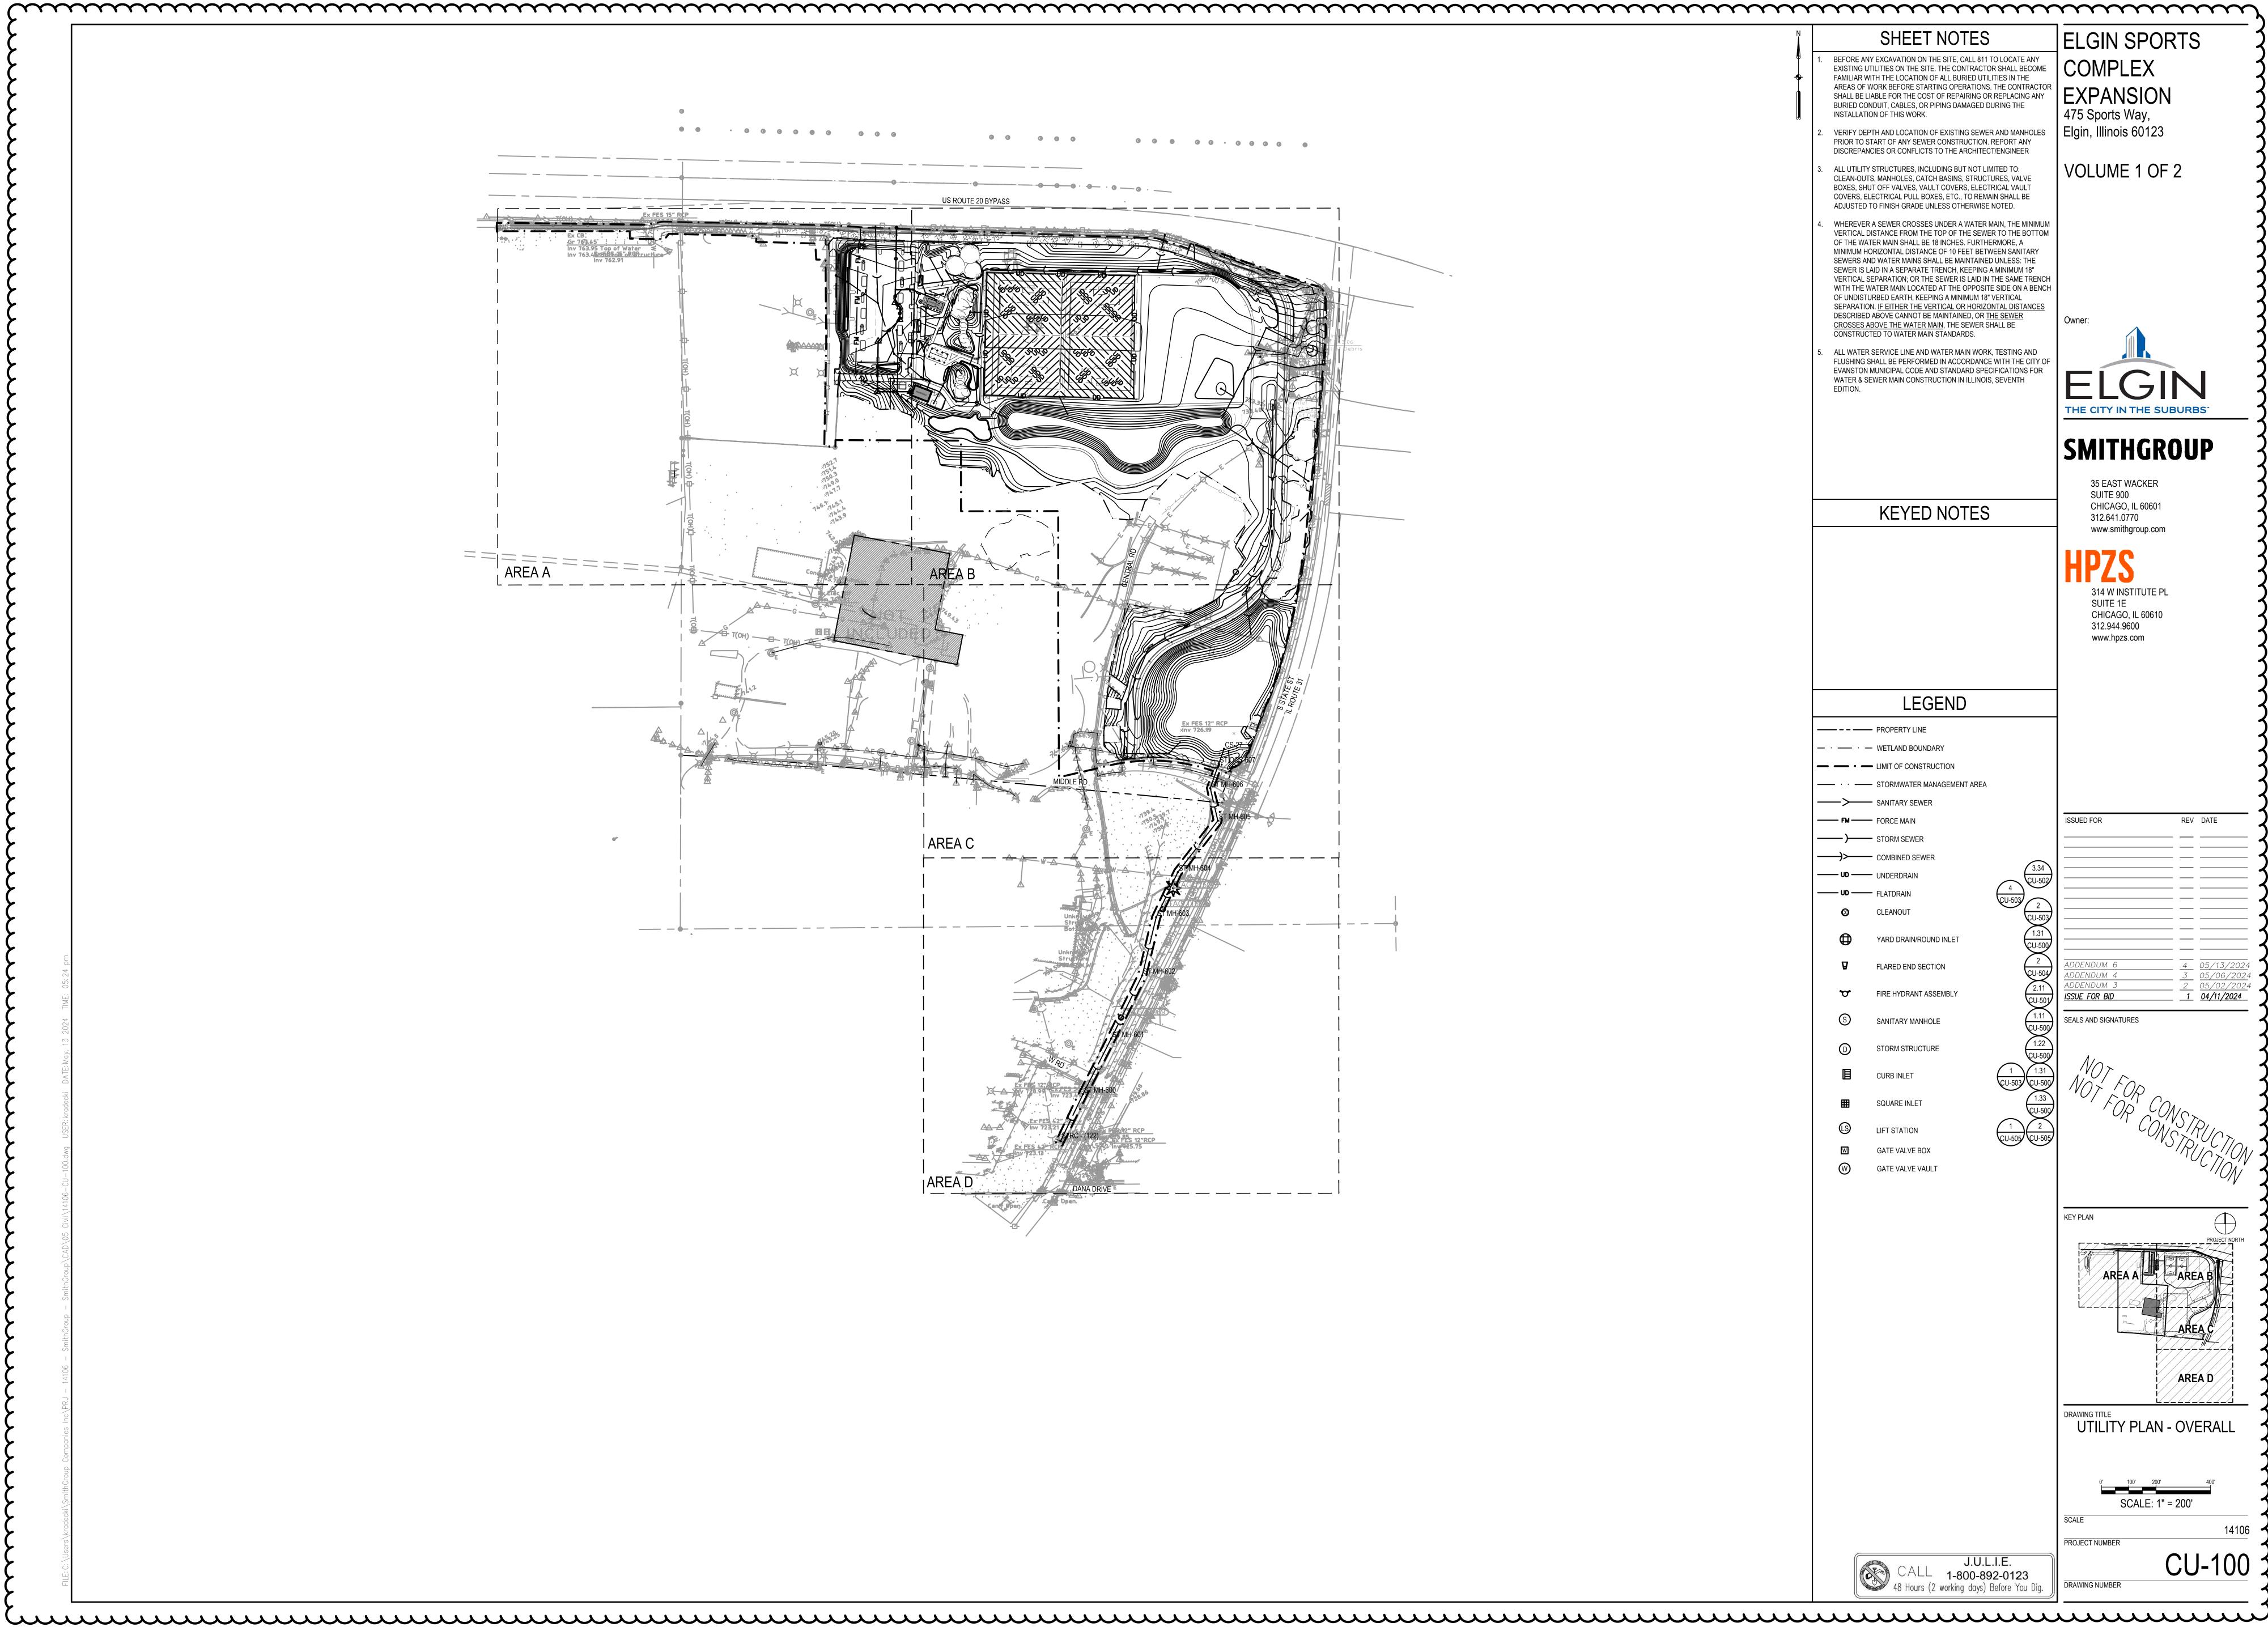


• • •	Ex See MH Rim 781.67 Inv 760.17 (E,W)					Ex CB Gr 761.45 Inv 763.45 Botto
	0	•	 	• •		
			0.	· .	· · · ·	Ex CB Gr 761.45 Inv 763.95 Tóp o Inv 763.45 Botto

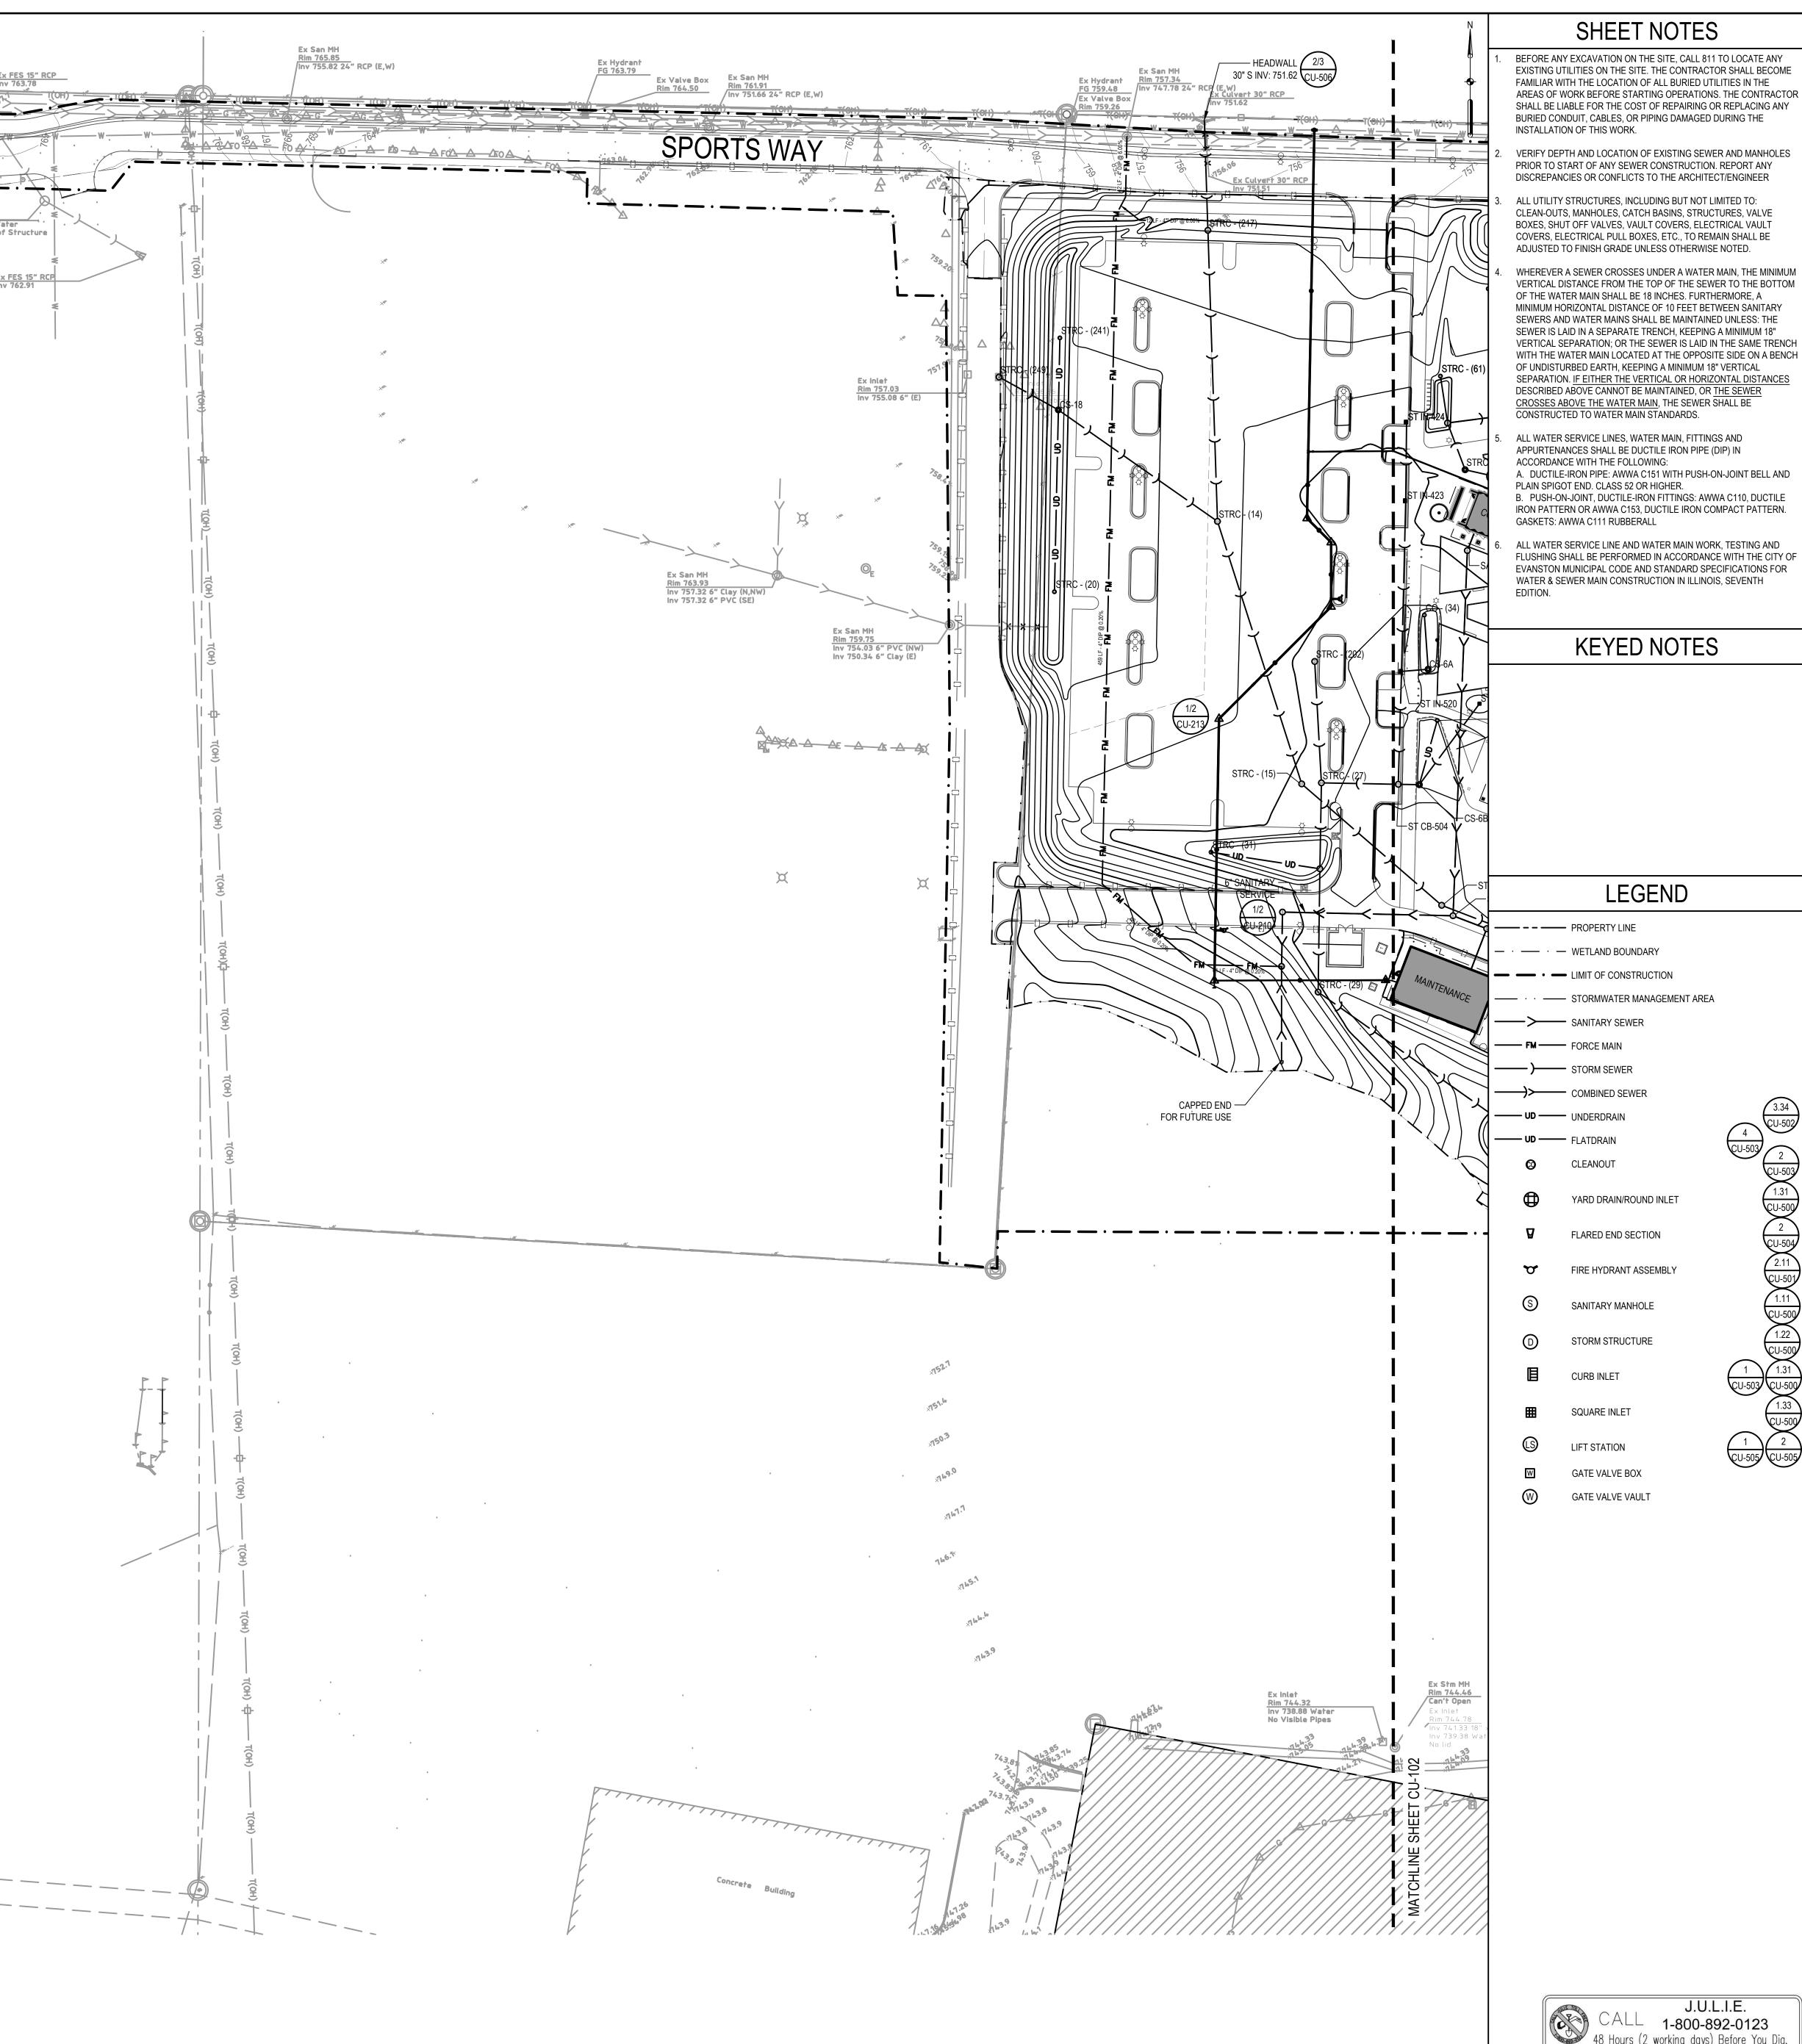


 J.U.L.I.E.


 CALL
 1-800-892-0123


 48 Hours (2 working days) Before You Dig.

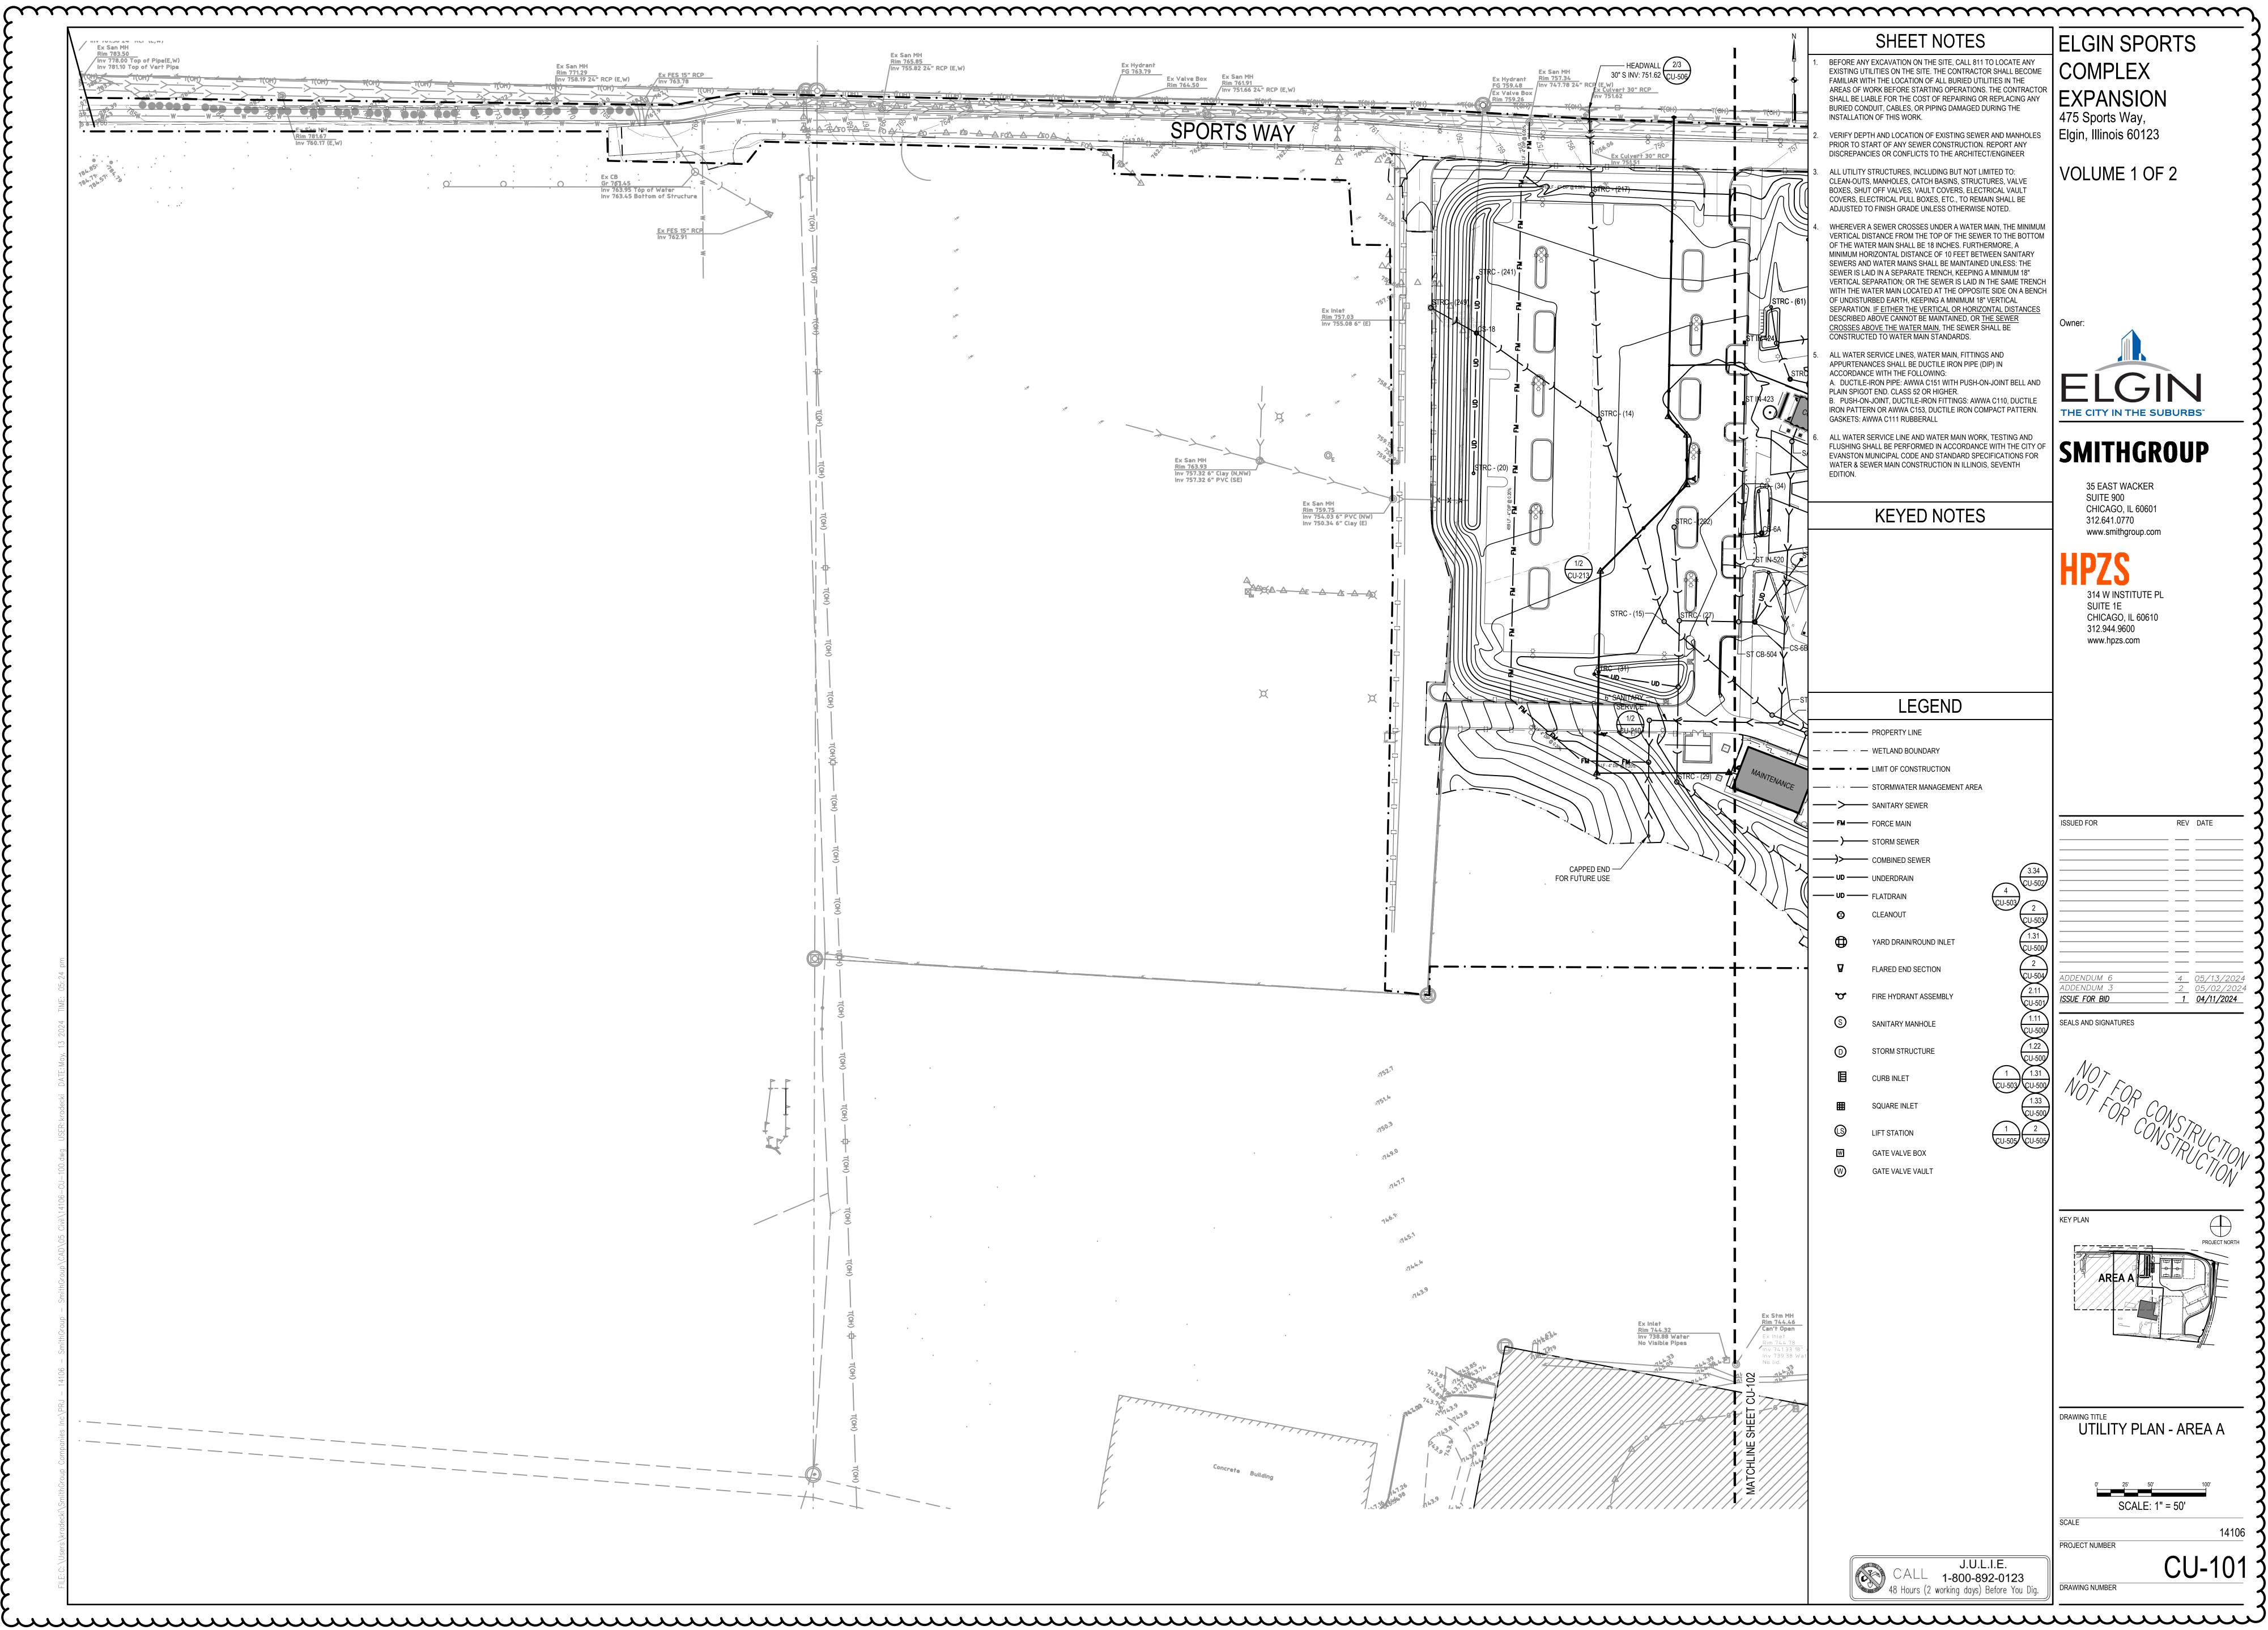


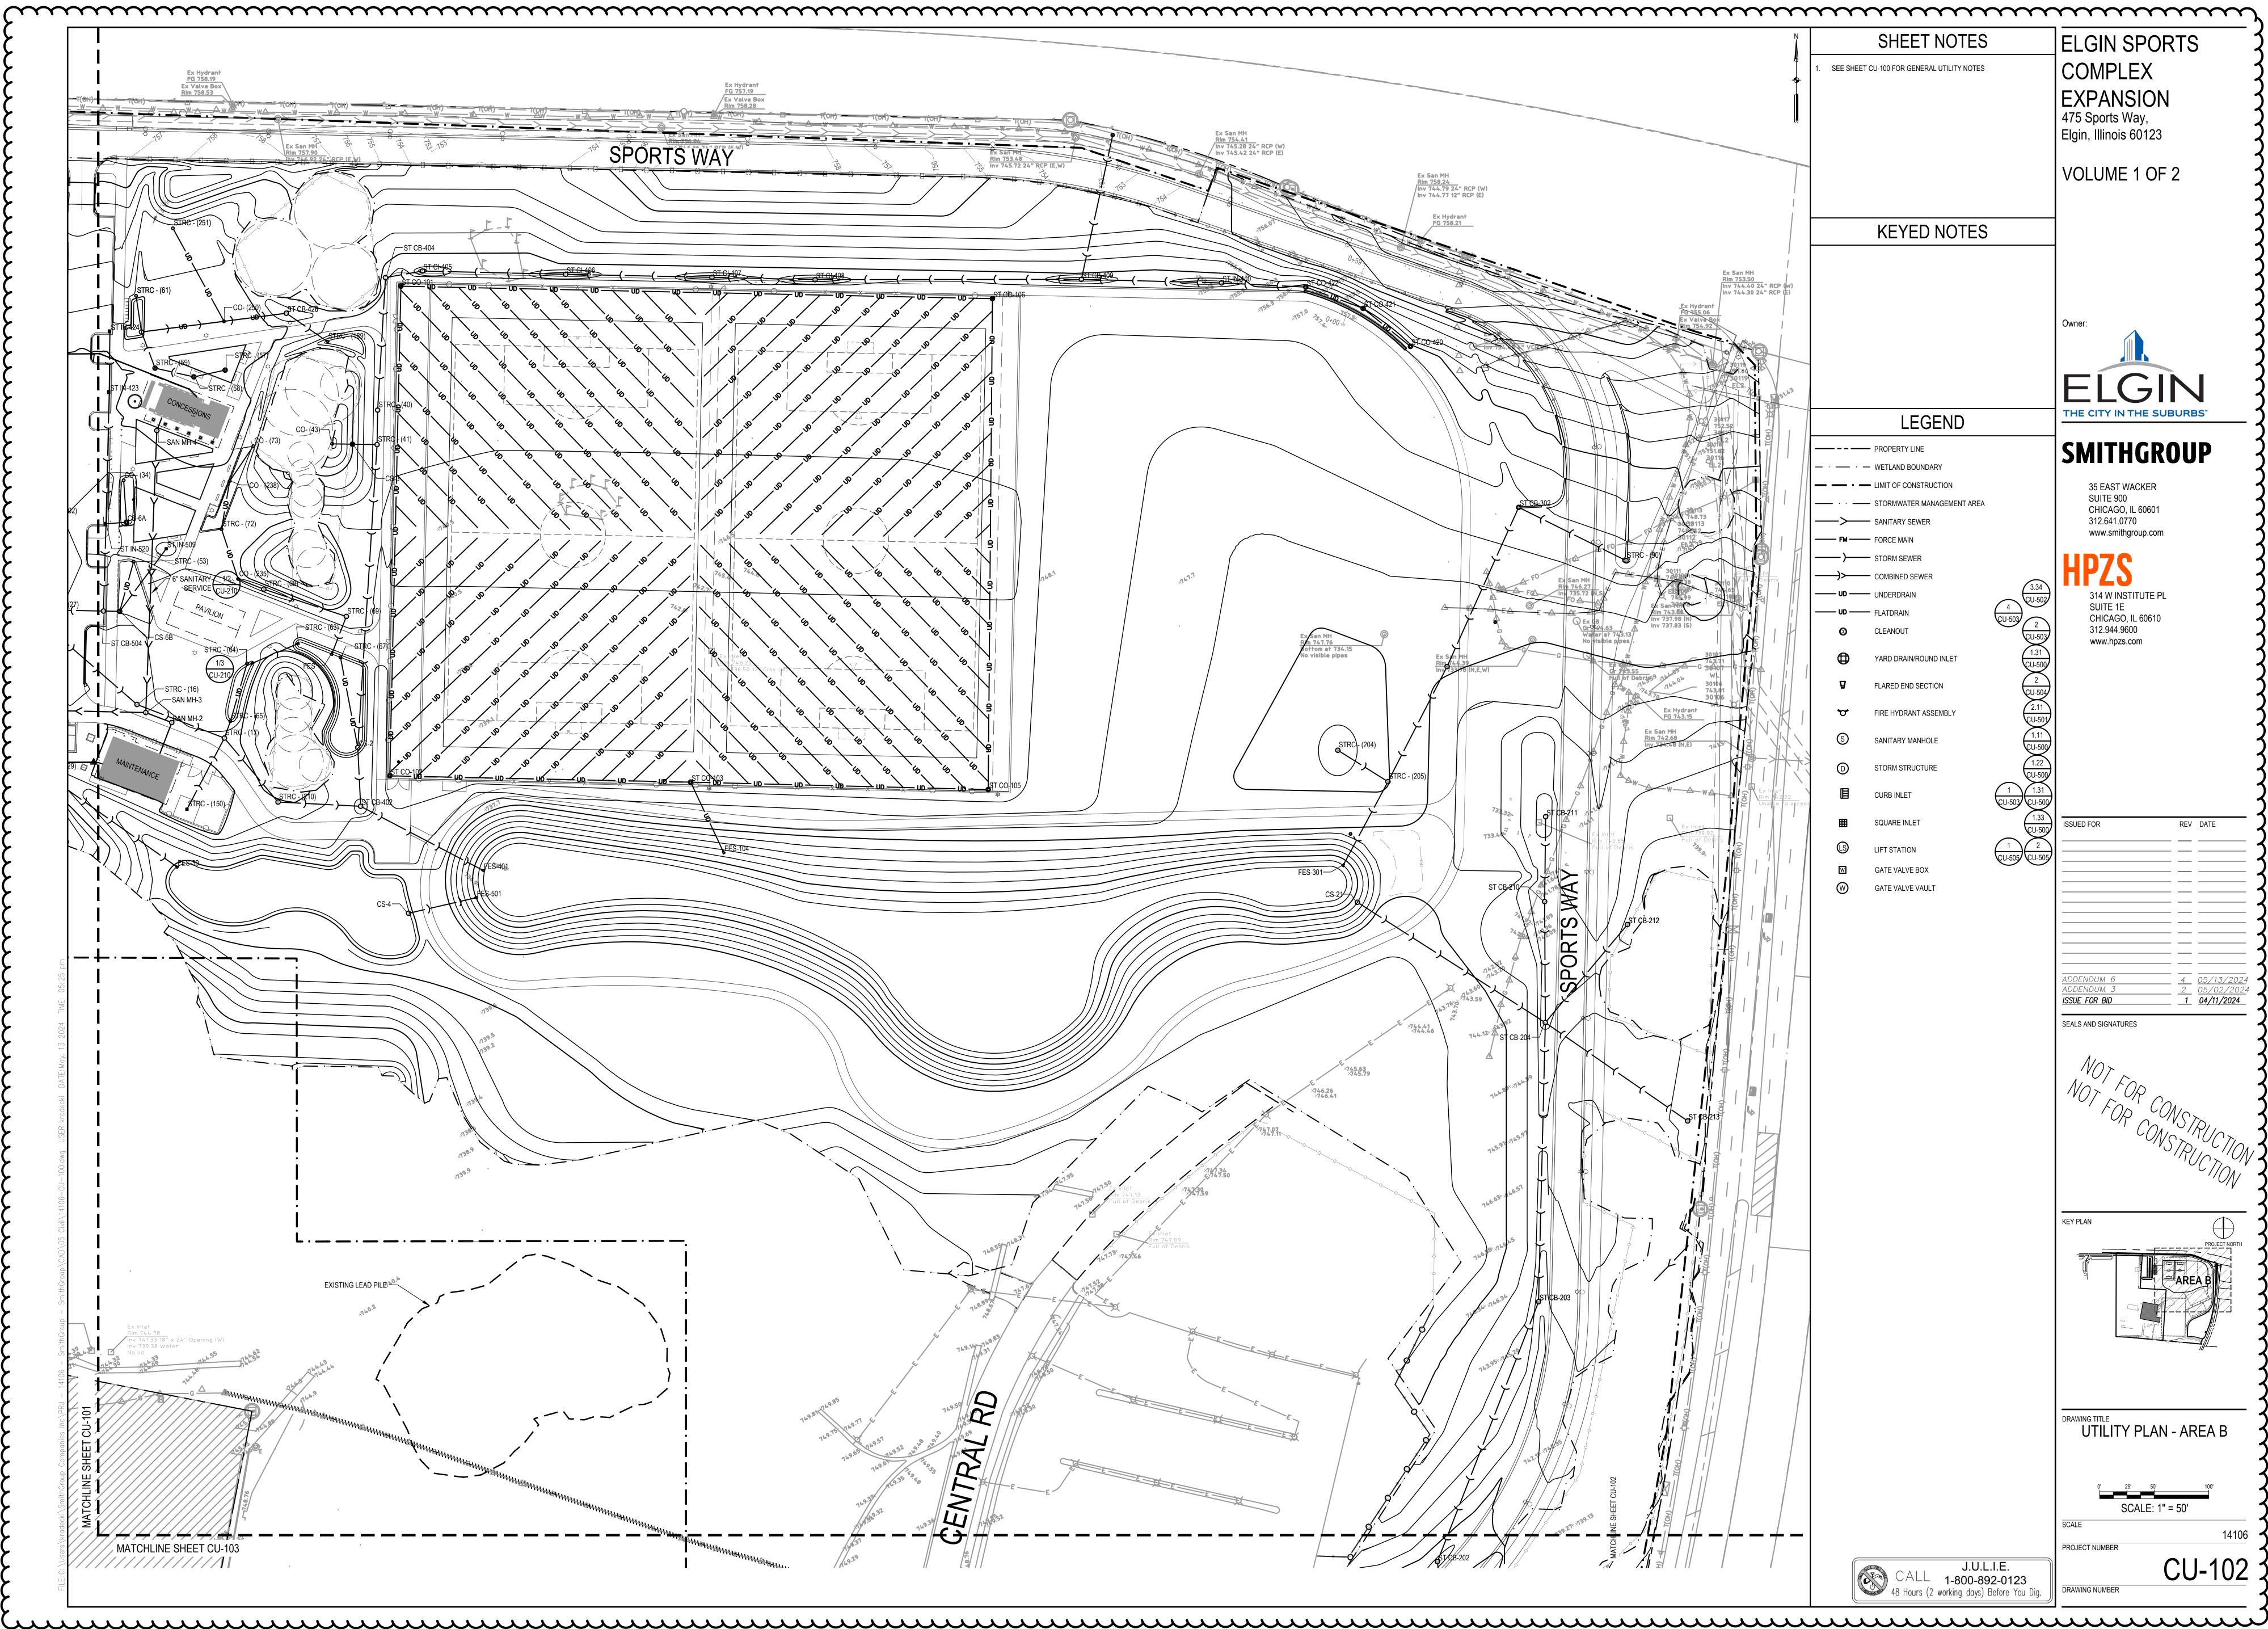

uuuuuuuuuuuu

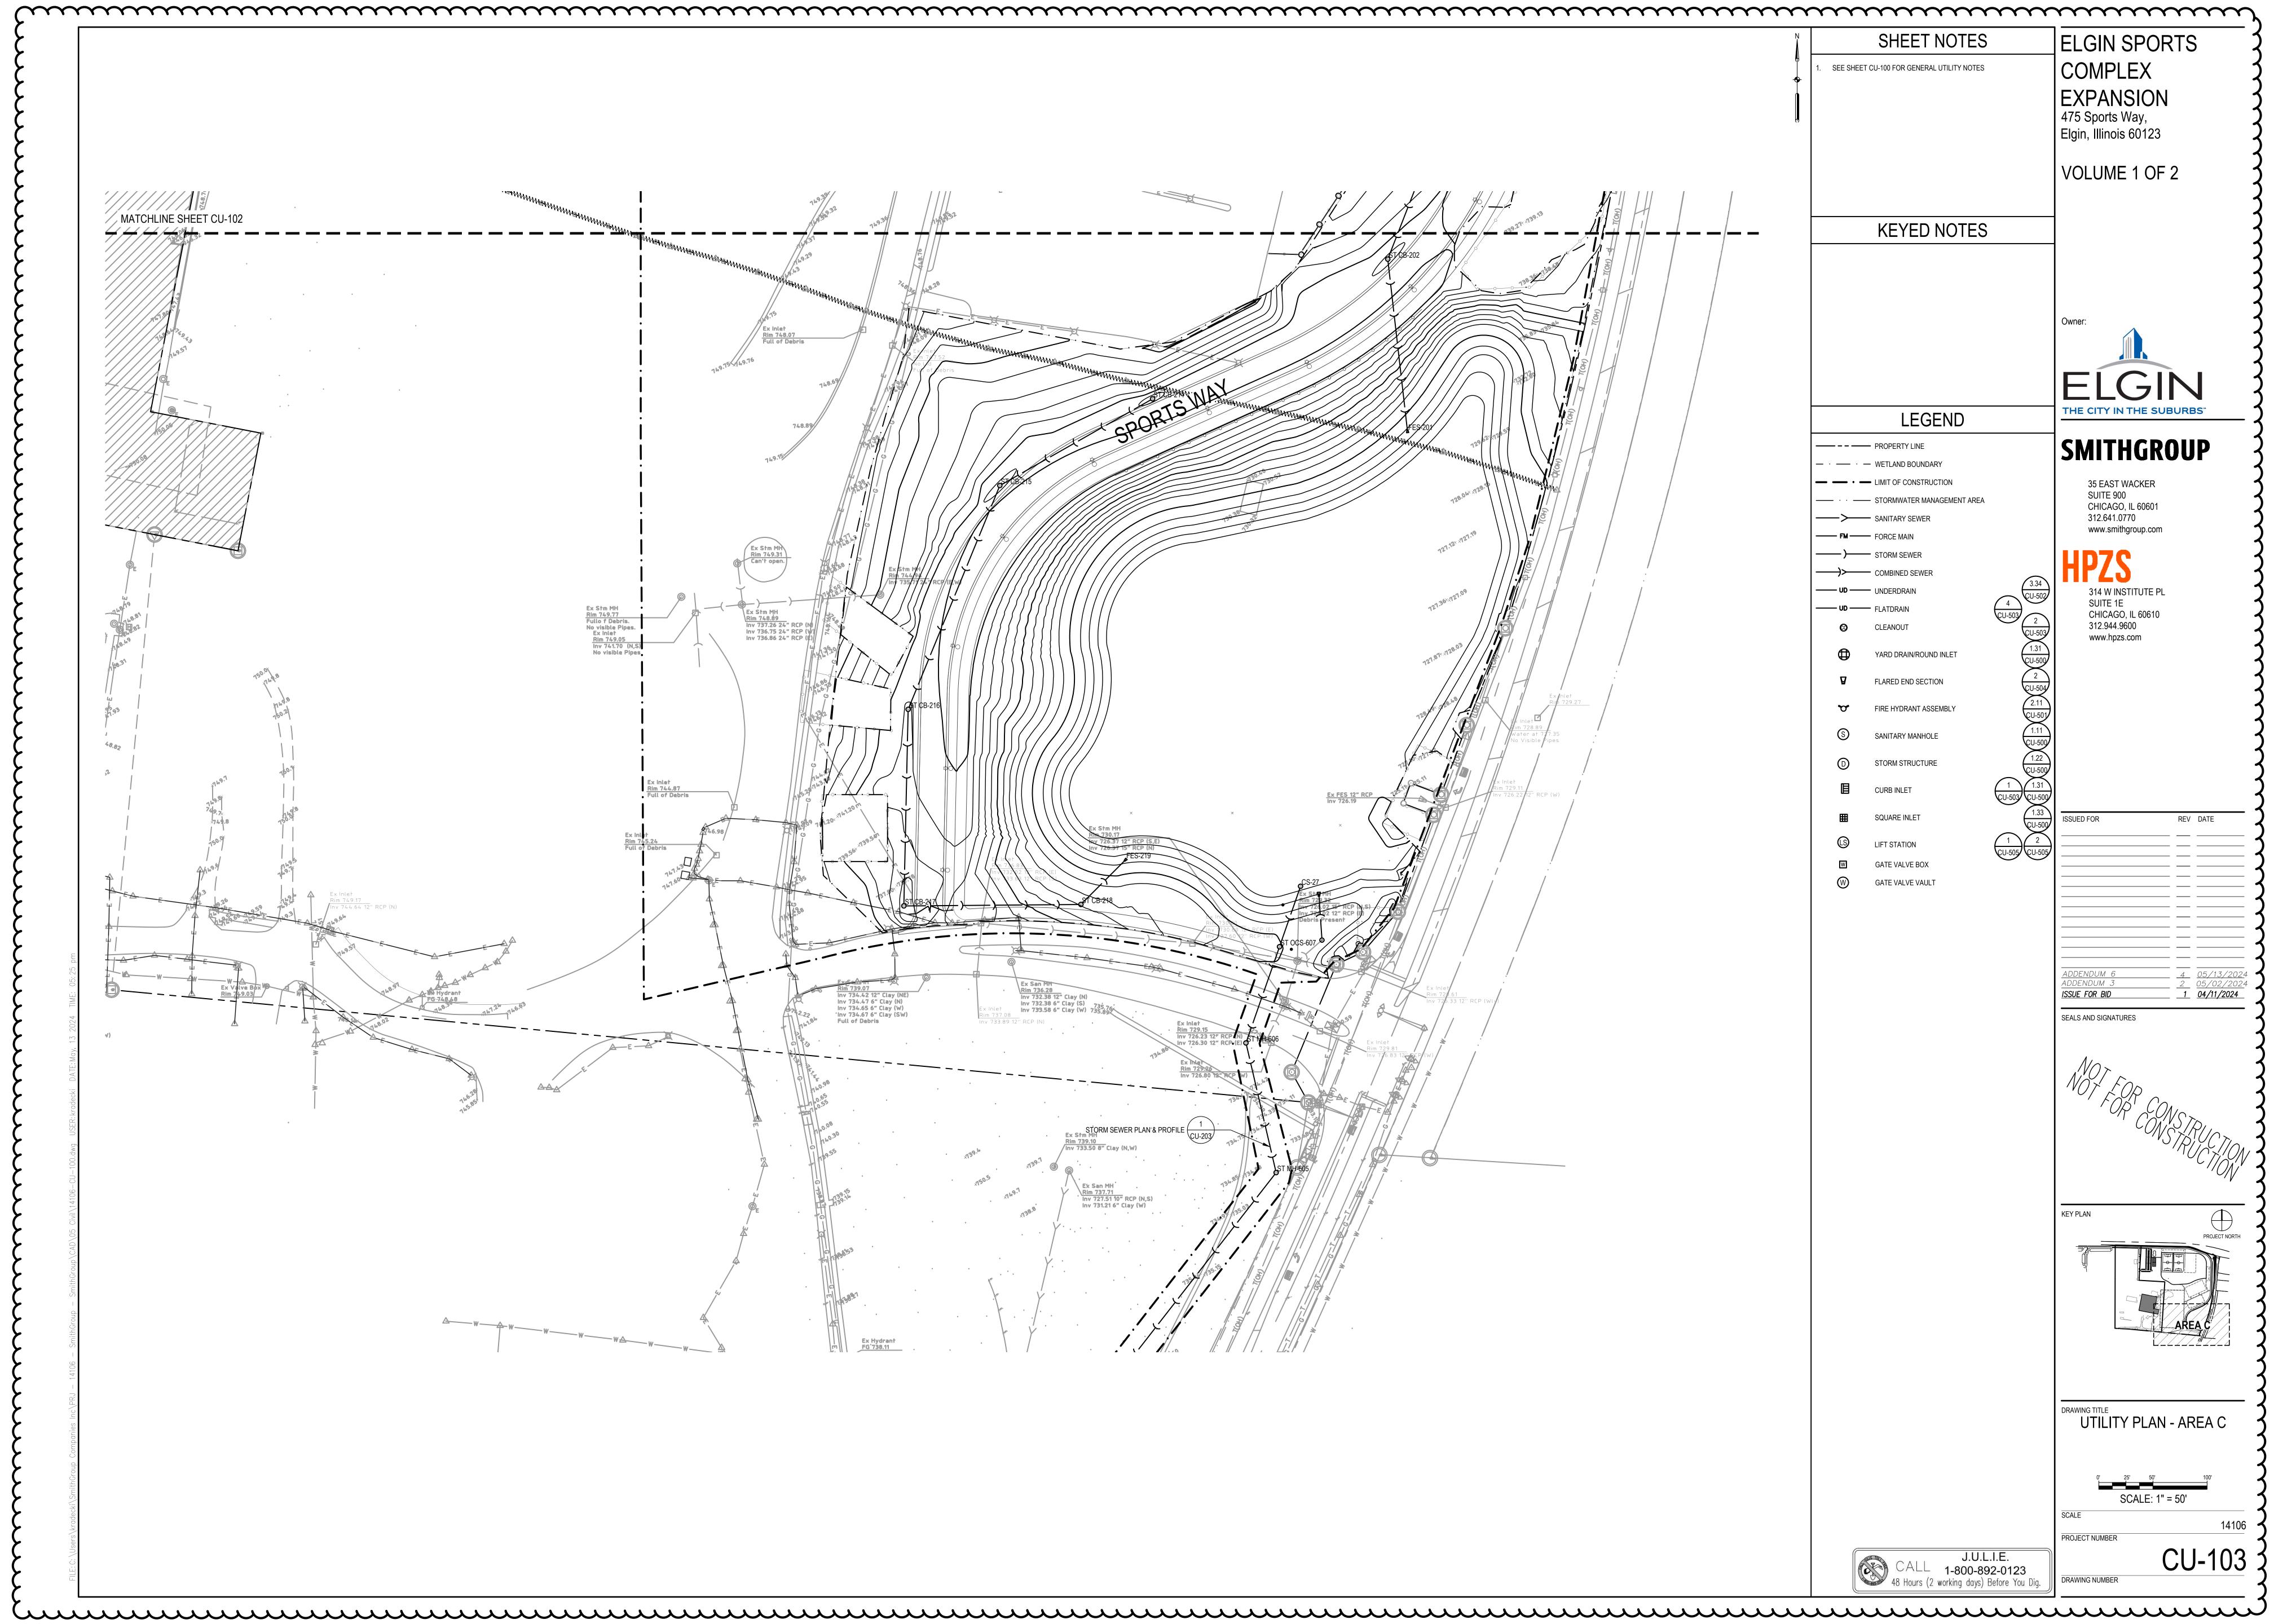


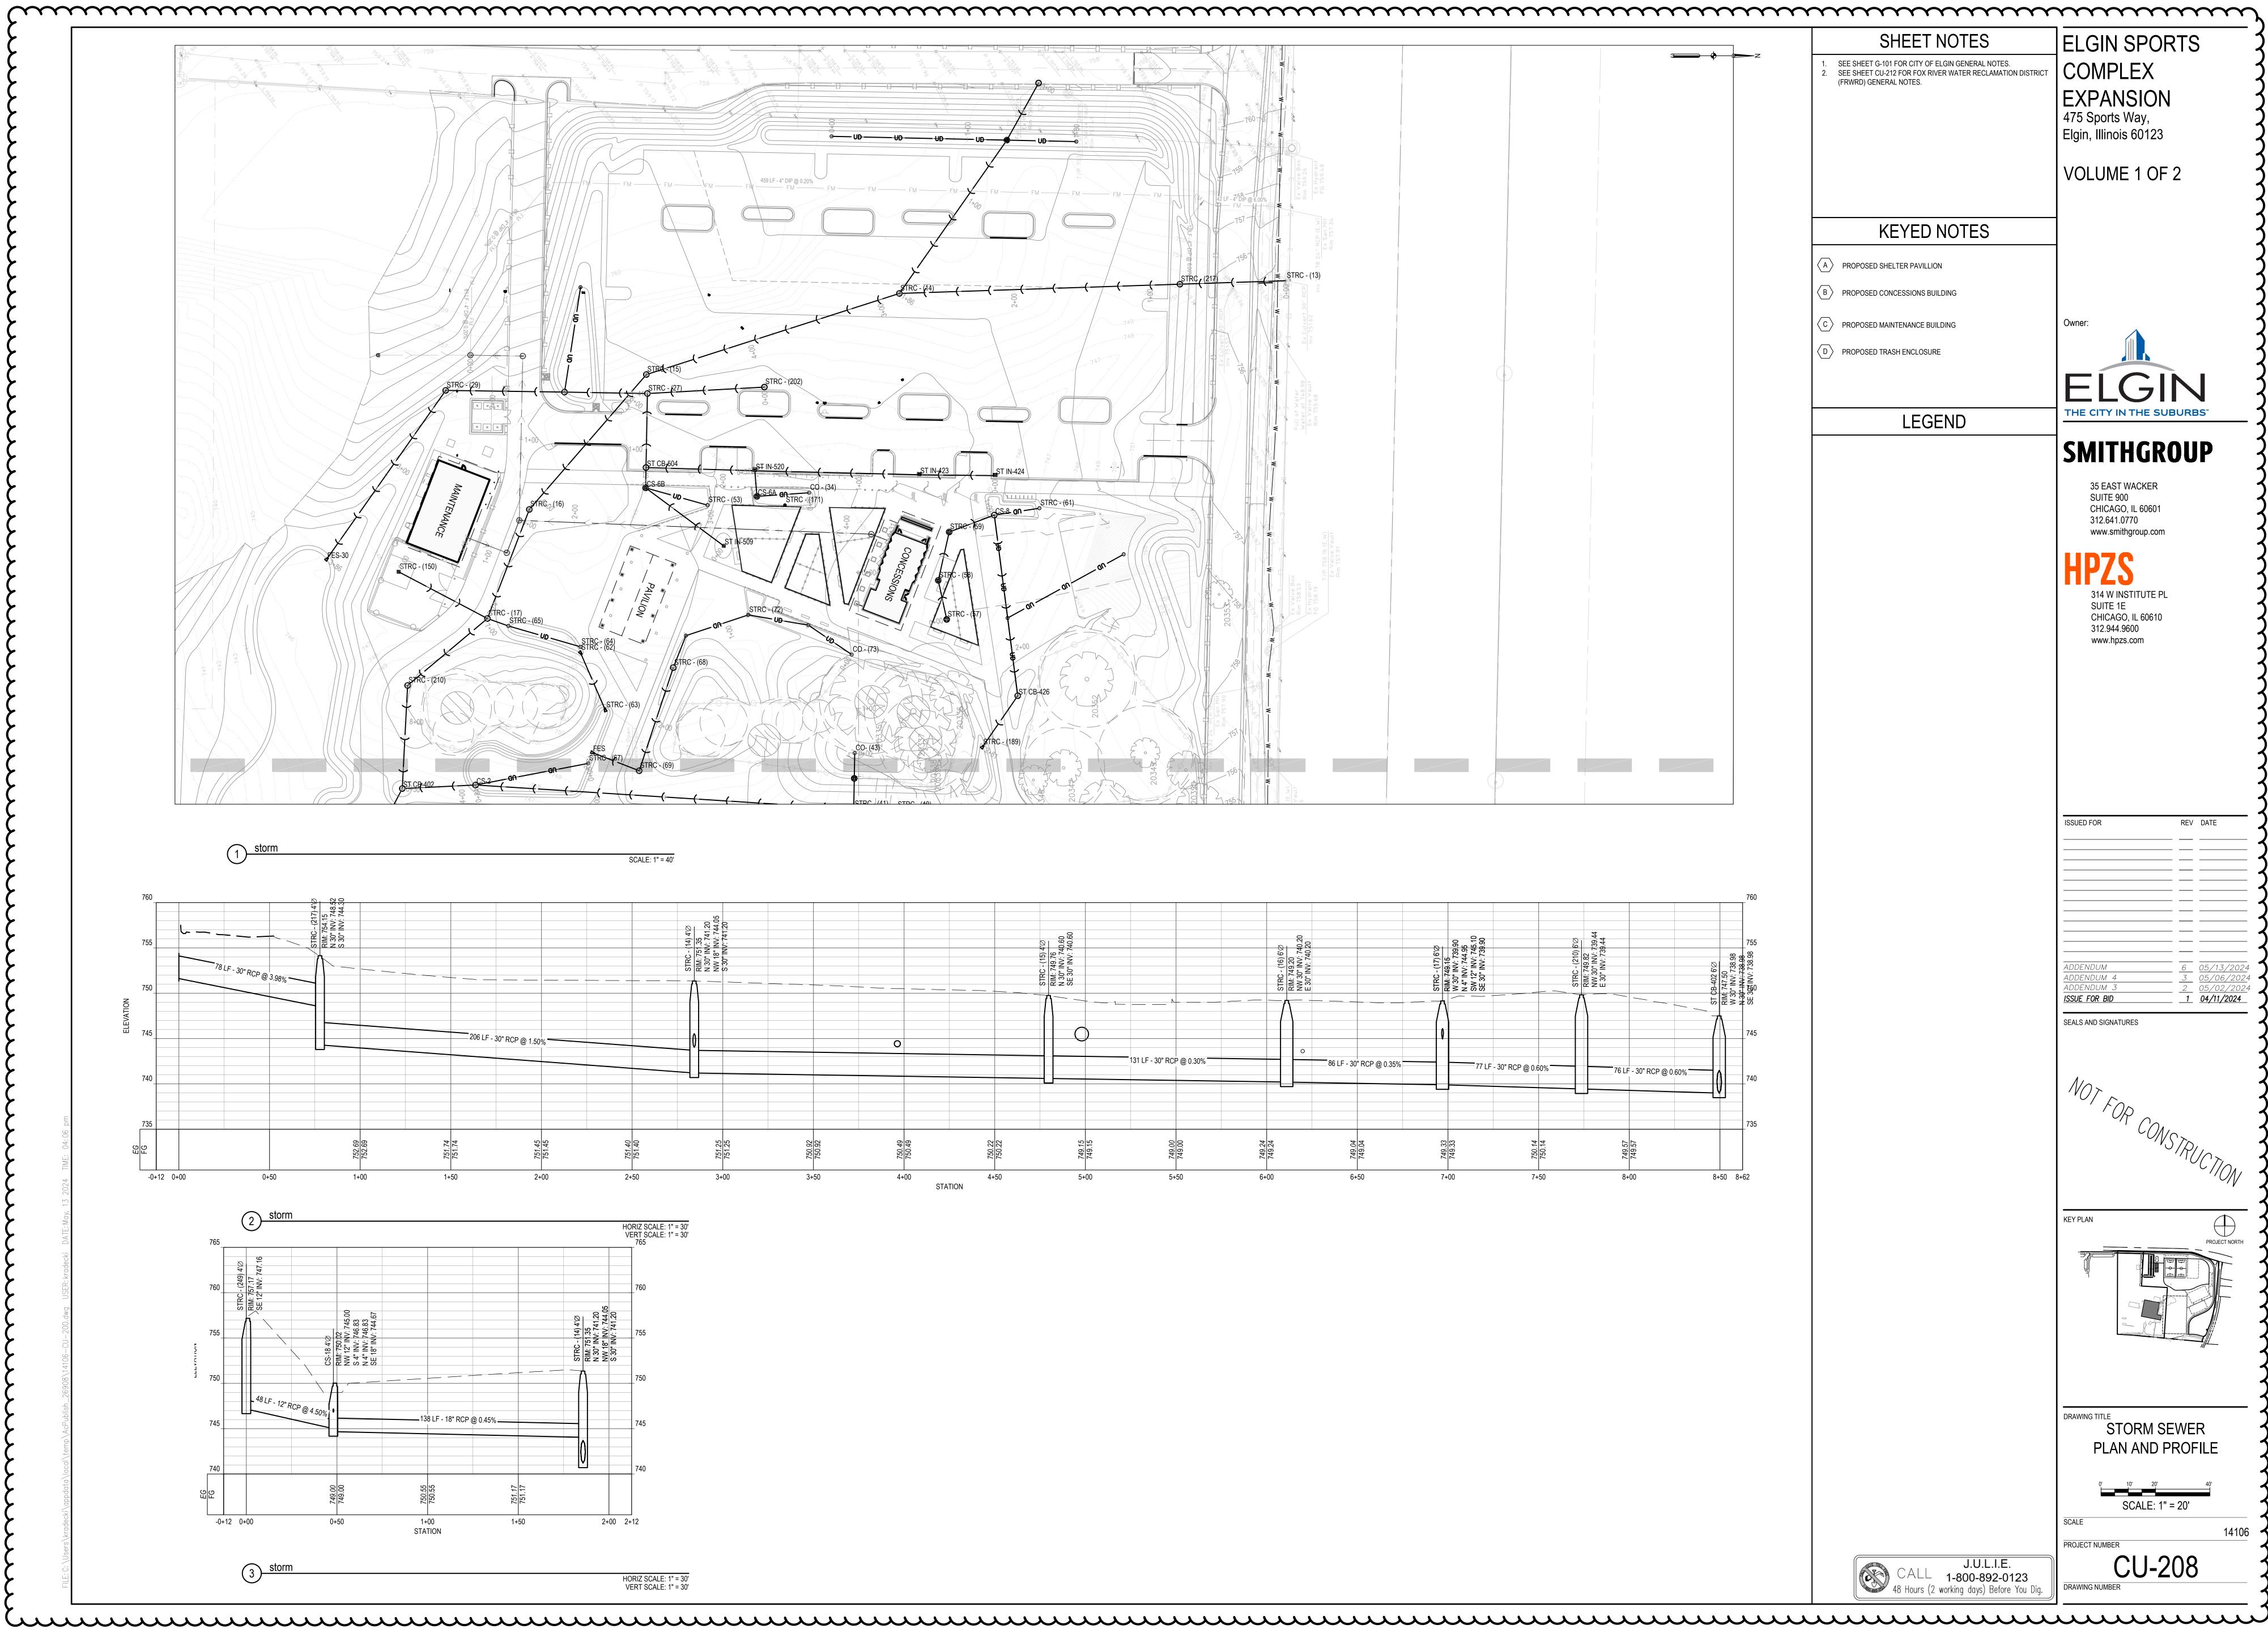


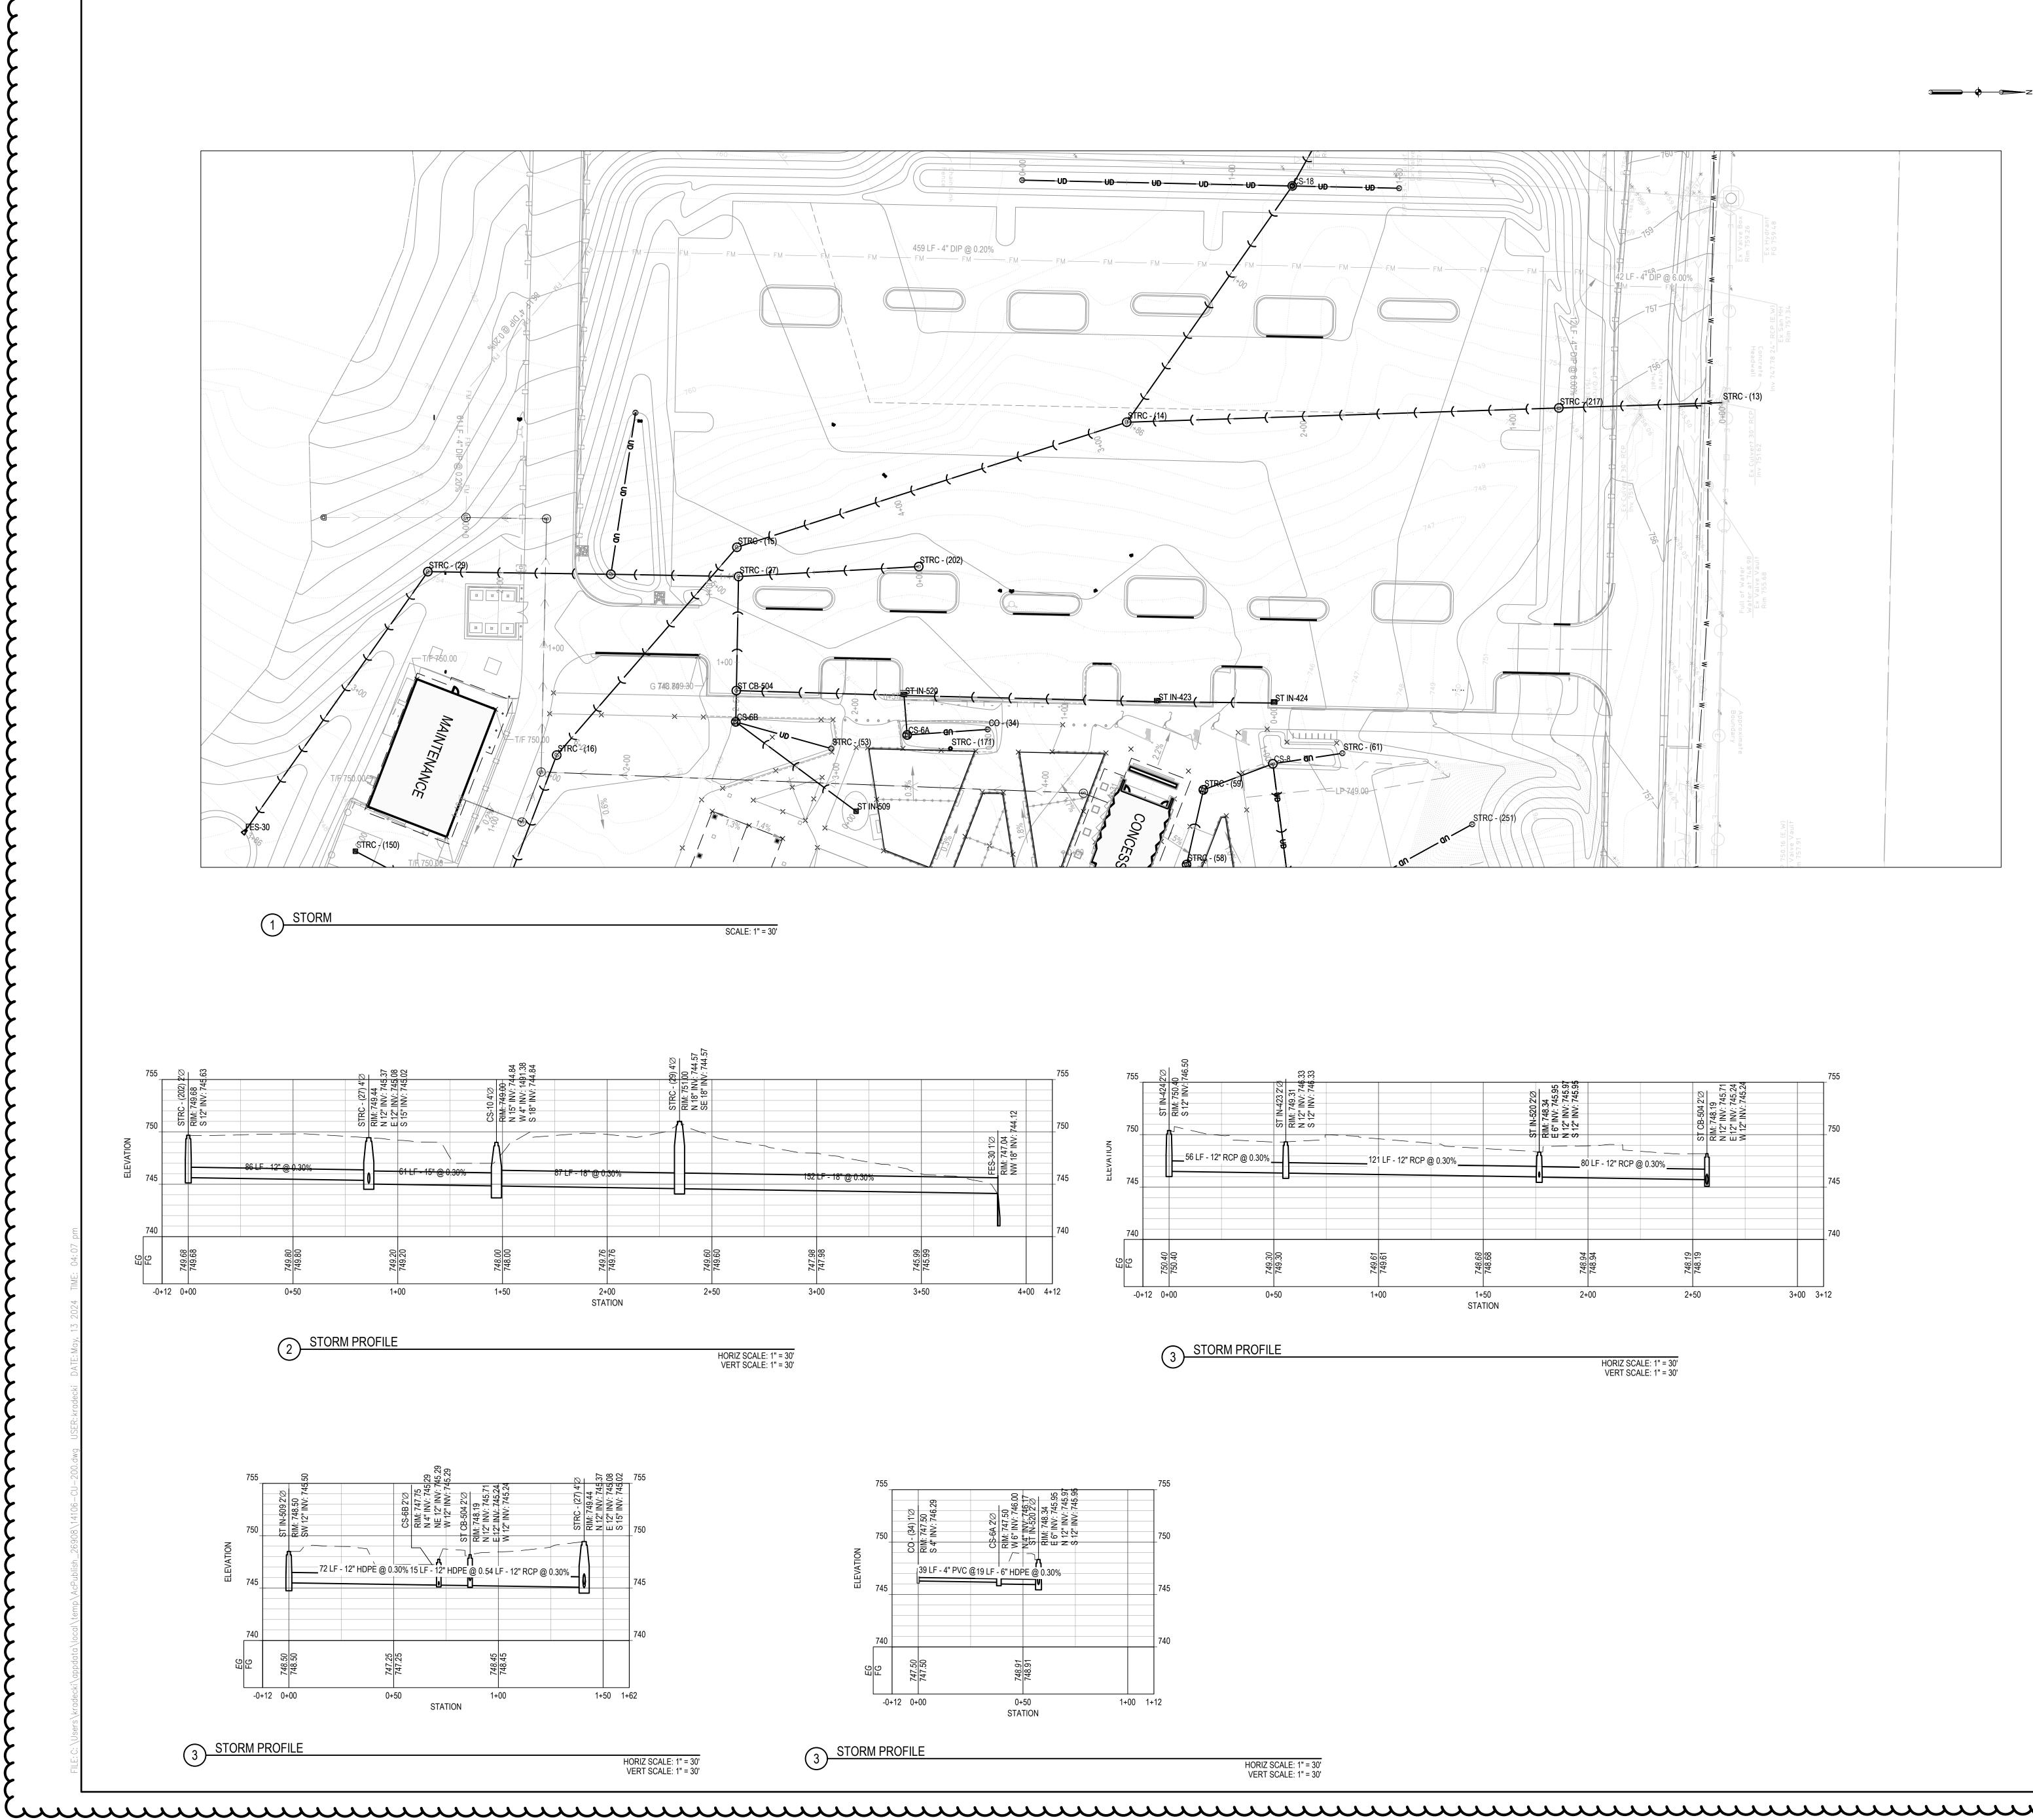







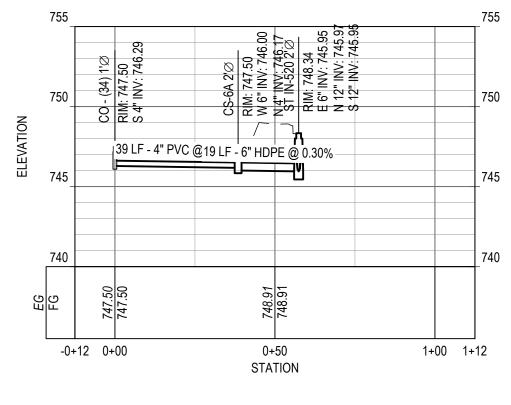

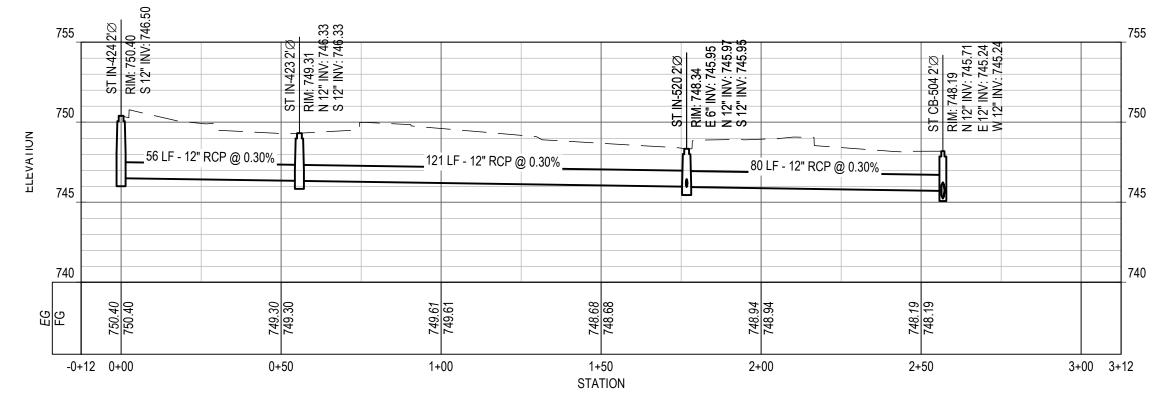

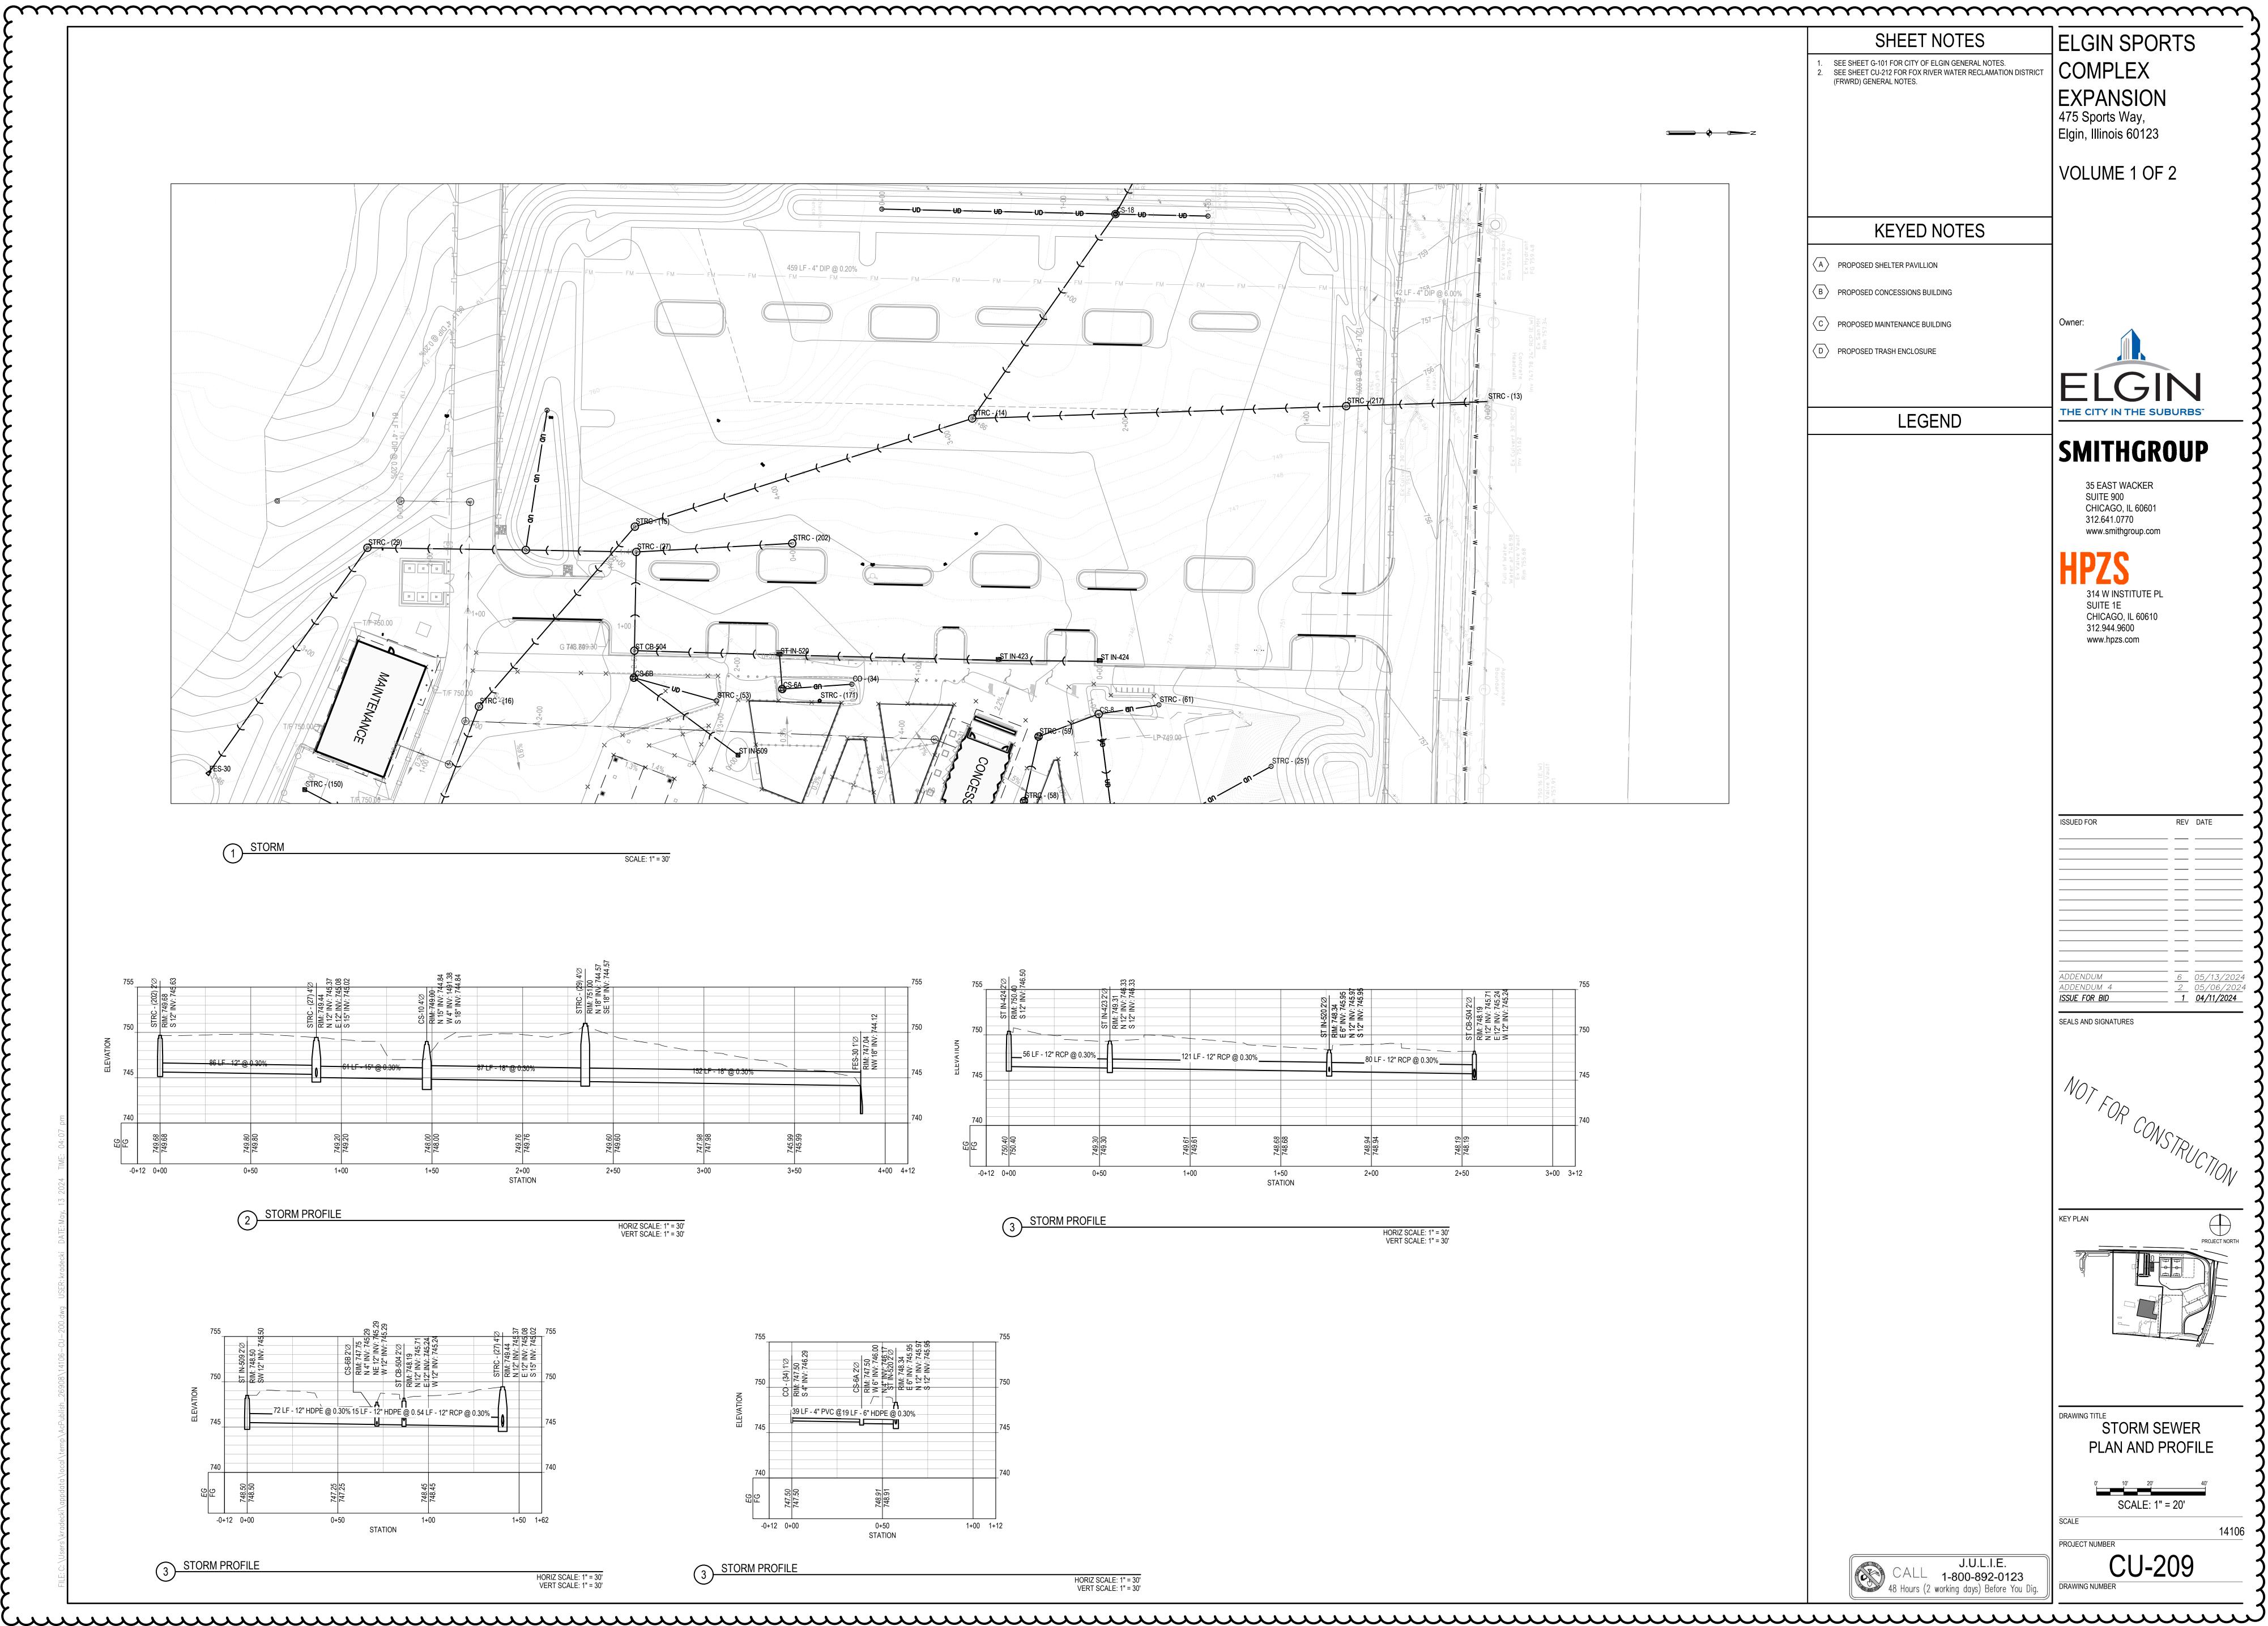


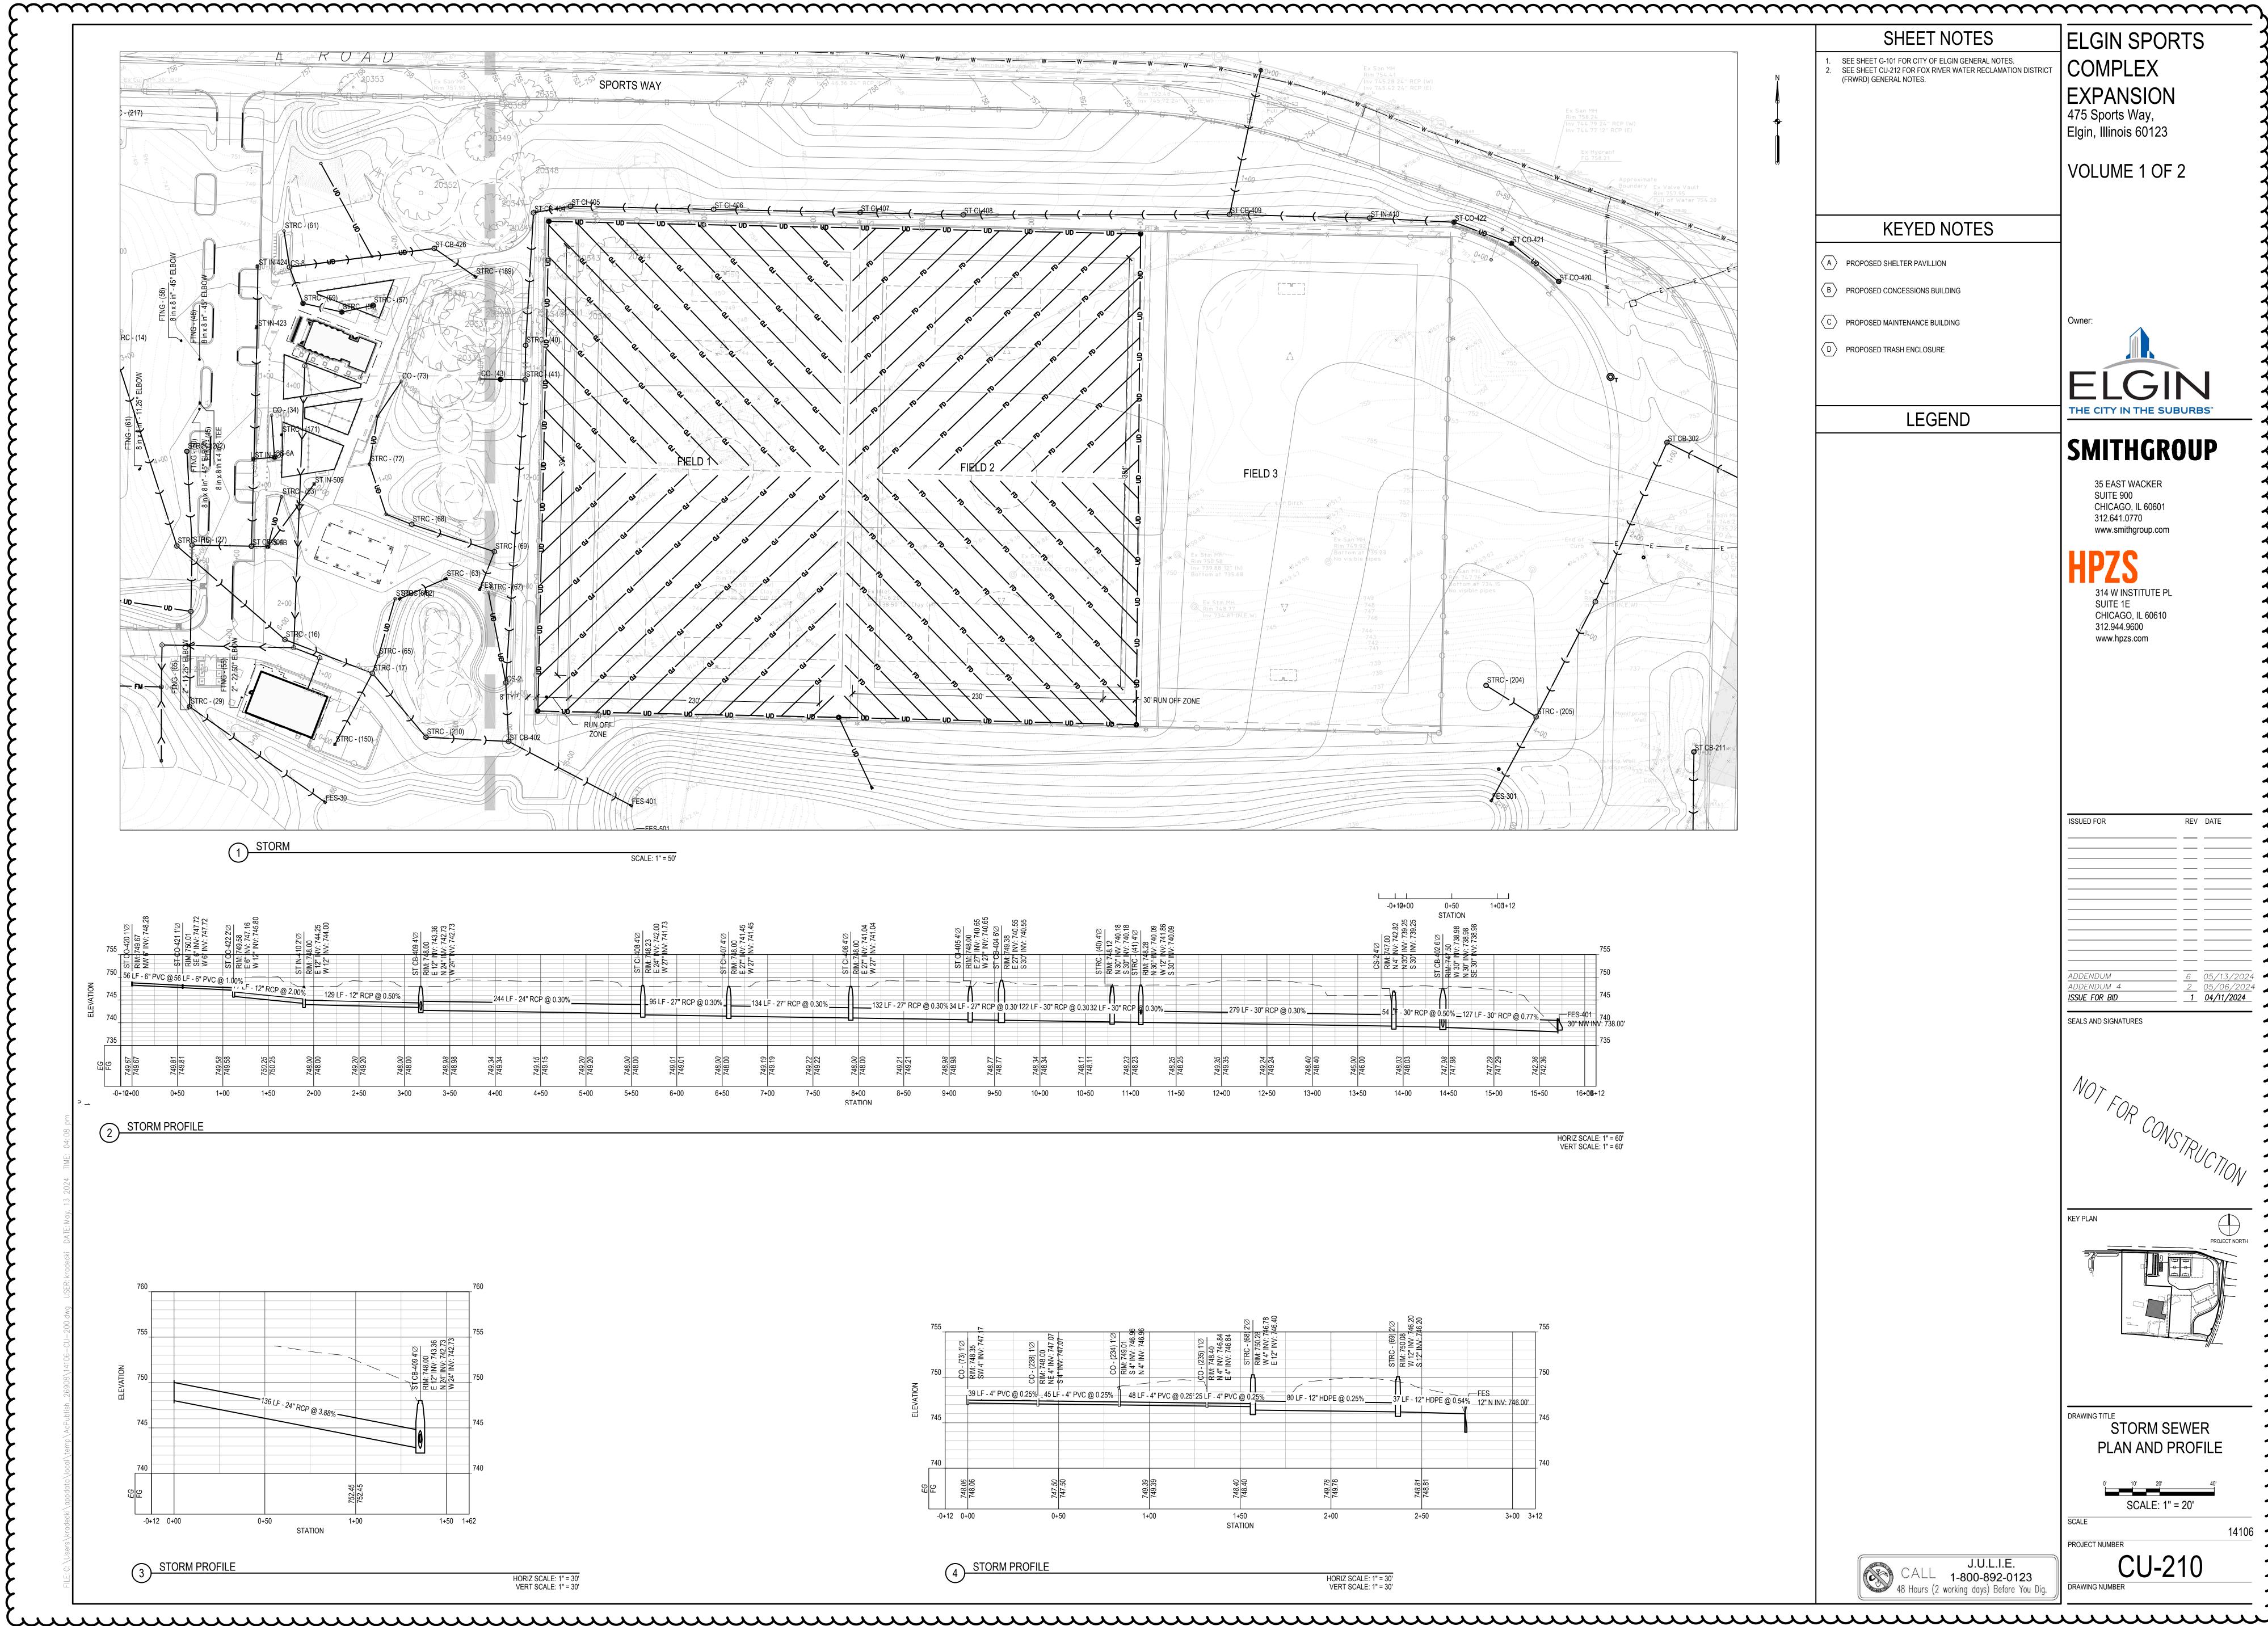



	SHEET NOTES
1. 2.	SEE SHEET G-101 FOR CITY OF ELGIN GENERAL NOTES. SEE SHEET CU-212 FOR FOX RIVER WATER RECLAMATION DIST (FRWRD) GENERAL NOTES.
	KEYED NOTES
A	PROPOSED SHELTER PAVILLION
В	PROPOSED CONCESSIONS BUILDING
C	PROPOSED MAINTENANCE BUILDING
D	PROPOSED TRASH ENCLOSURE


LEGEND


J.U.L.I.E. CALL 1-800-892-0123 48 Hours (2 working days) Before You Dig.

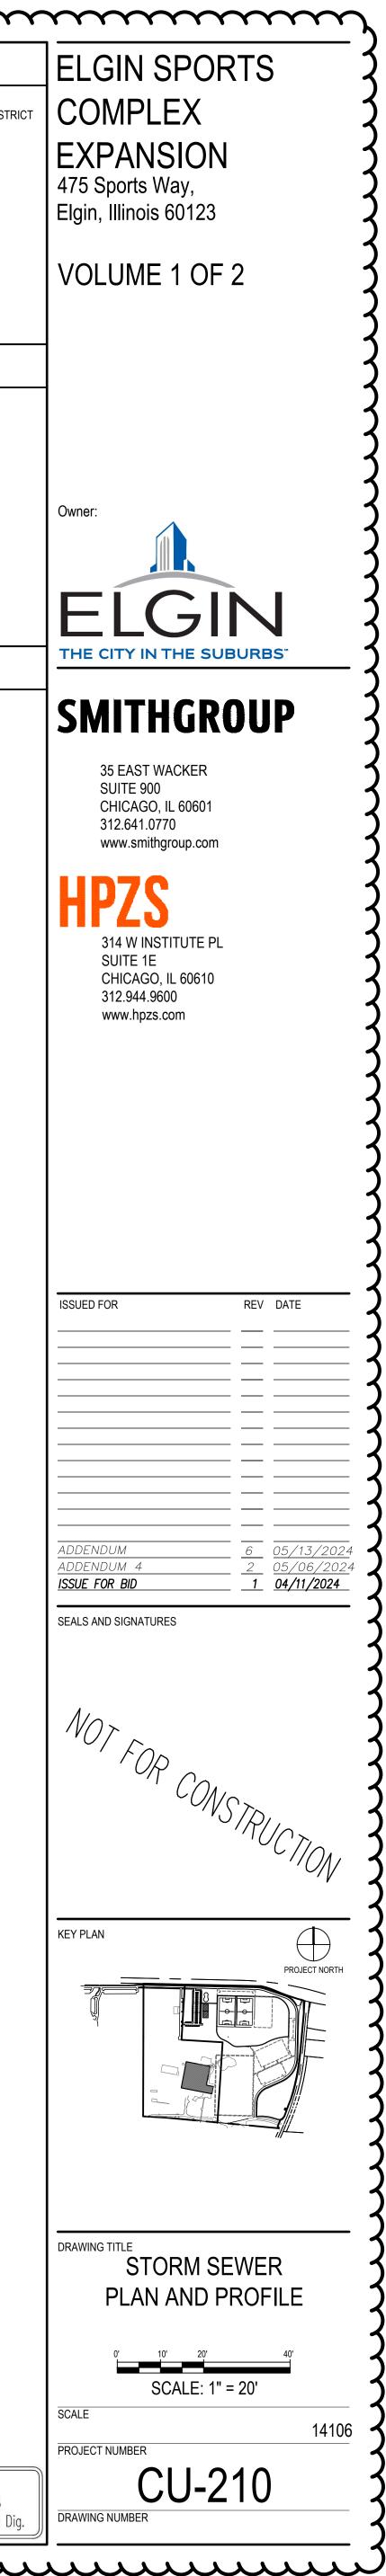

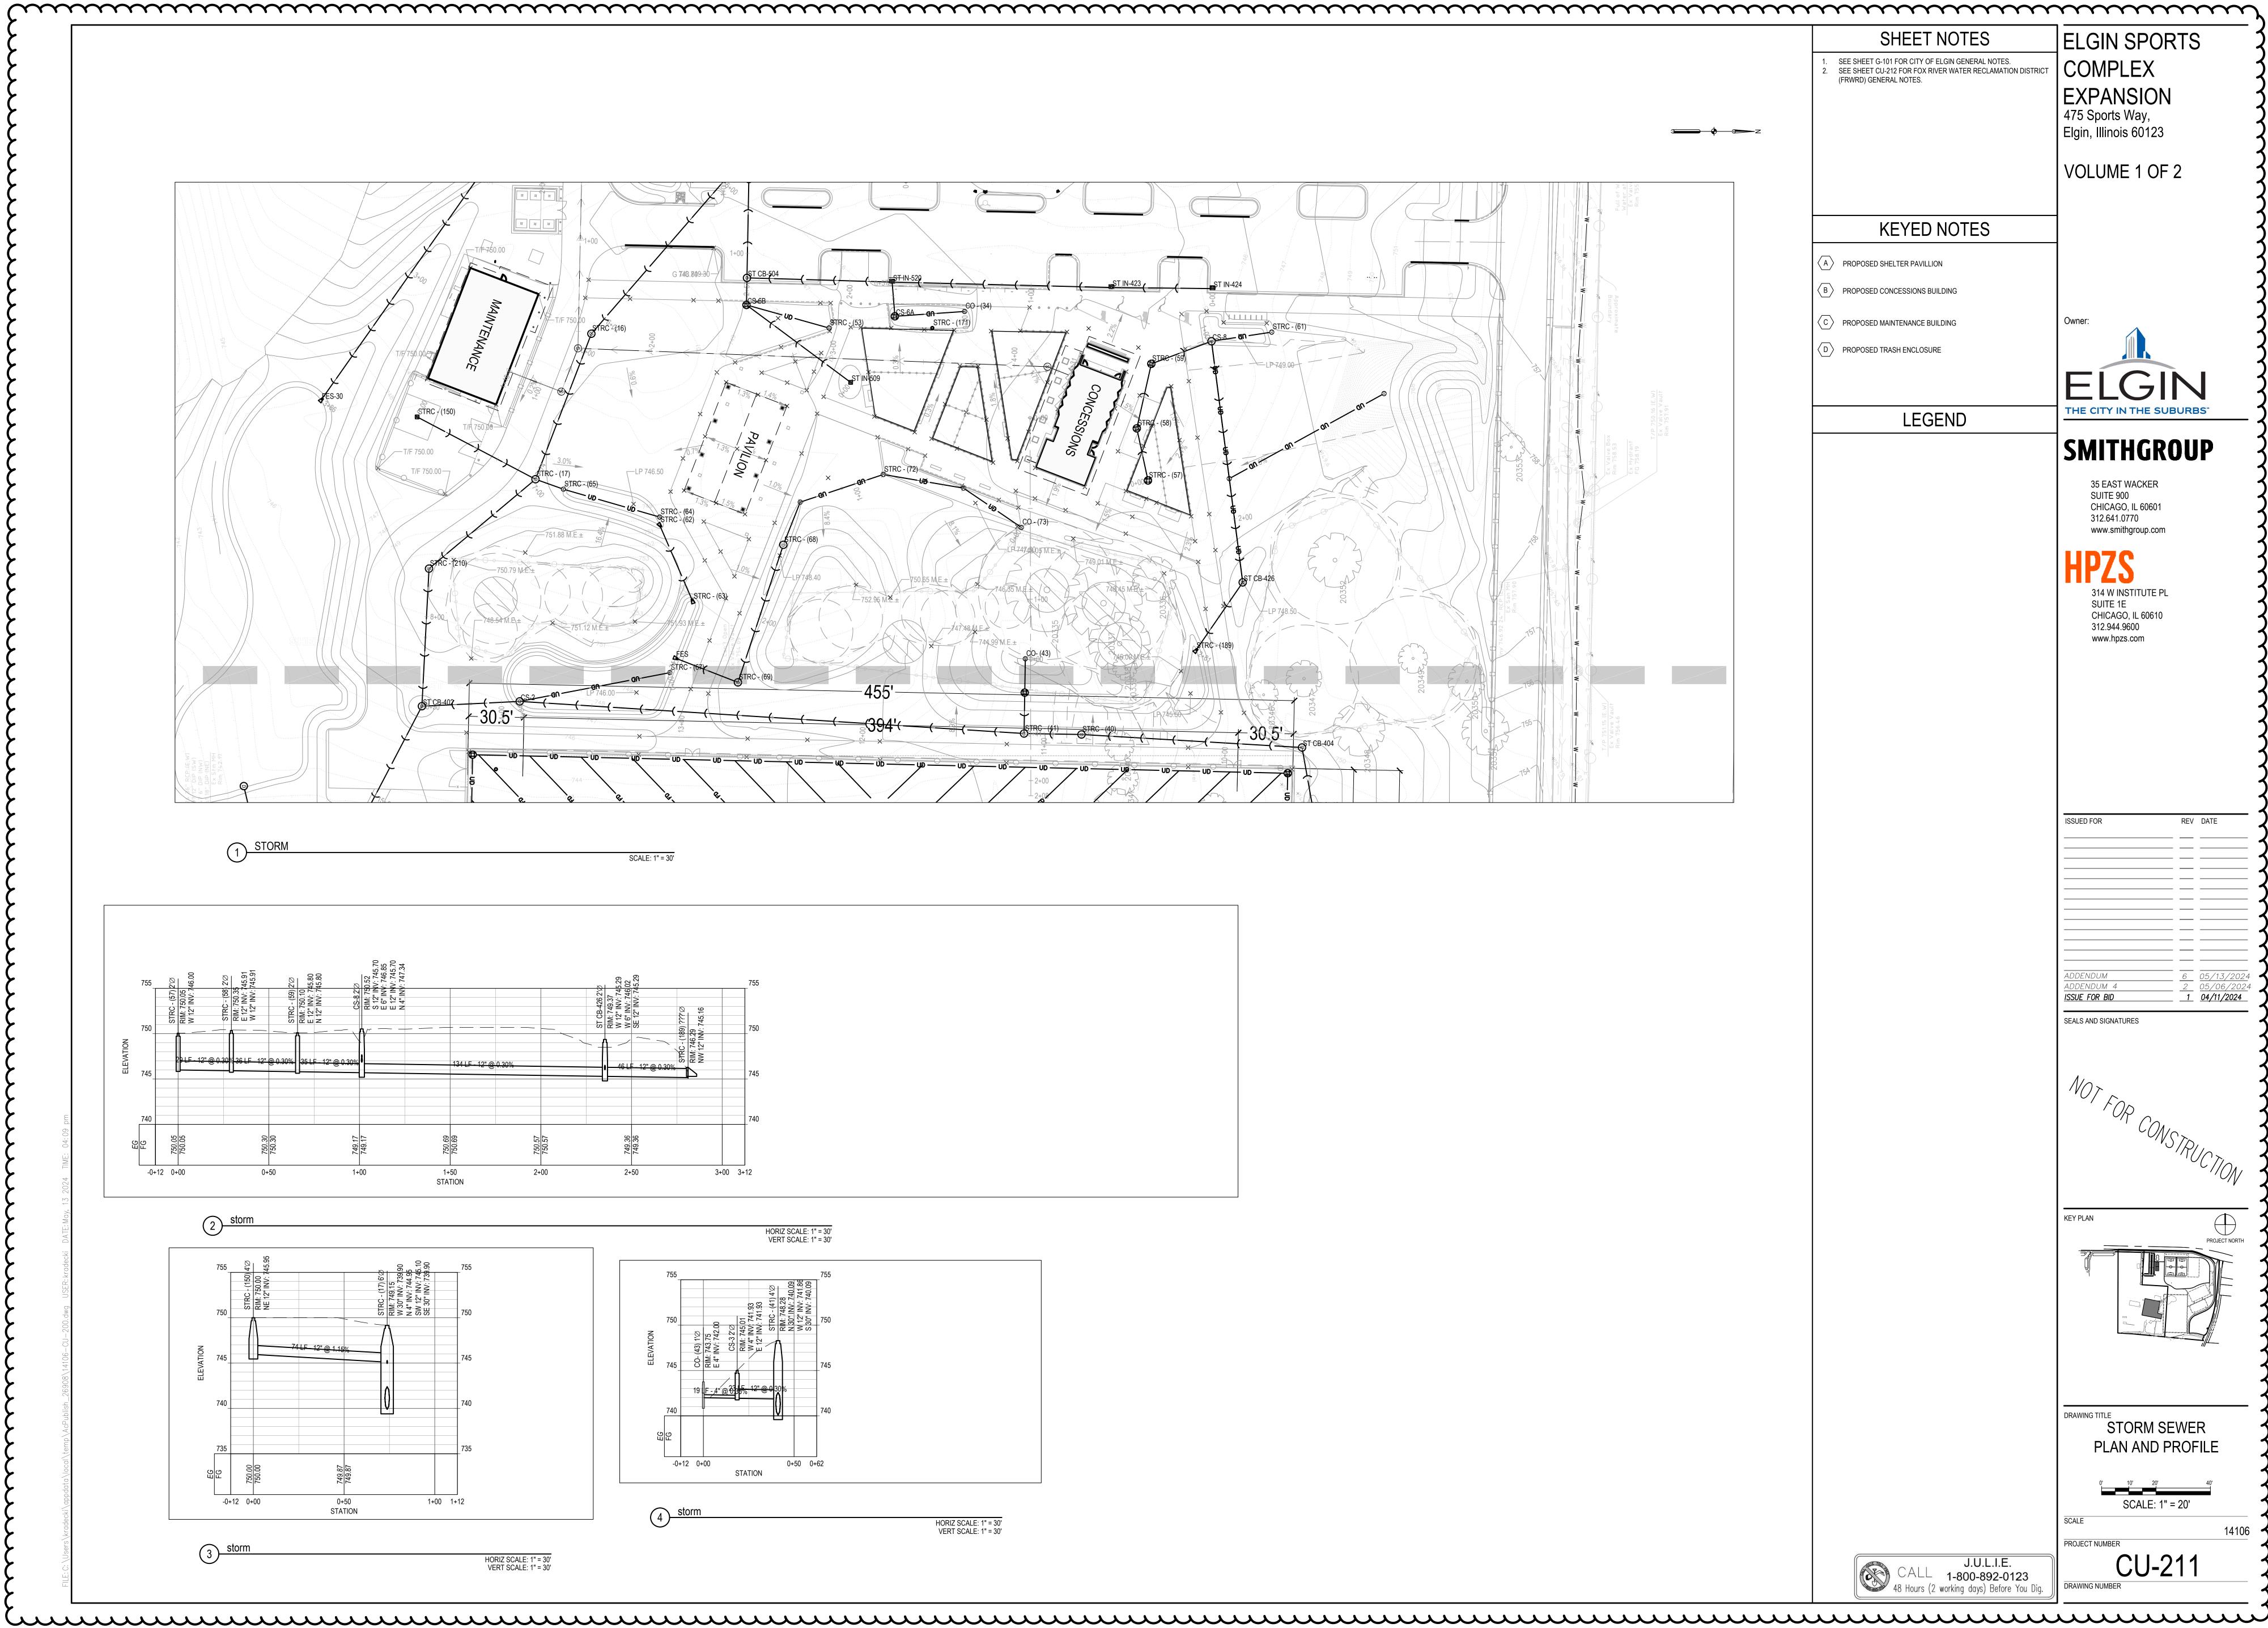

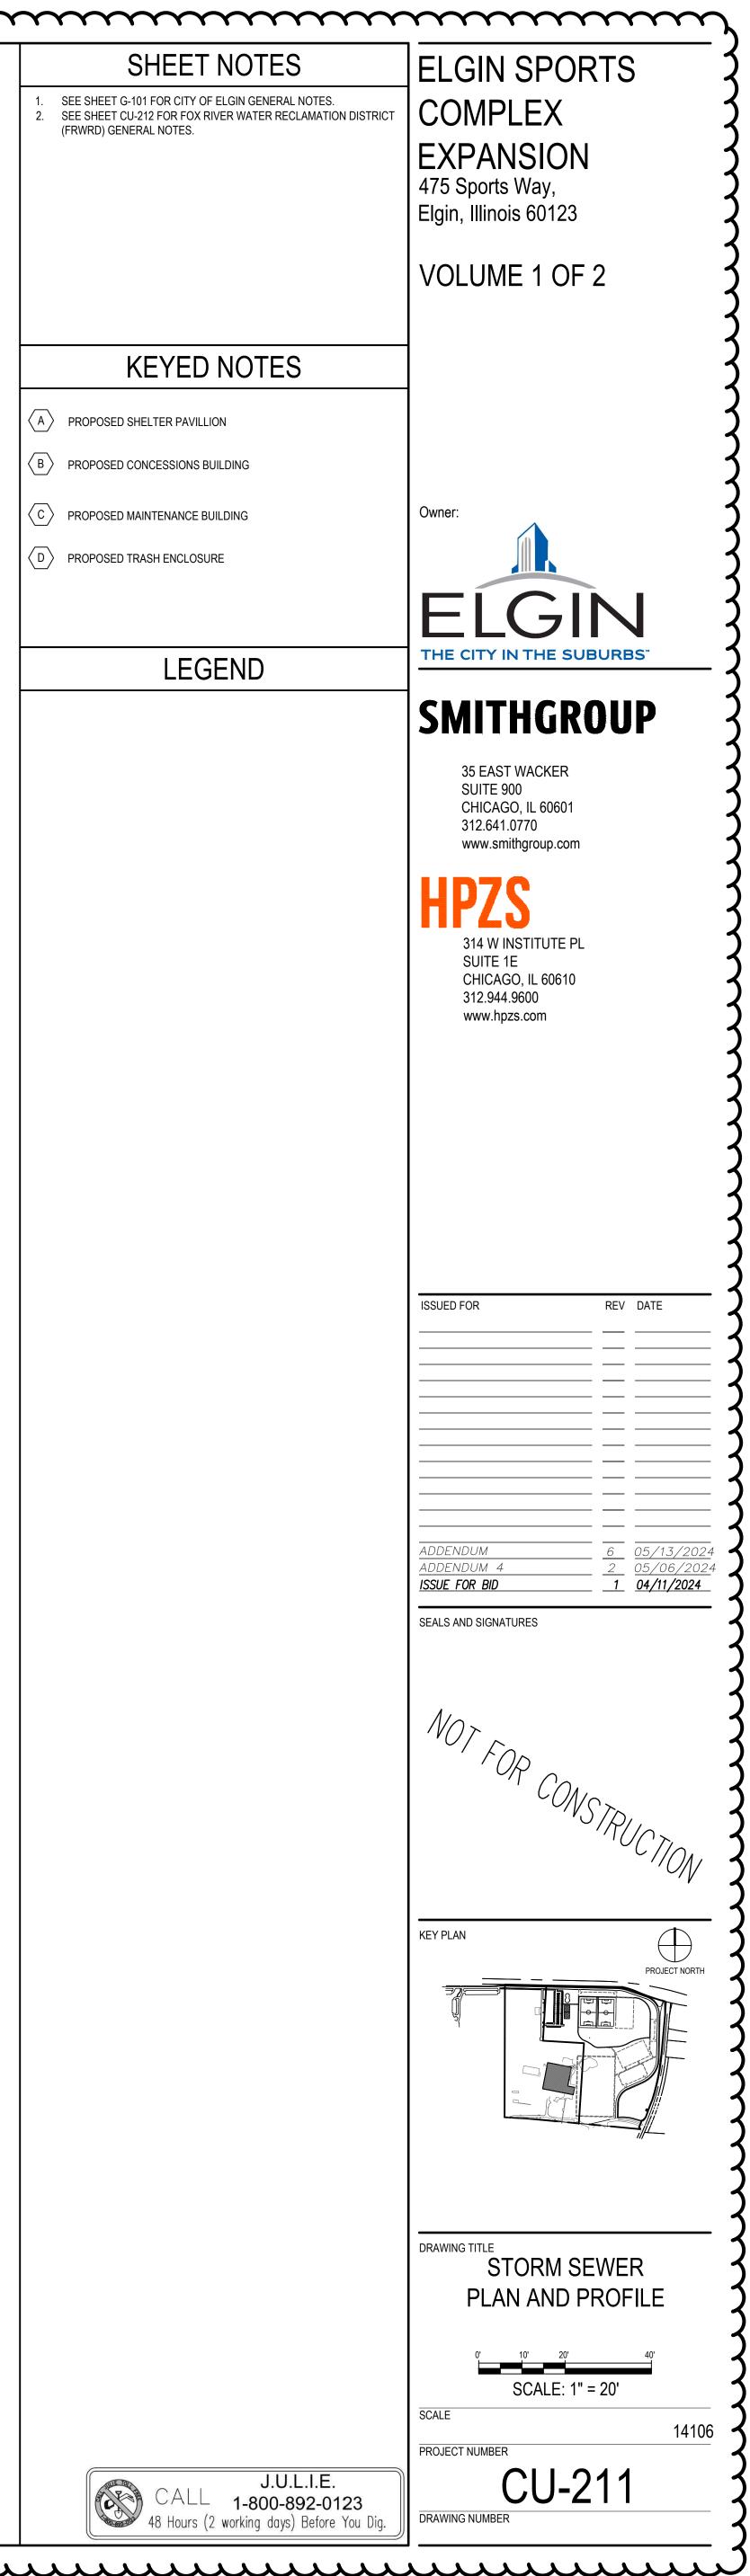

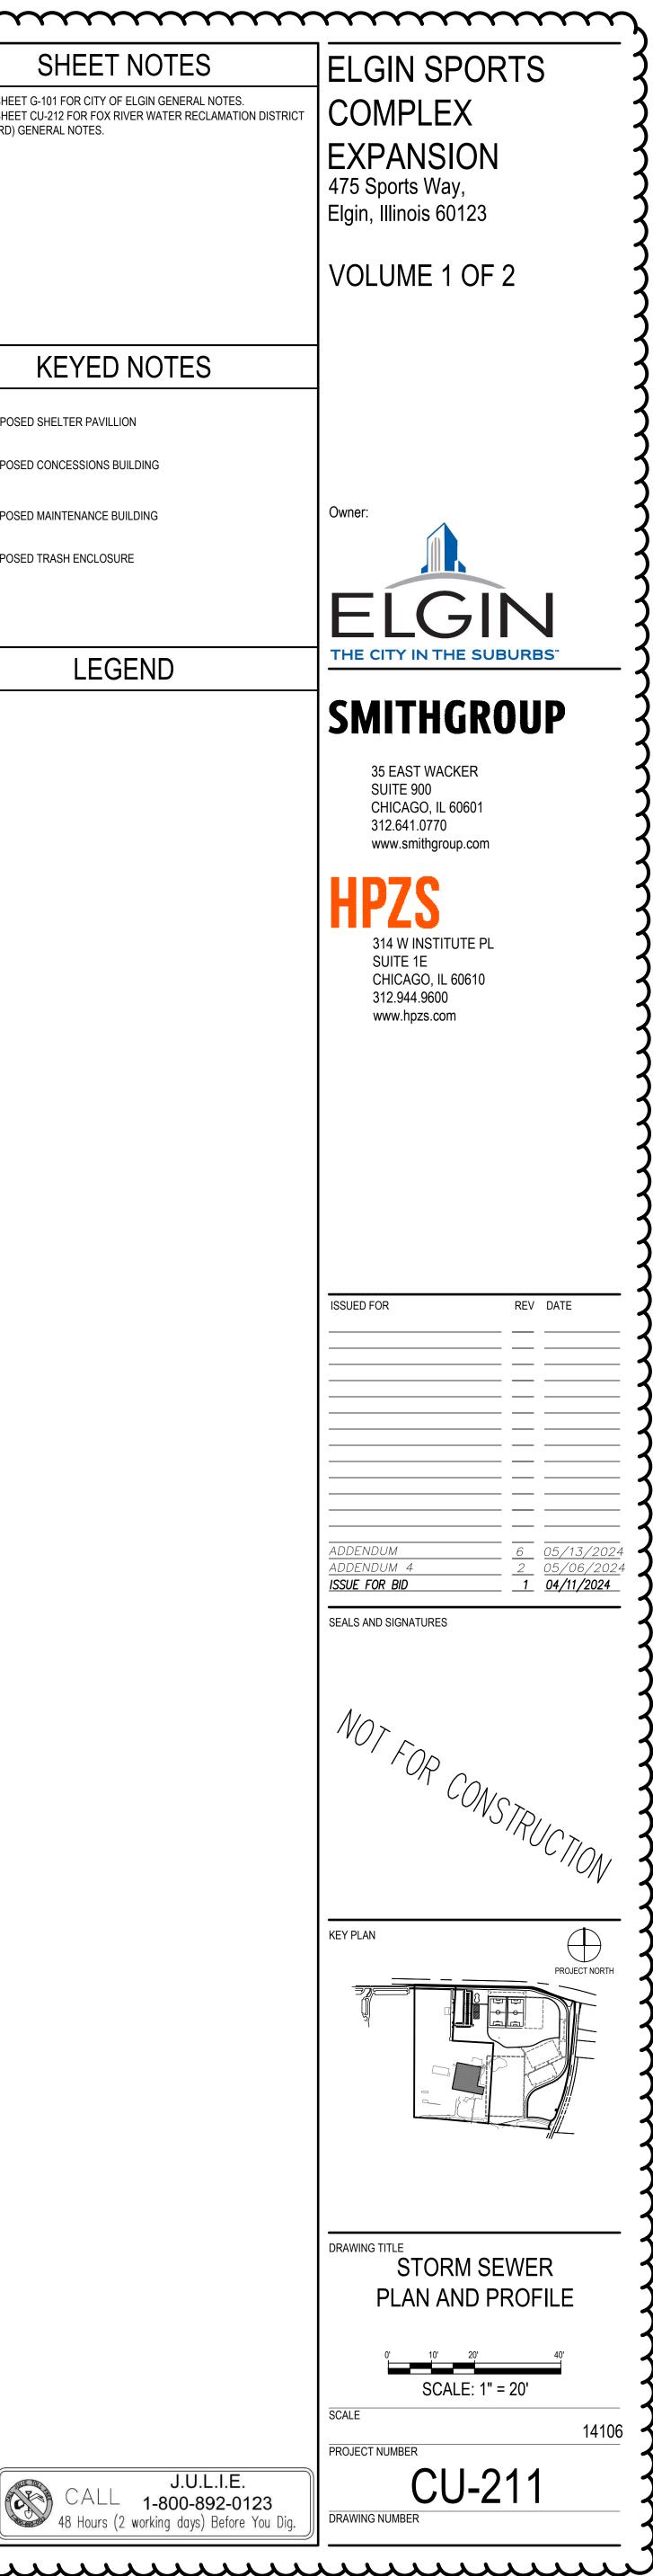


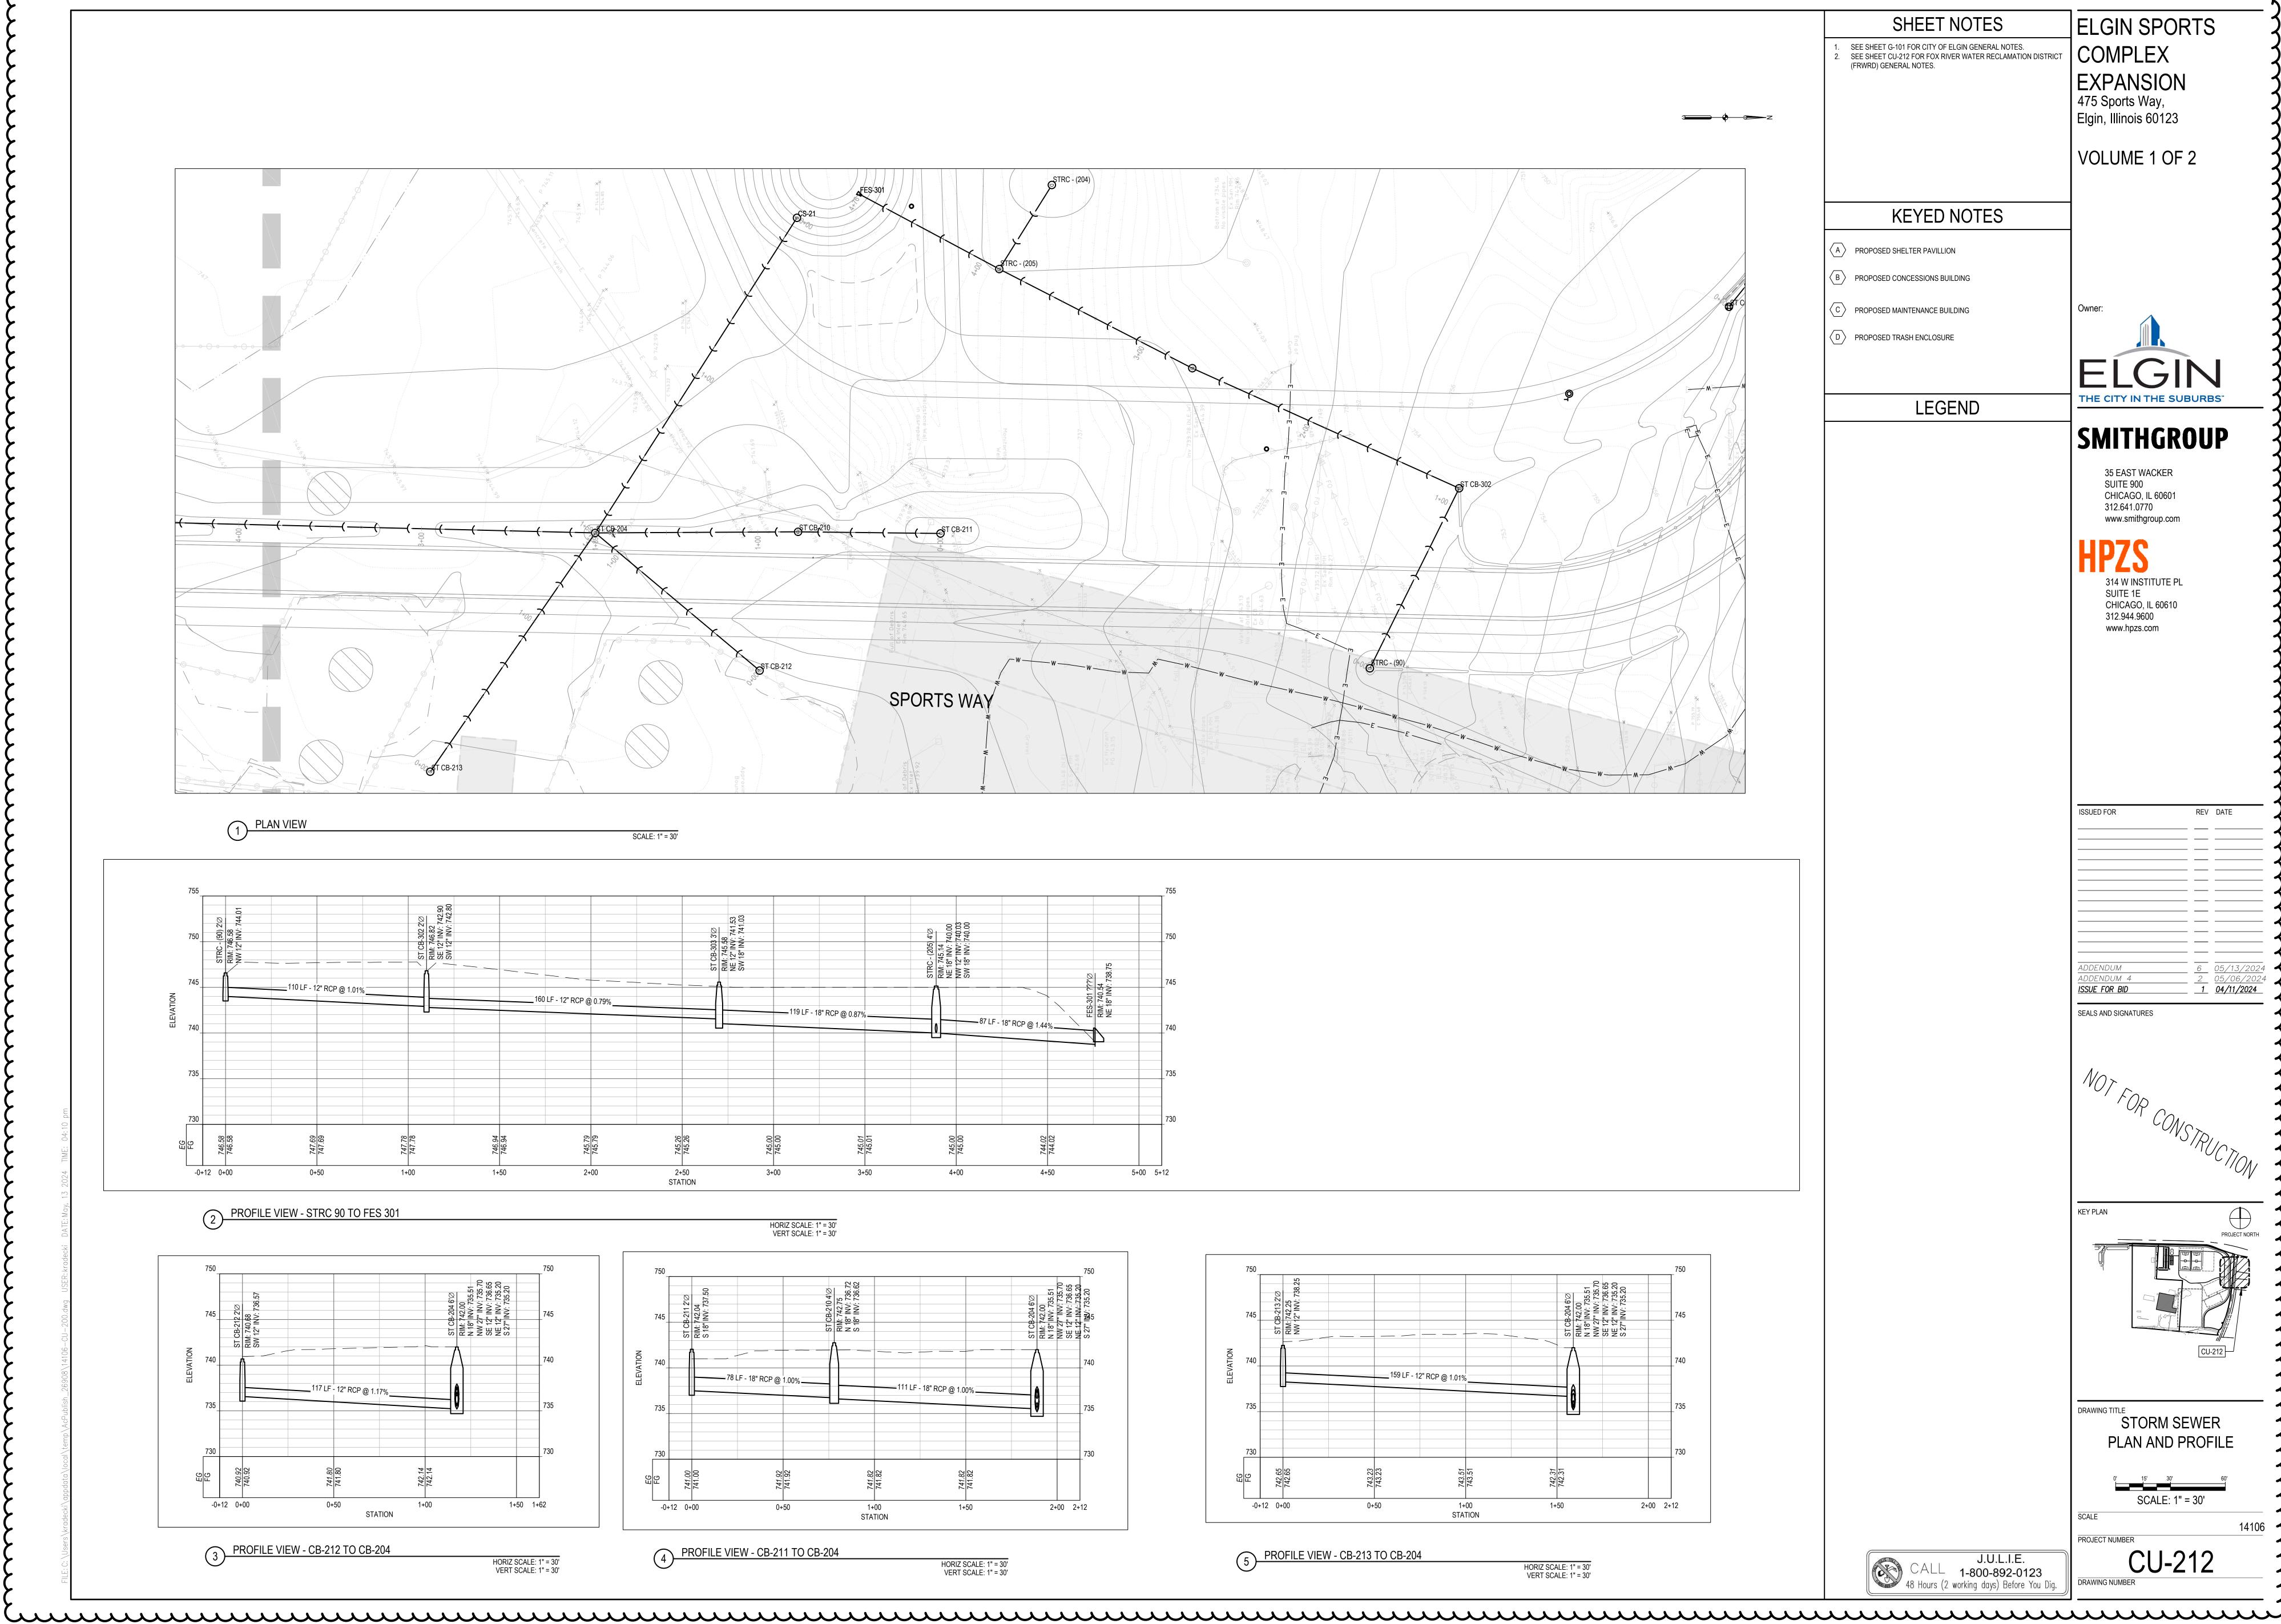


1. 2.	SEE SHEET G-101 FOR CITY OF ELGIN GENERAL NOTES. SEE SHEET CU-212 FOR FOX RIVER WATER RECLAMATION DISTR (FRWRD) GENERAL NOTES.
	KEYED NOTES
$\langle A \rangle$	PROPOSED SHELTER PAVILLION
B	PROPOSED CONCESSIONS BUILDING
\frown	PROPOSED MAINTENANCE BUILDING
$\langle c \rangle$	

LEGEND


J.U.L.I.E. CALL 1-800-892-0123 48 Hours (2 working days) Before You Dig.

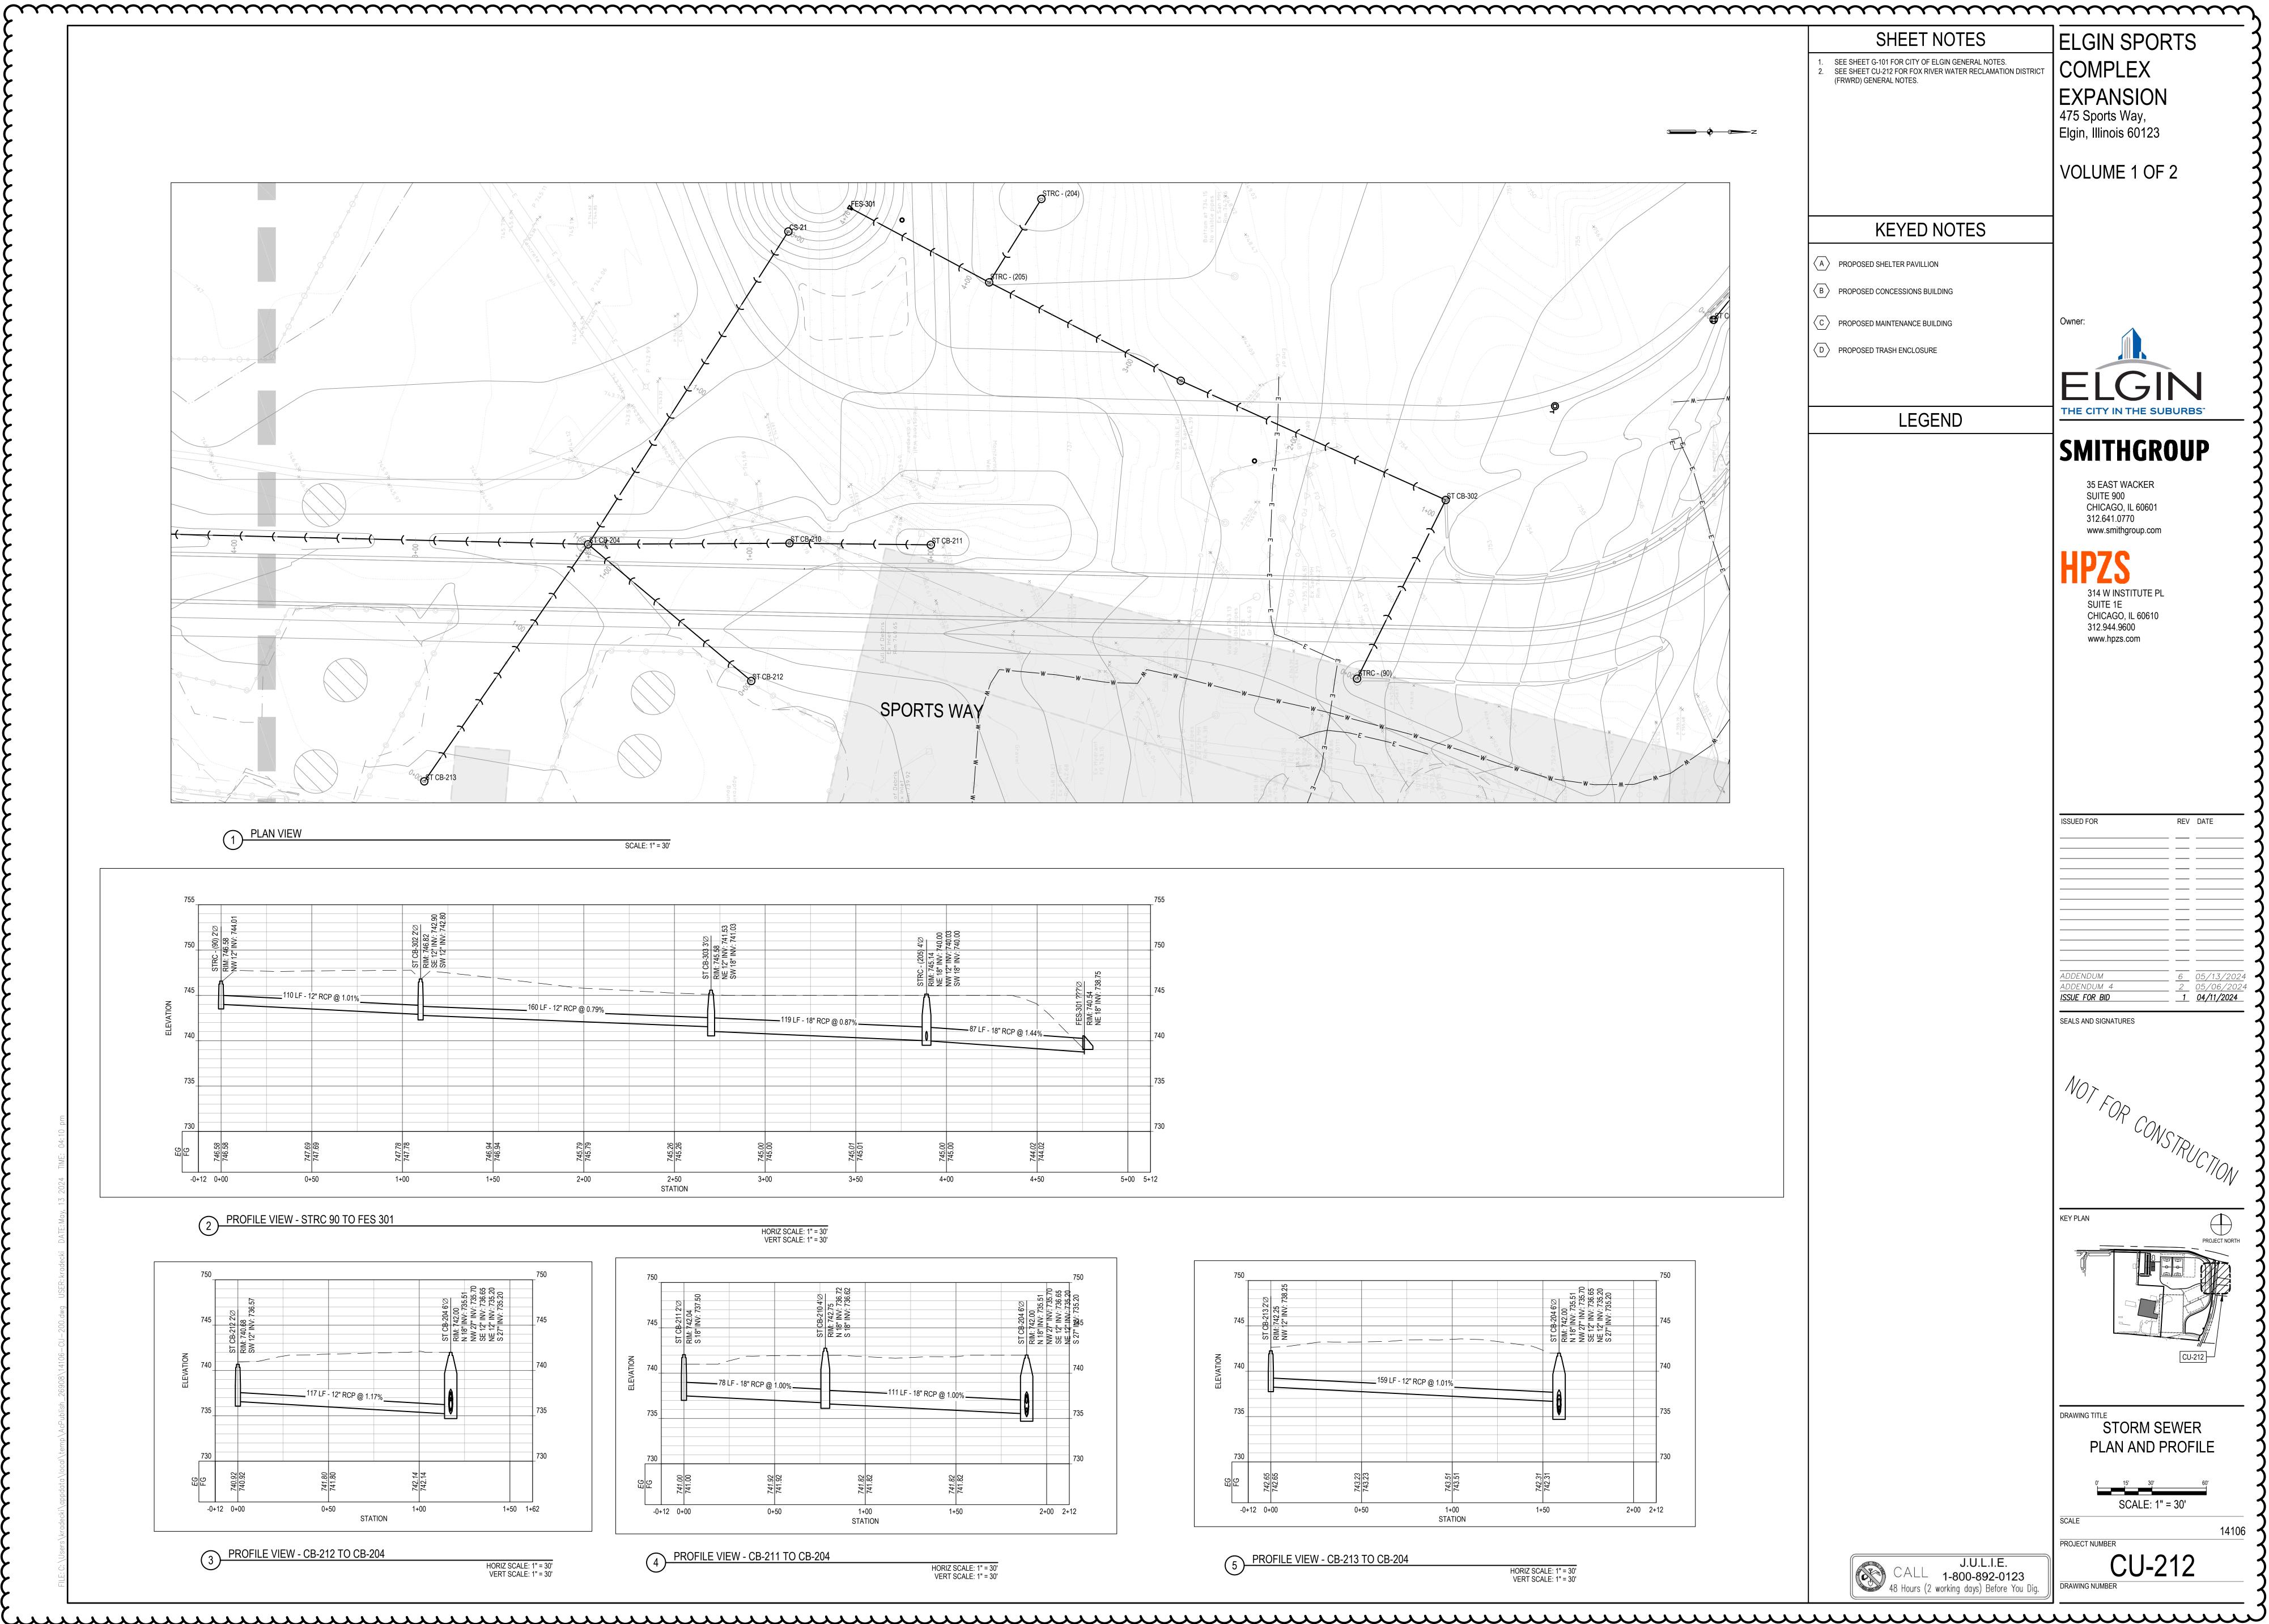


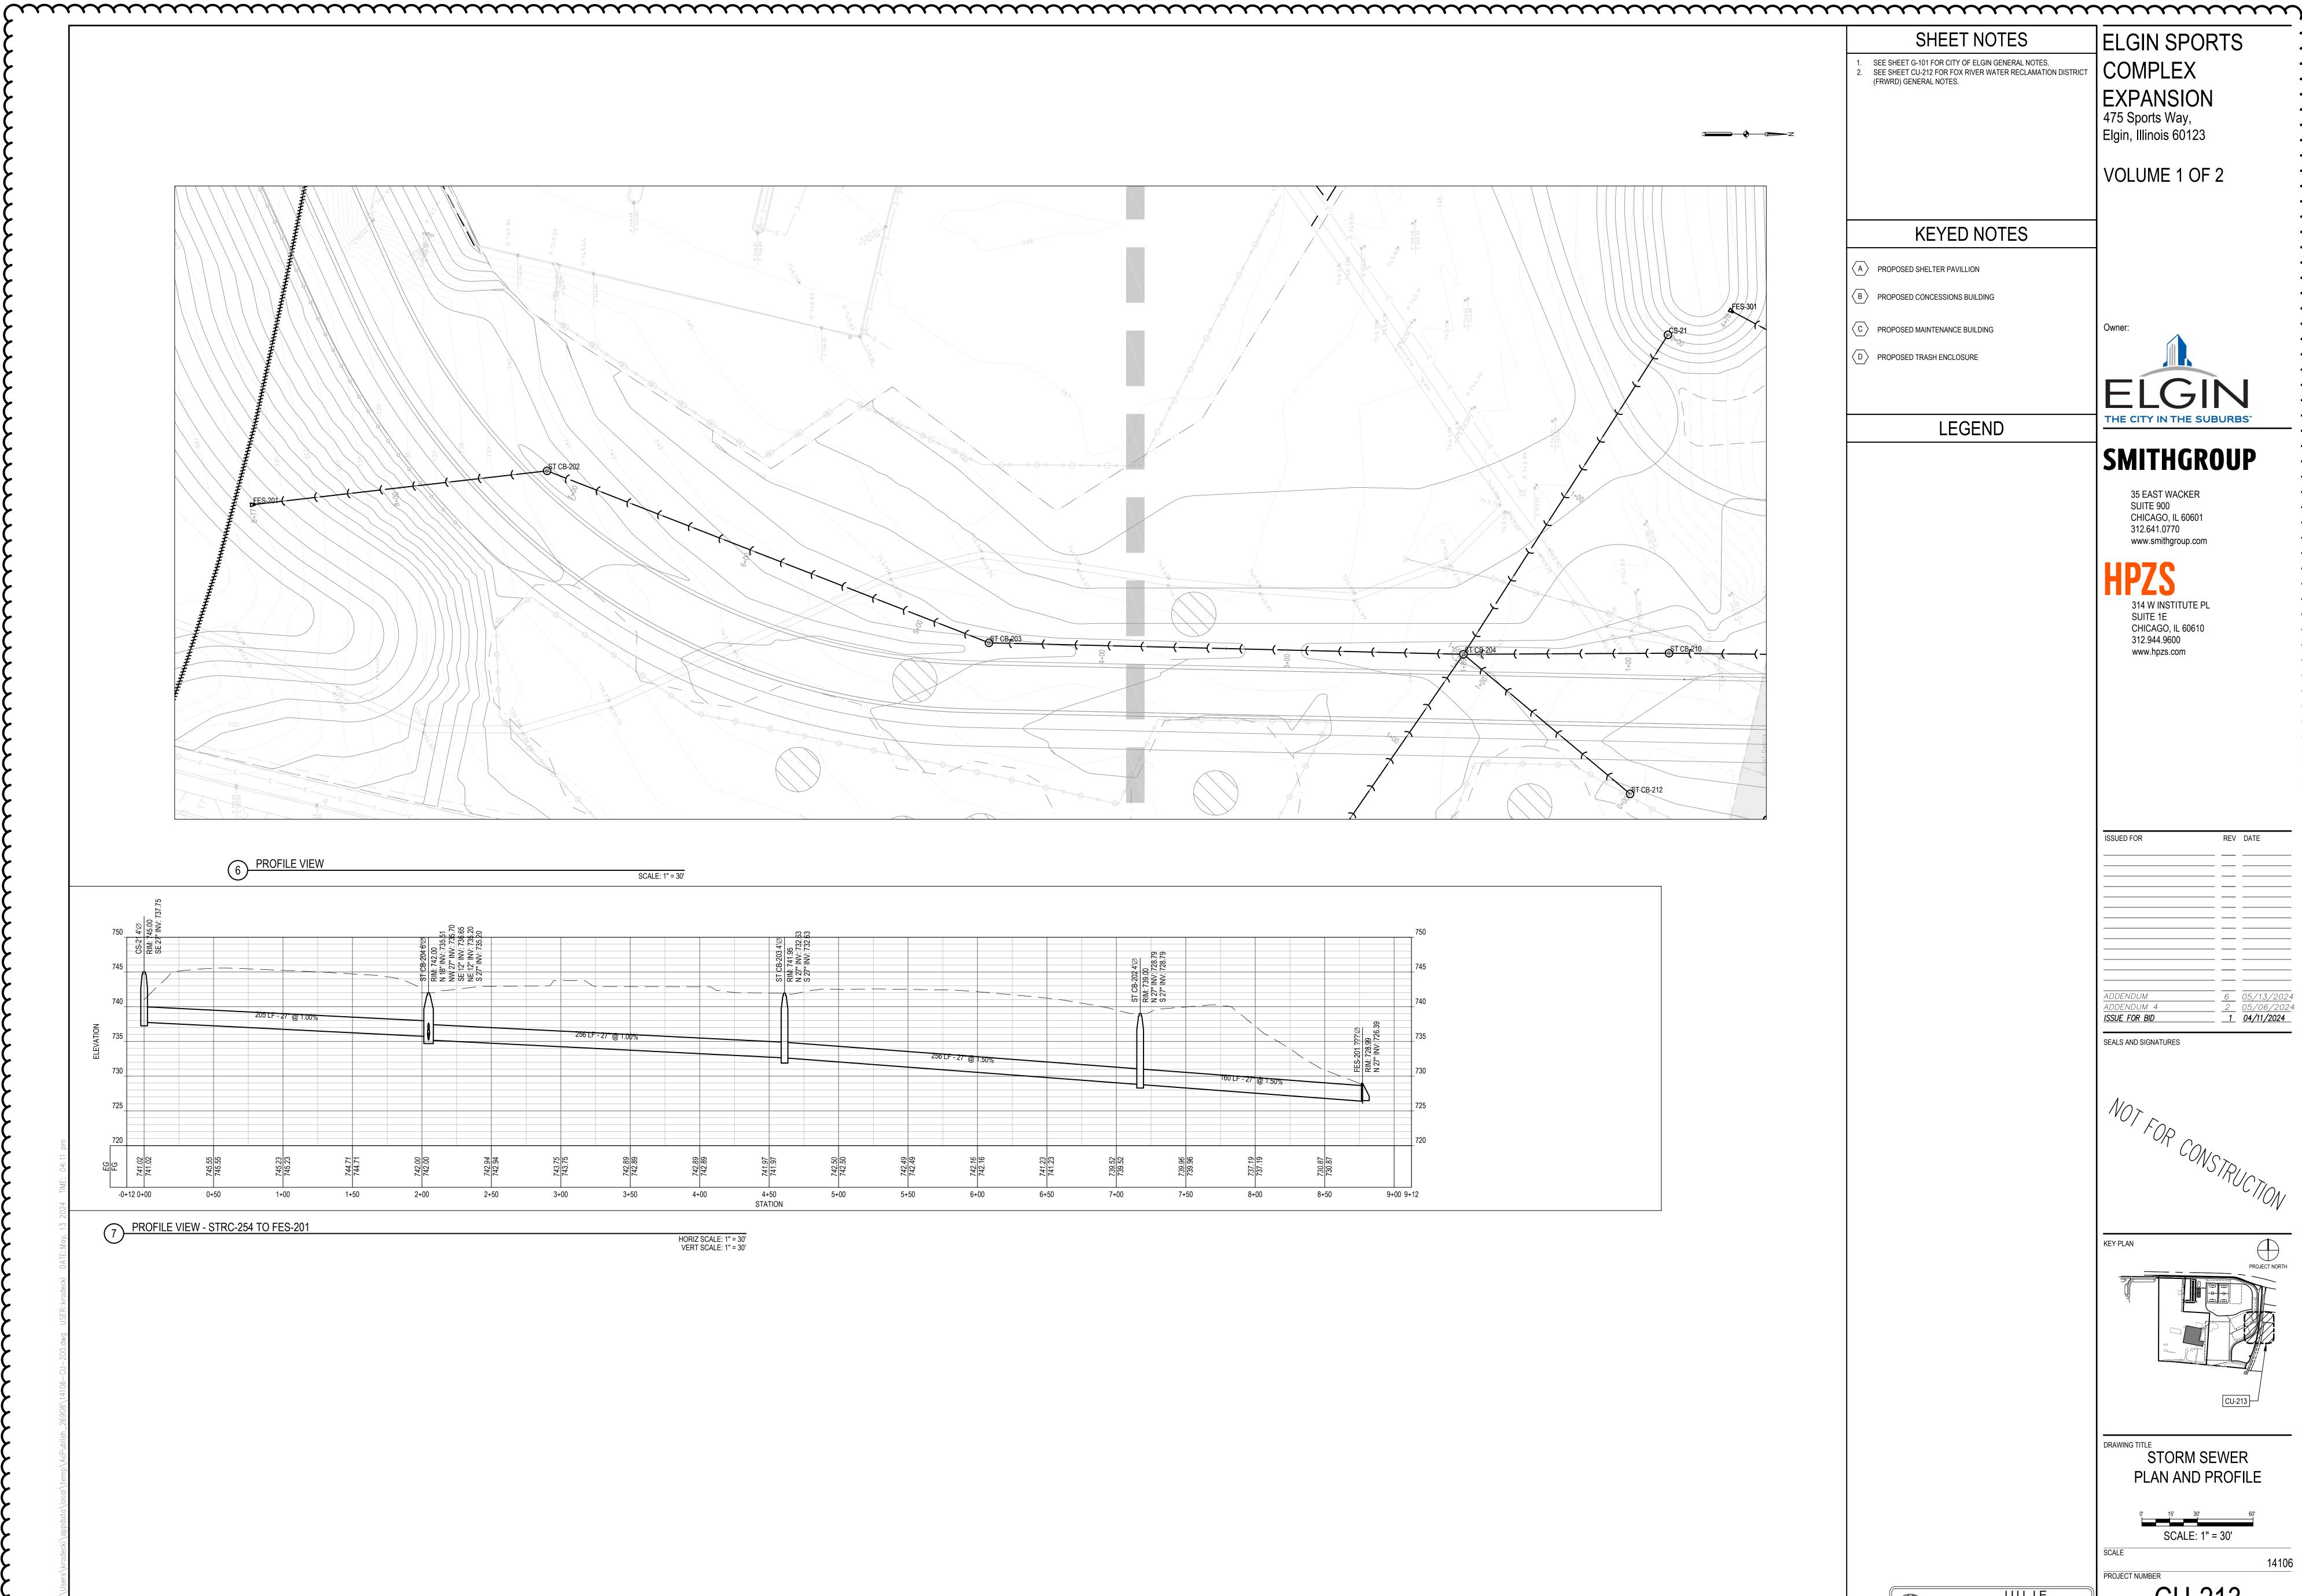

LEGEND

J.U.L.I.E. CALL 1-800-892-0123 48 Hours (2 working days) Before You Dig.

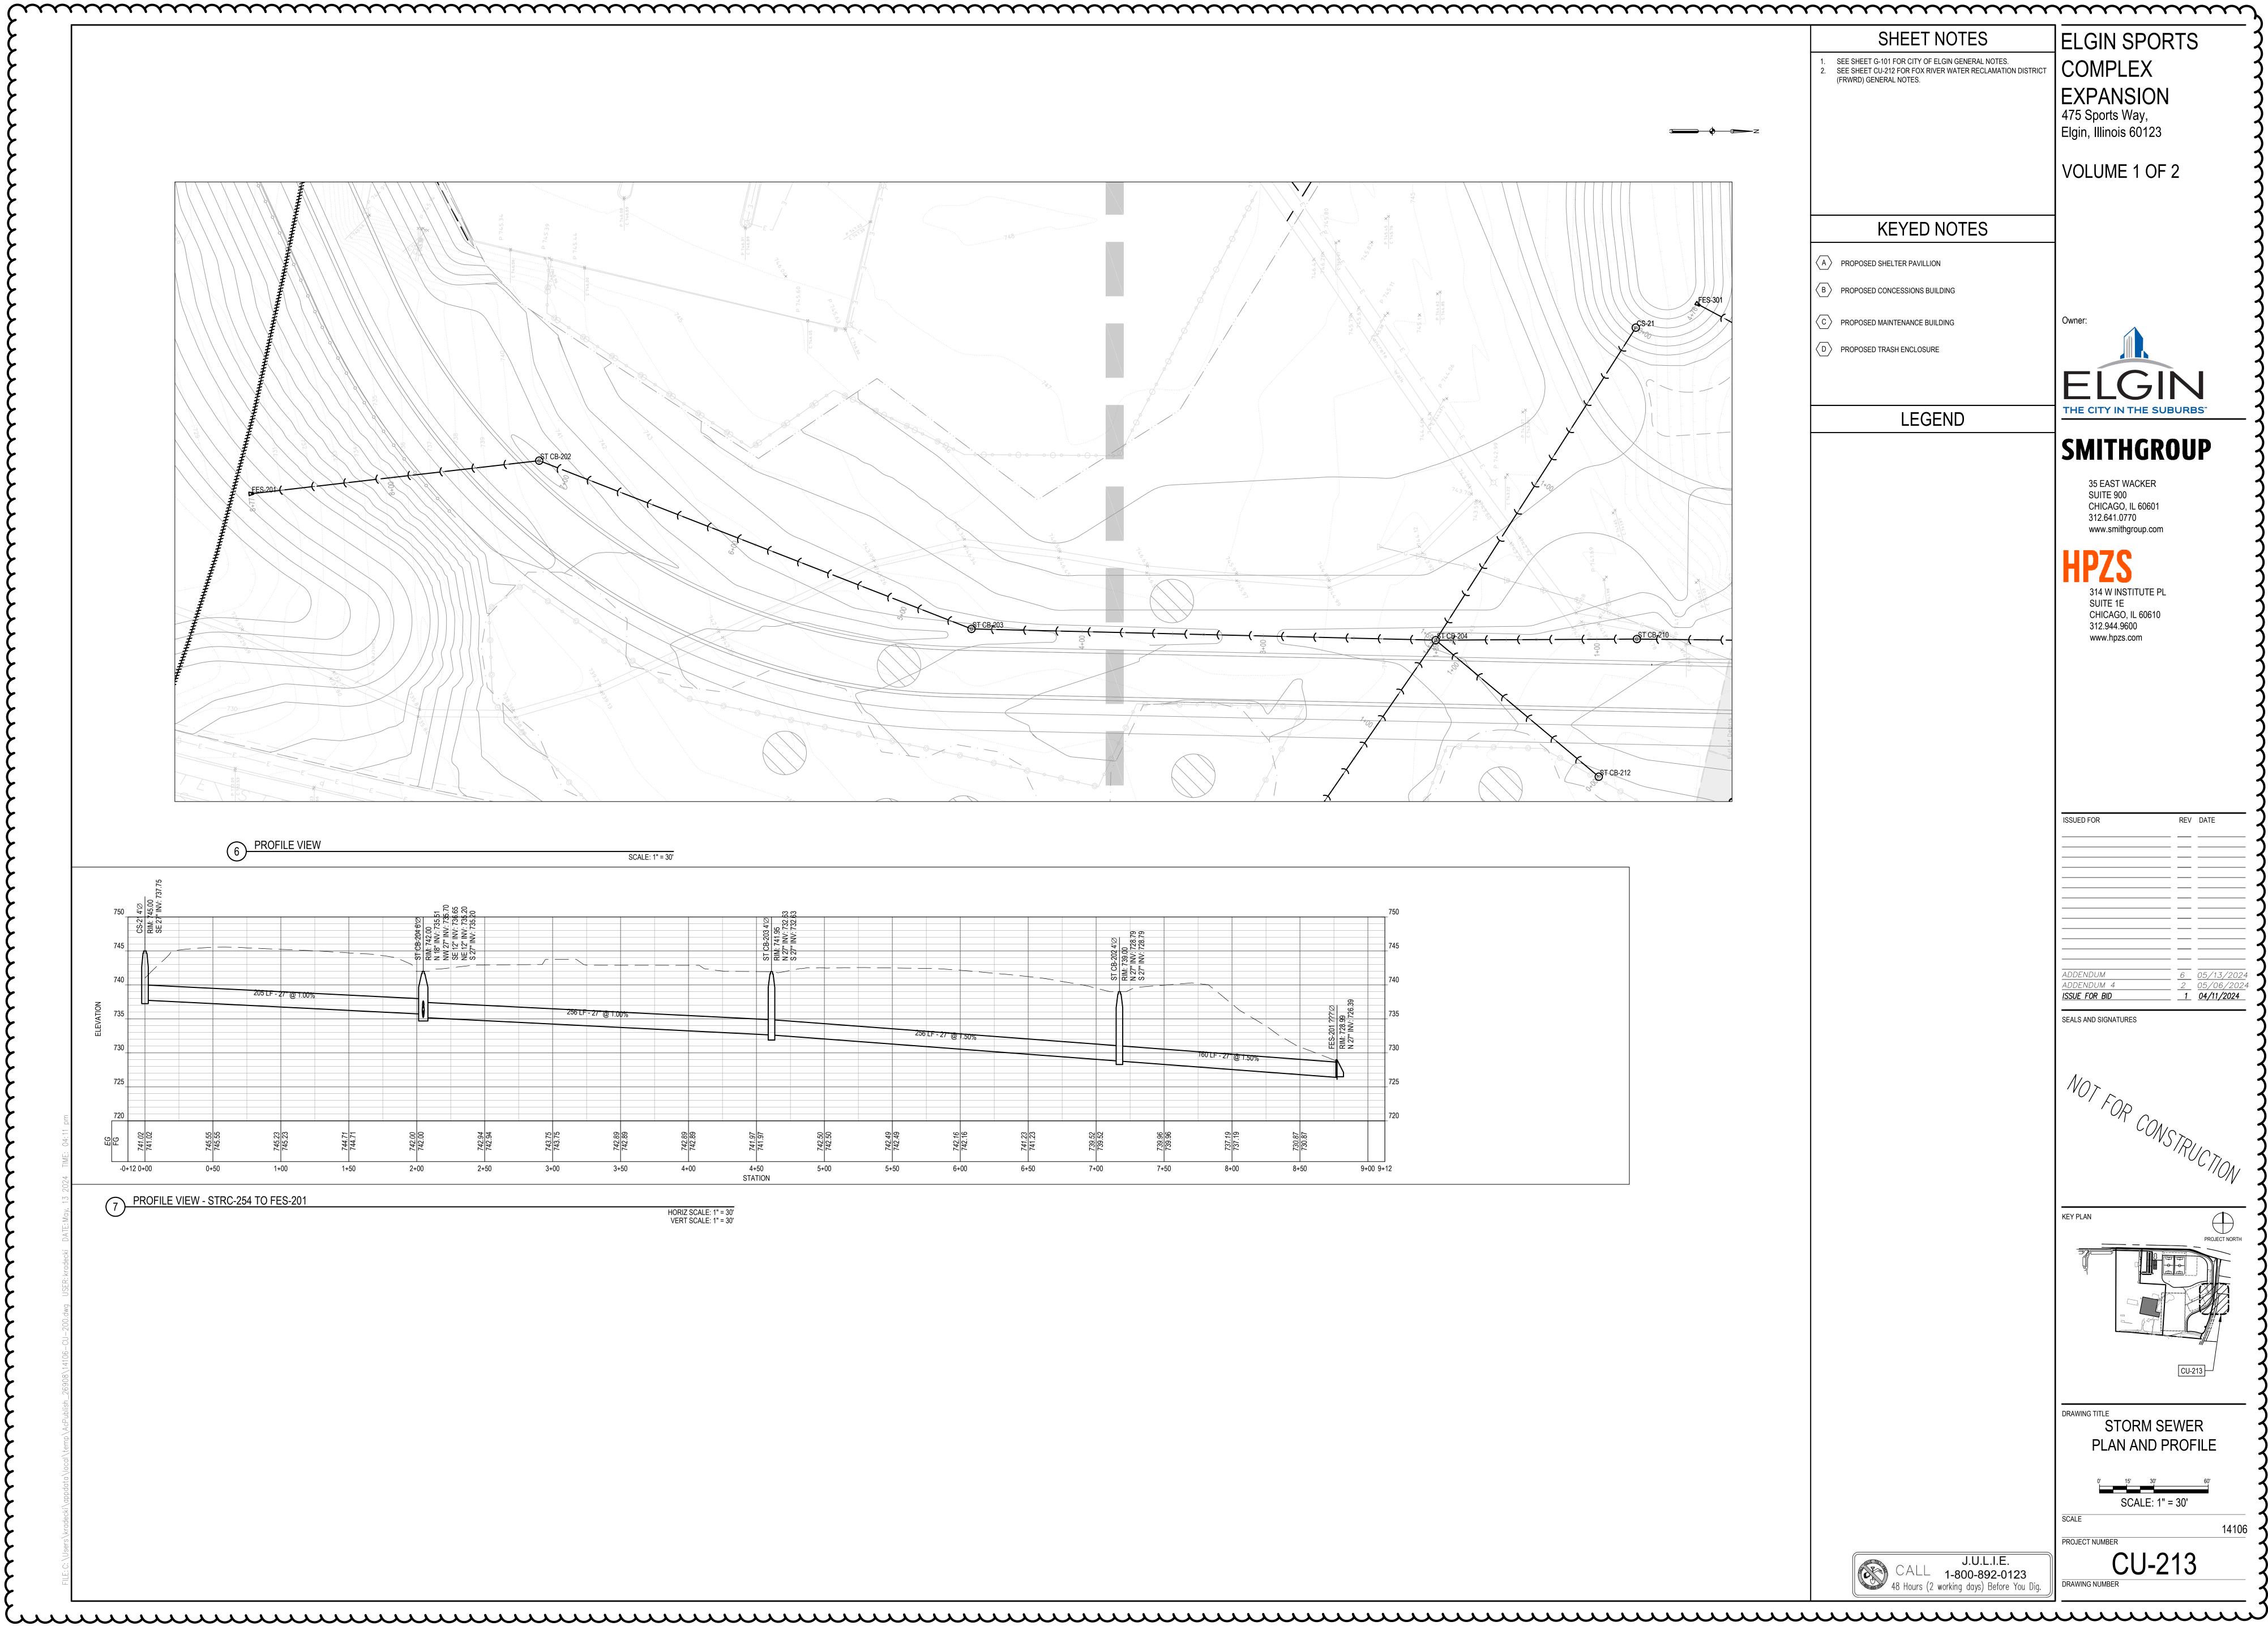

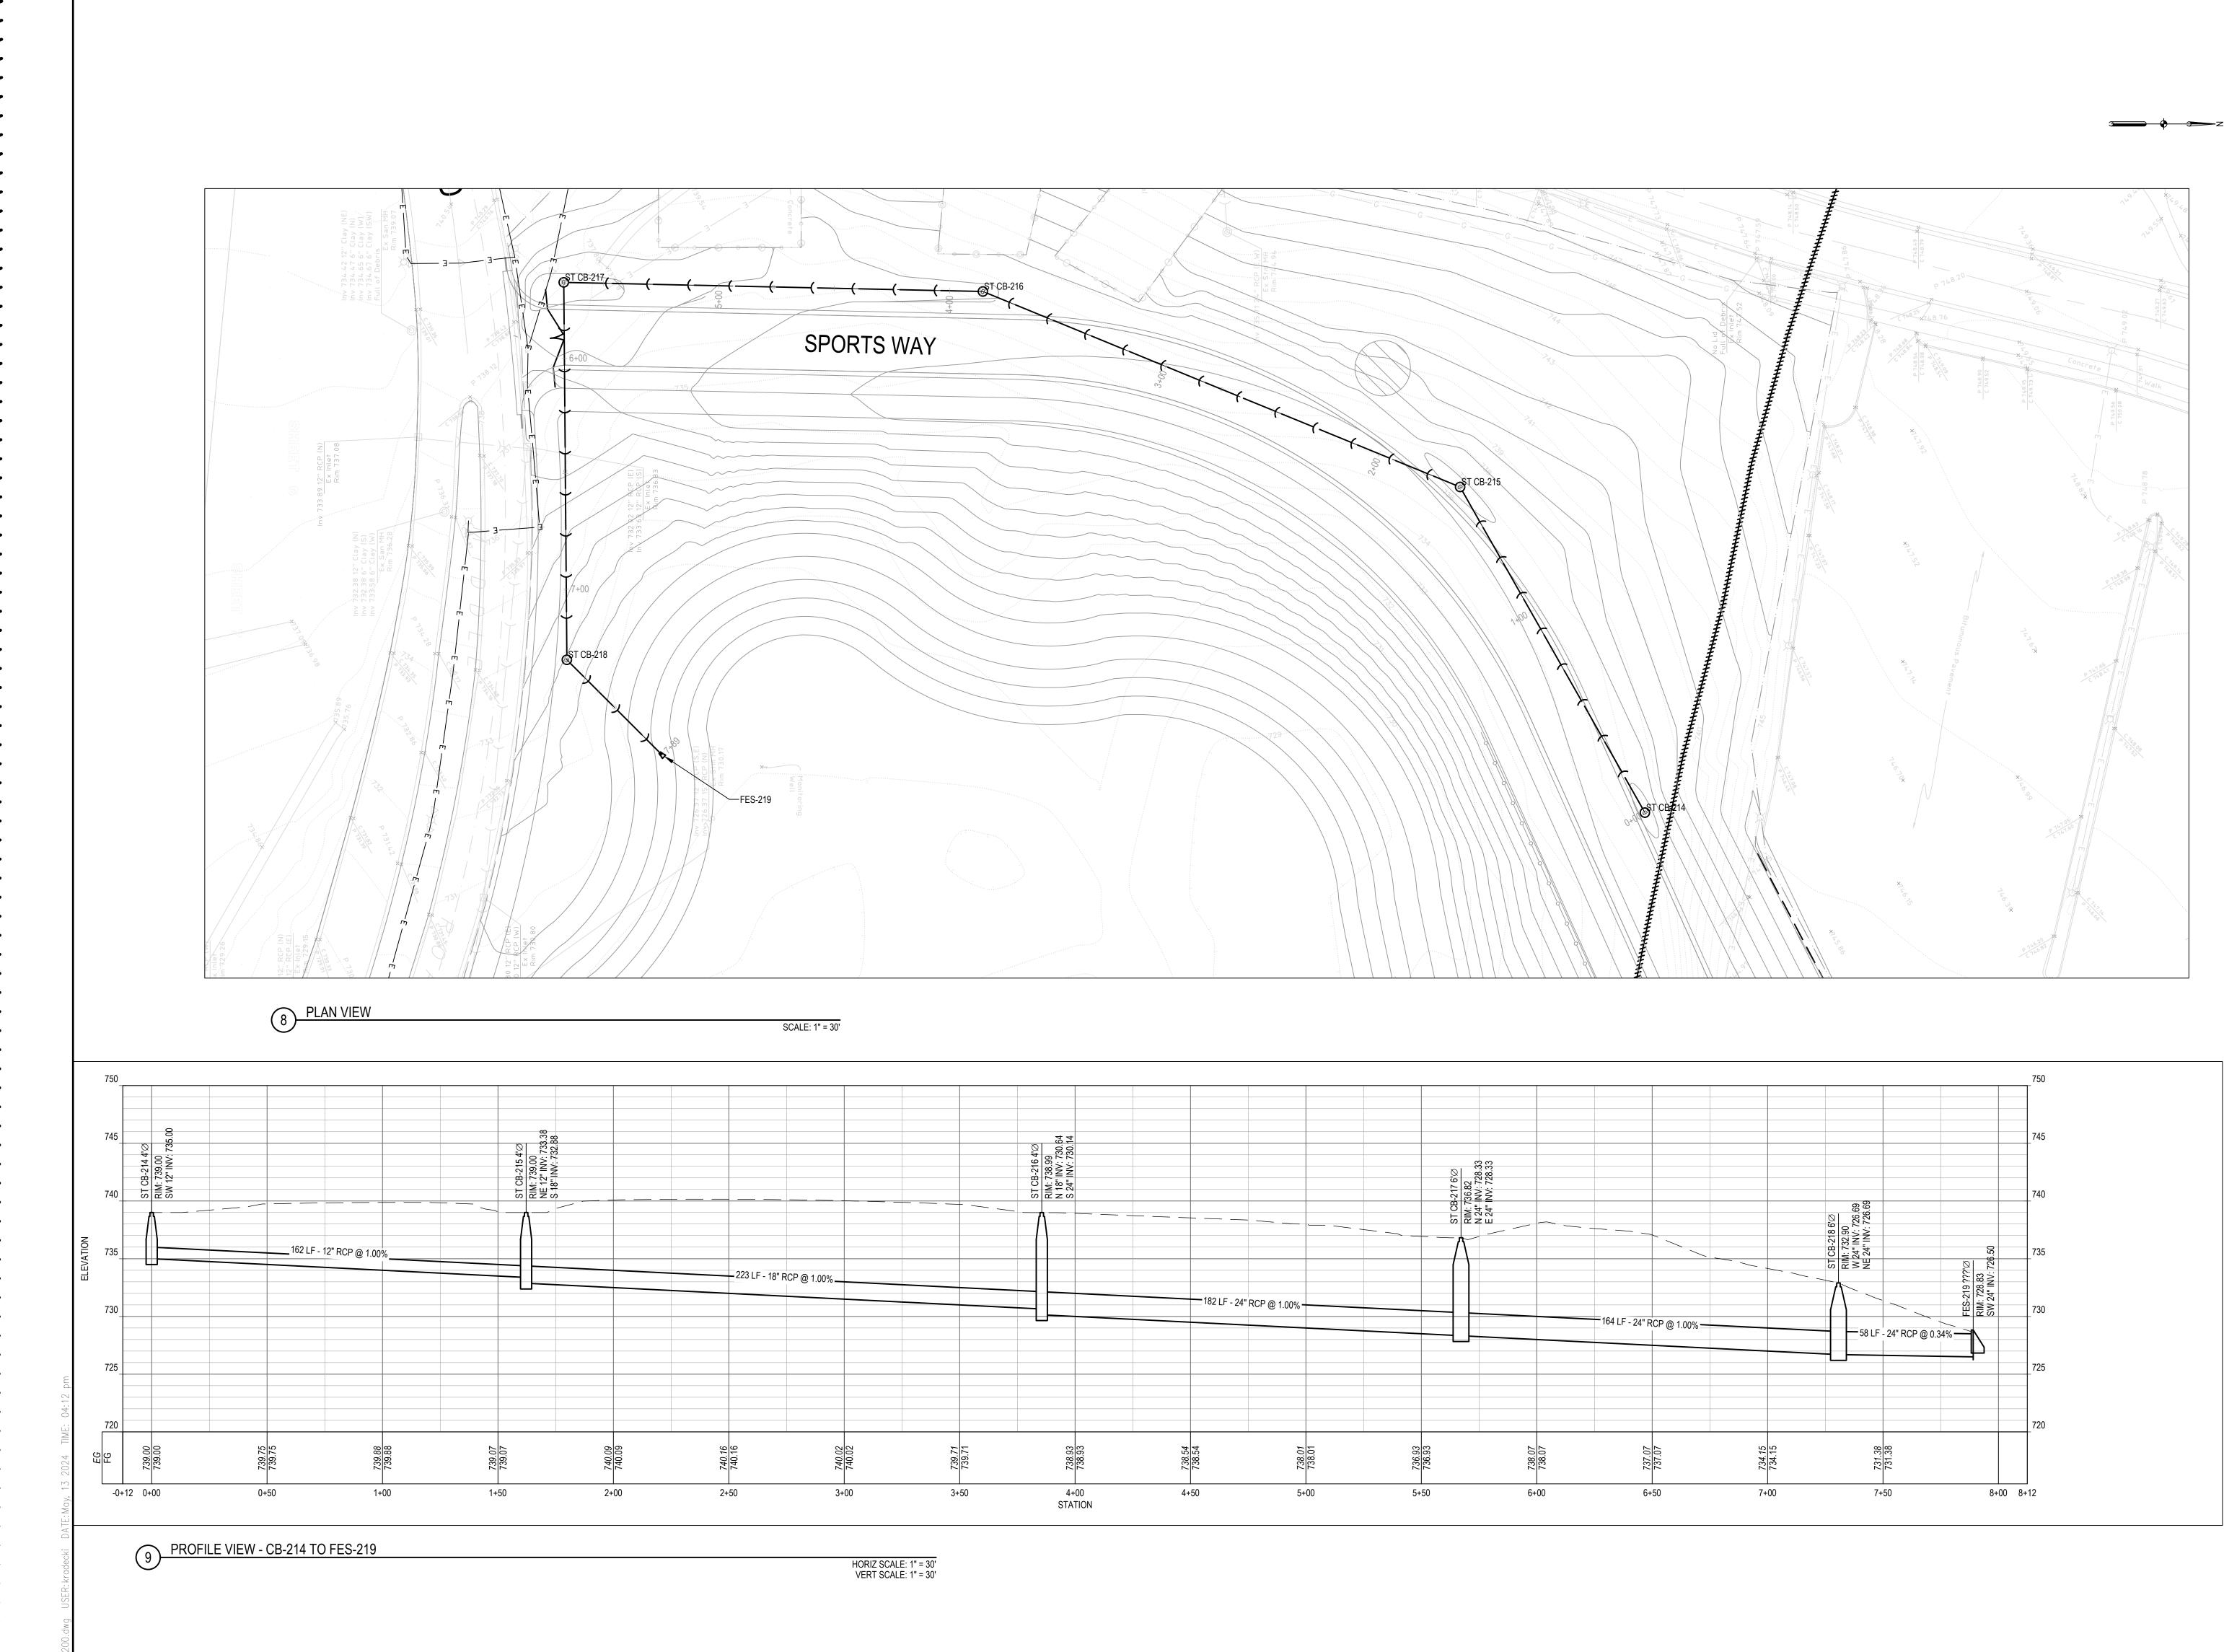



	KEYED NOTES
A	PROPOSED SHELTER PAVILLION
B	PROPOSED CONCESSIONS BUILDING
C	PROPOSED MAINTENANCE BUILDING
$\langle D \rangle$	PROPOSED TRASH ENCLOSURE


SHEET NOTES


LEGEND




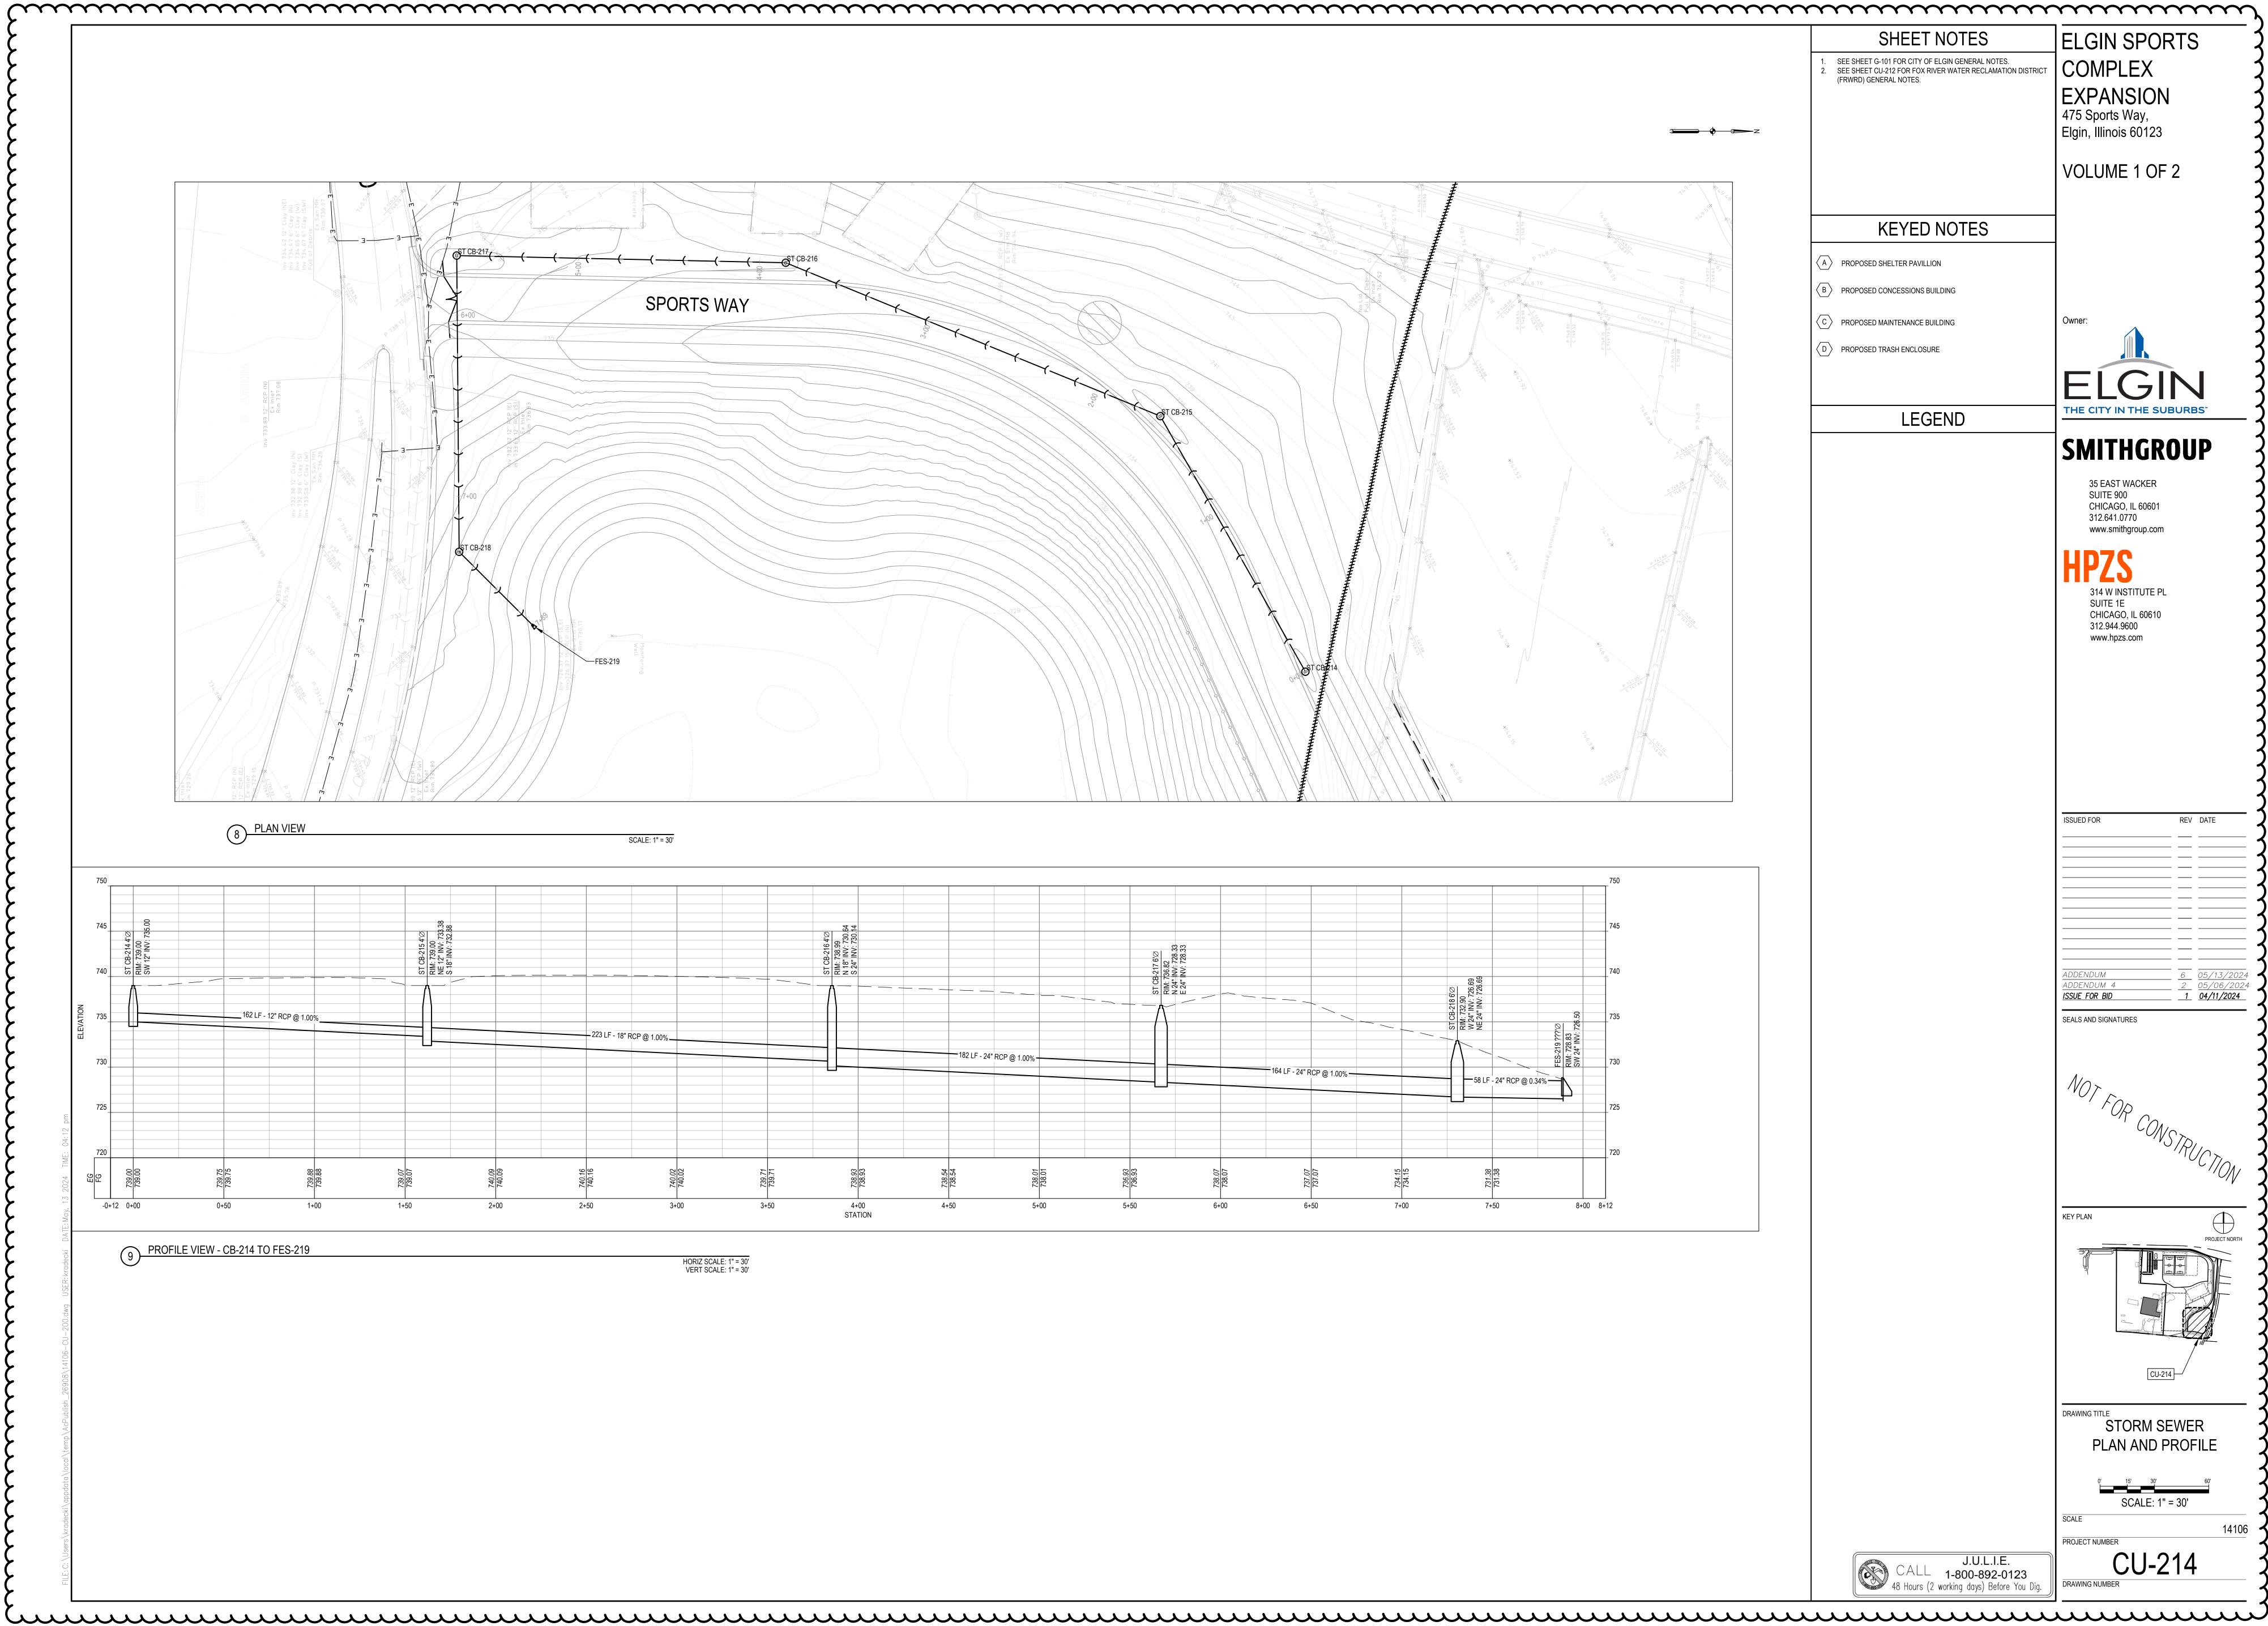

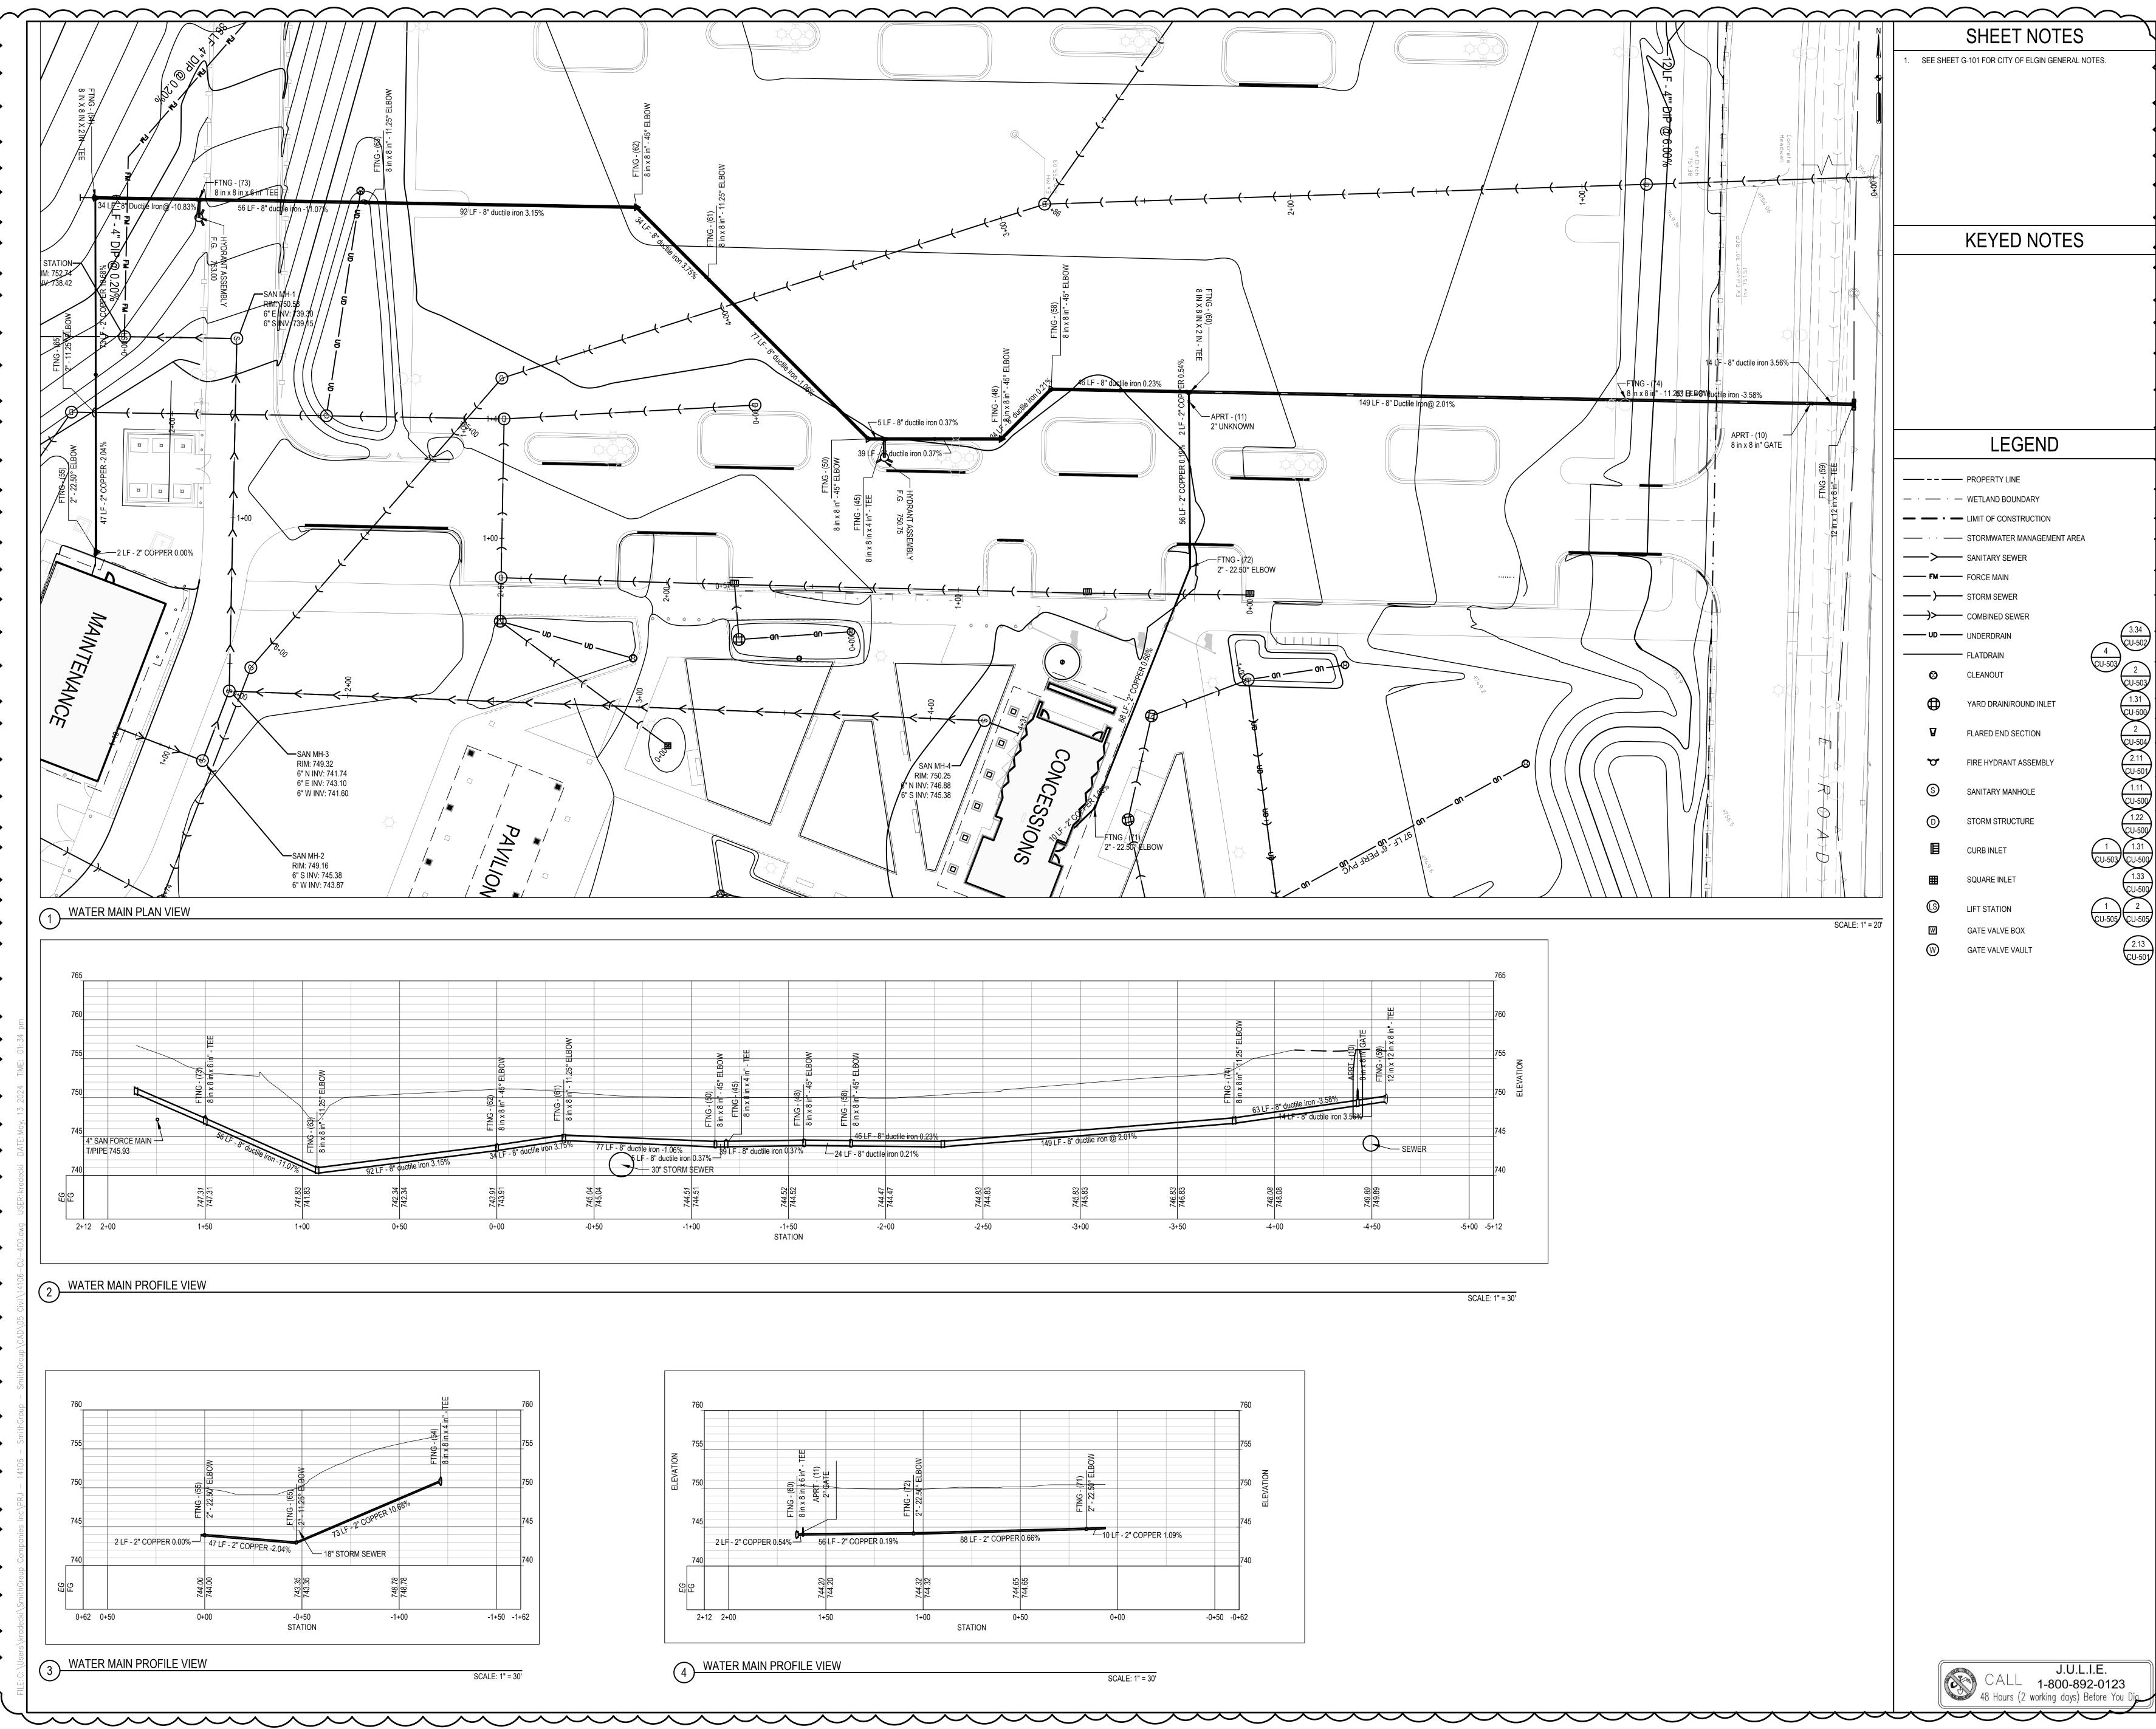


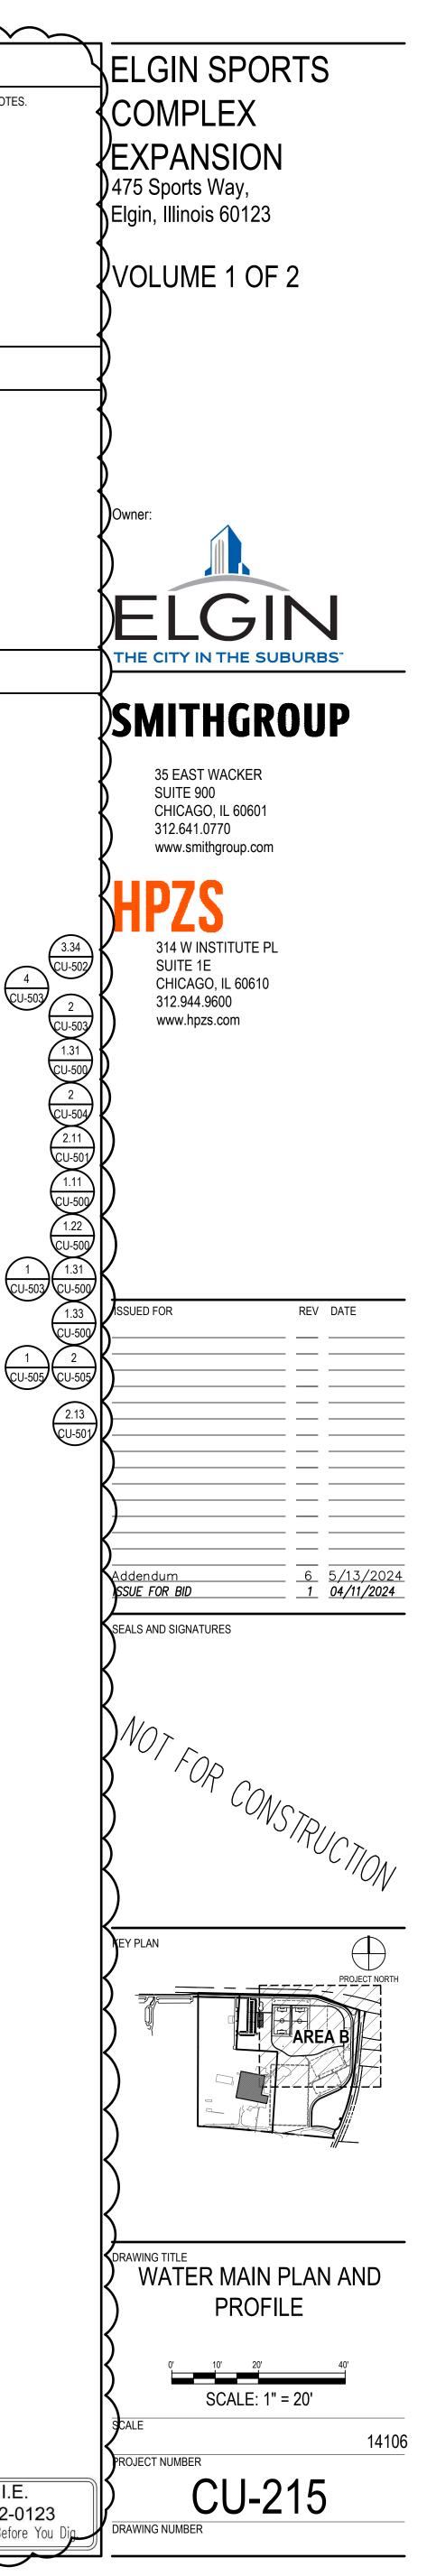


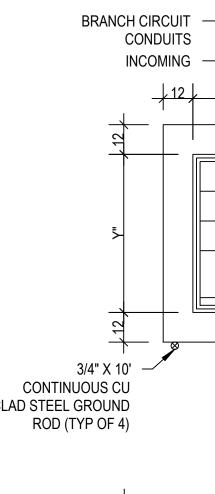

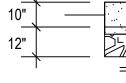





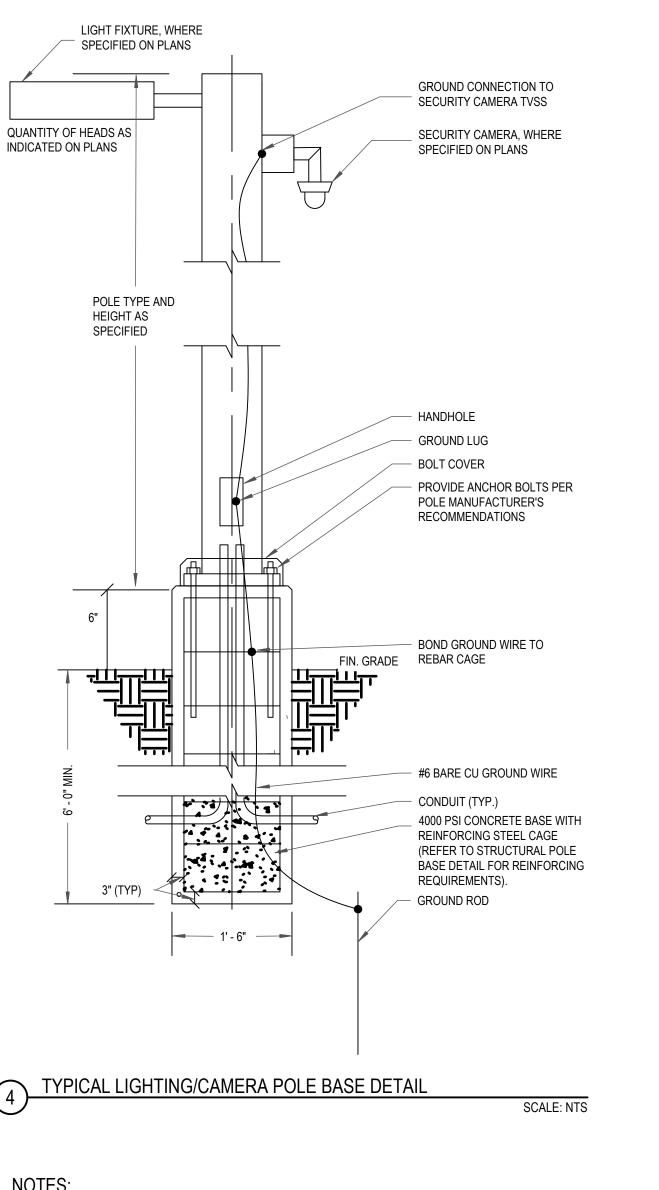


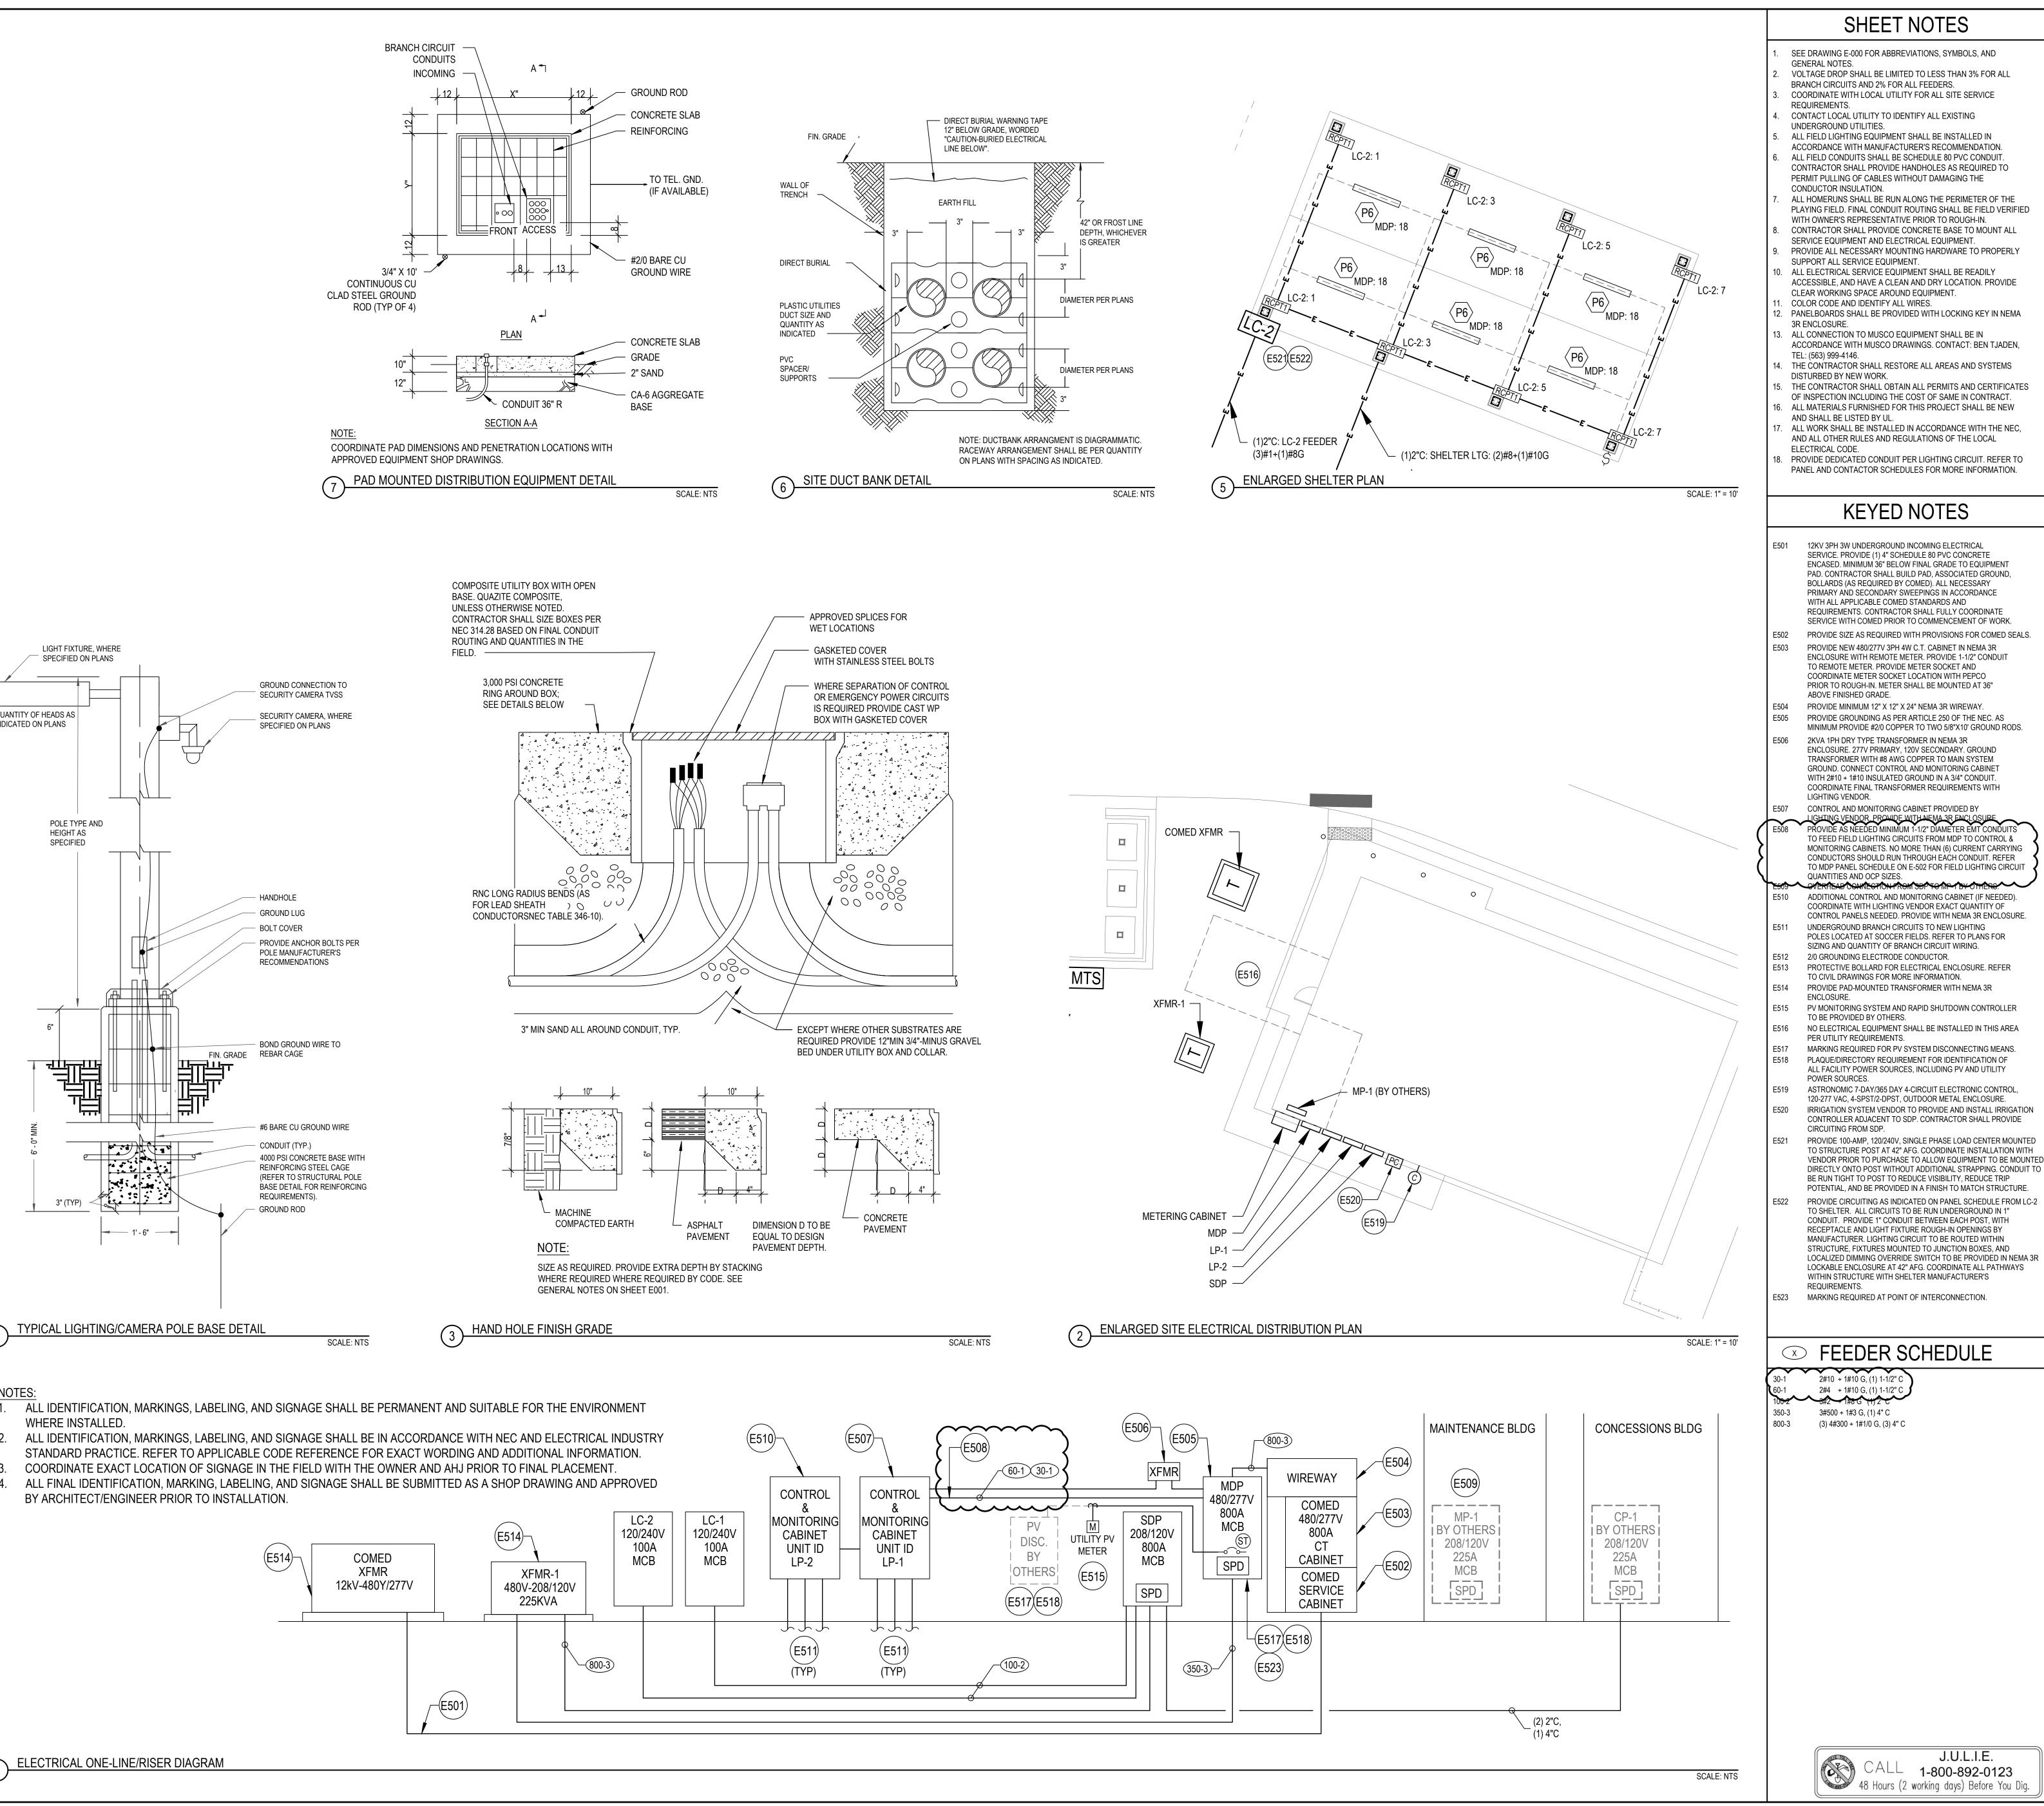

ELECTRICAL ONE-LINE/RISER DIAGRAM

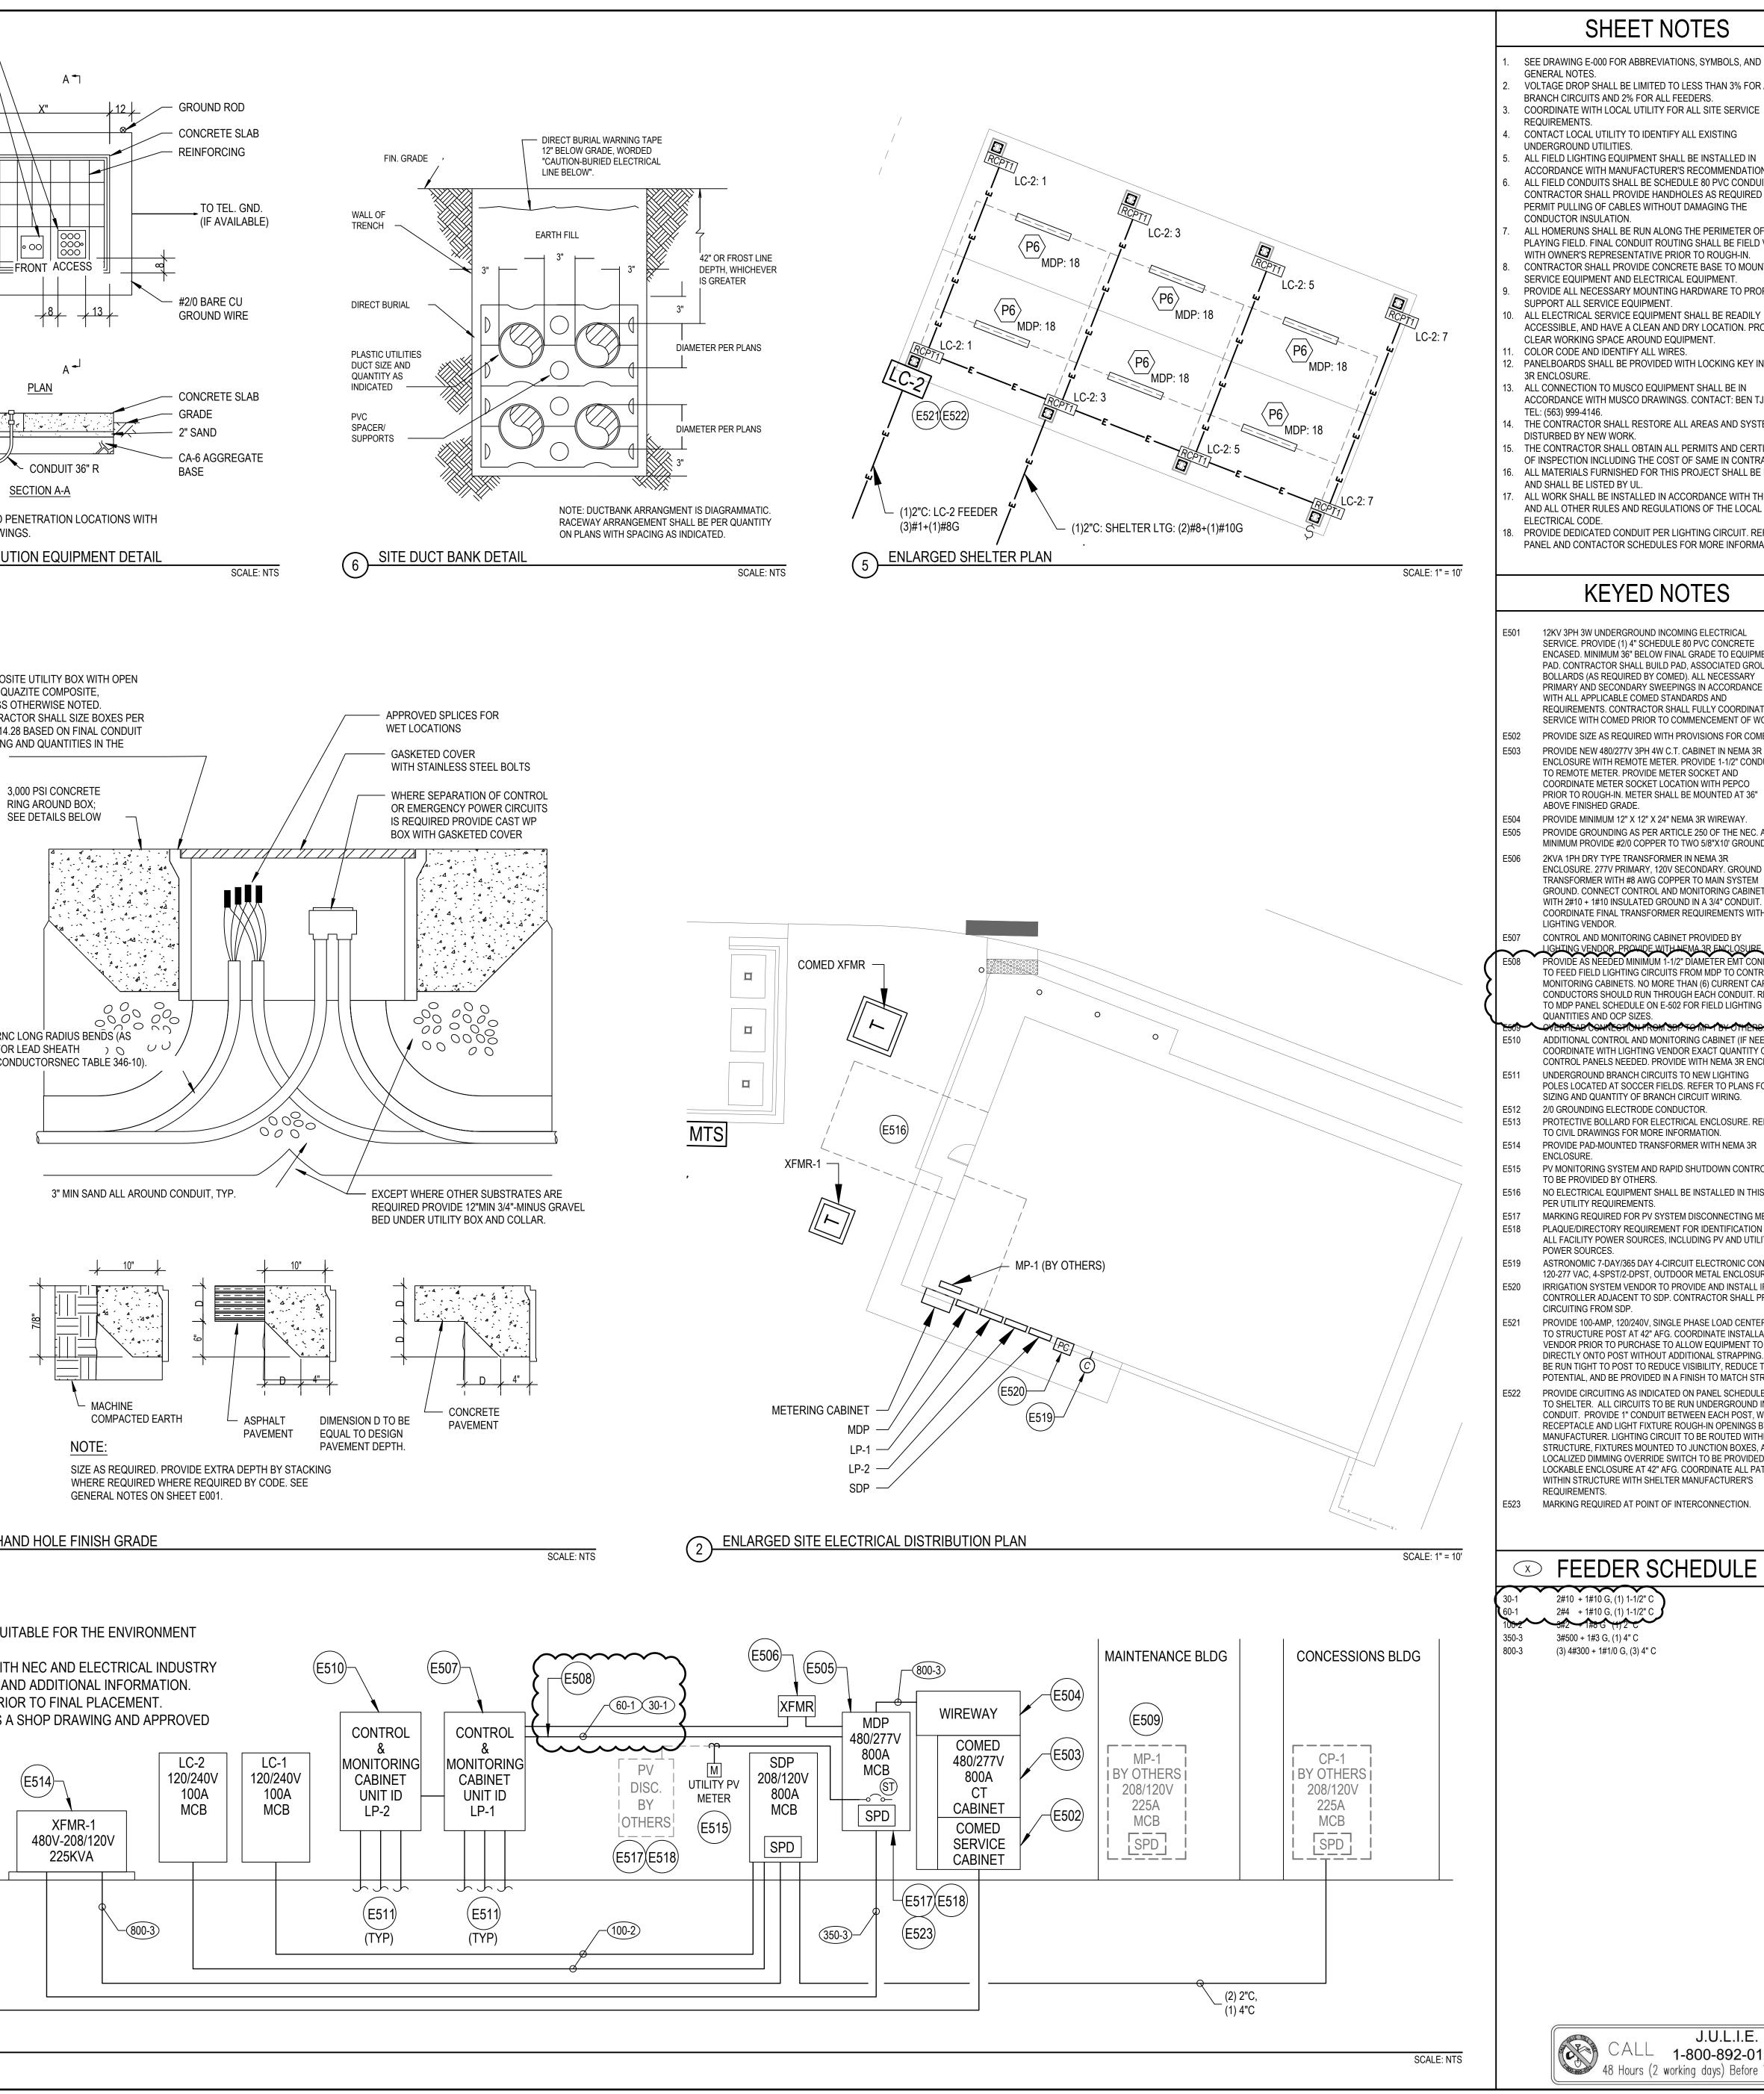

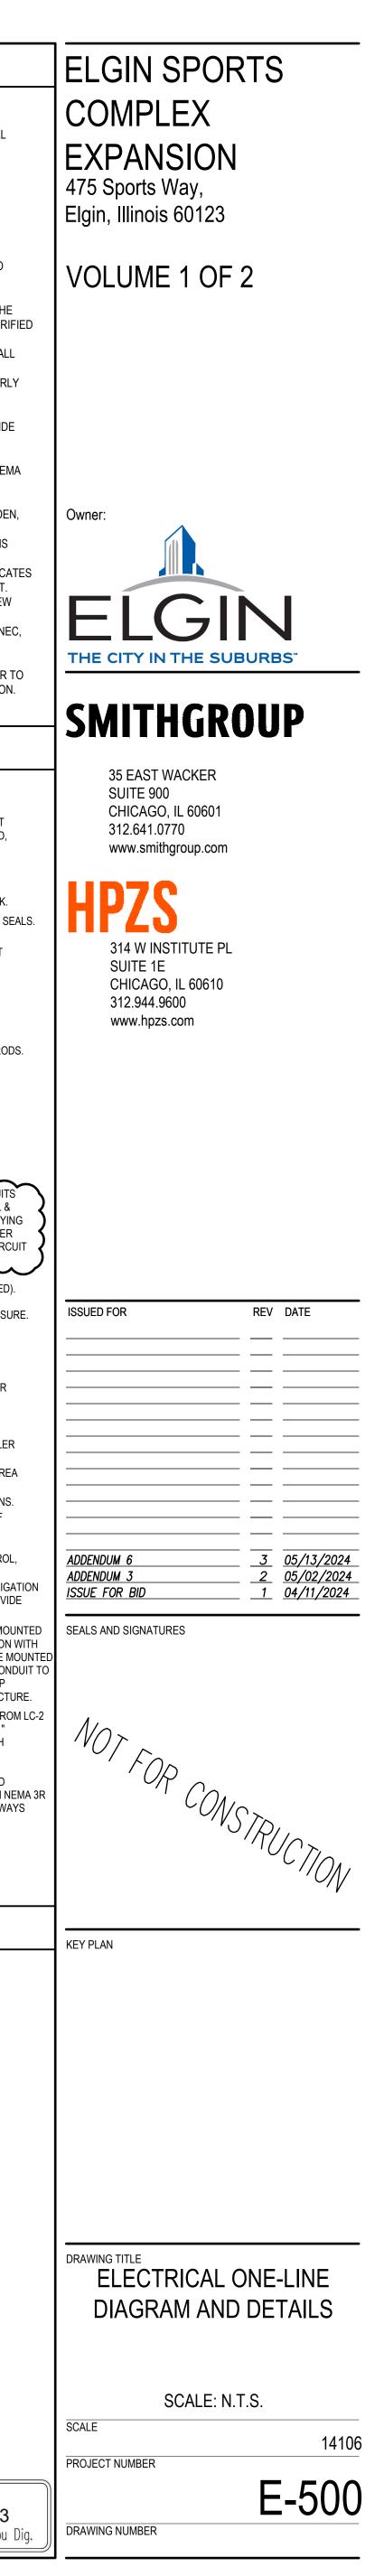

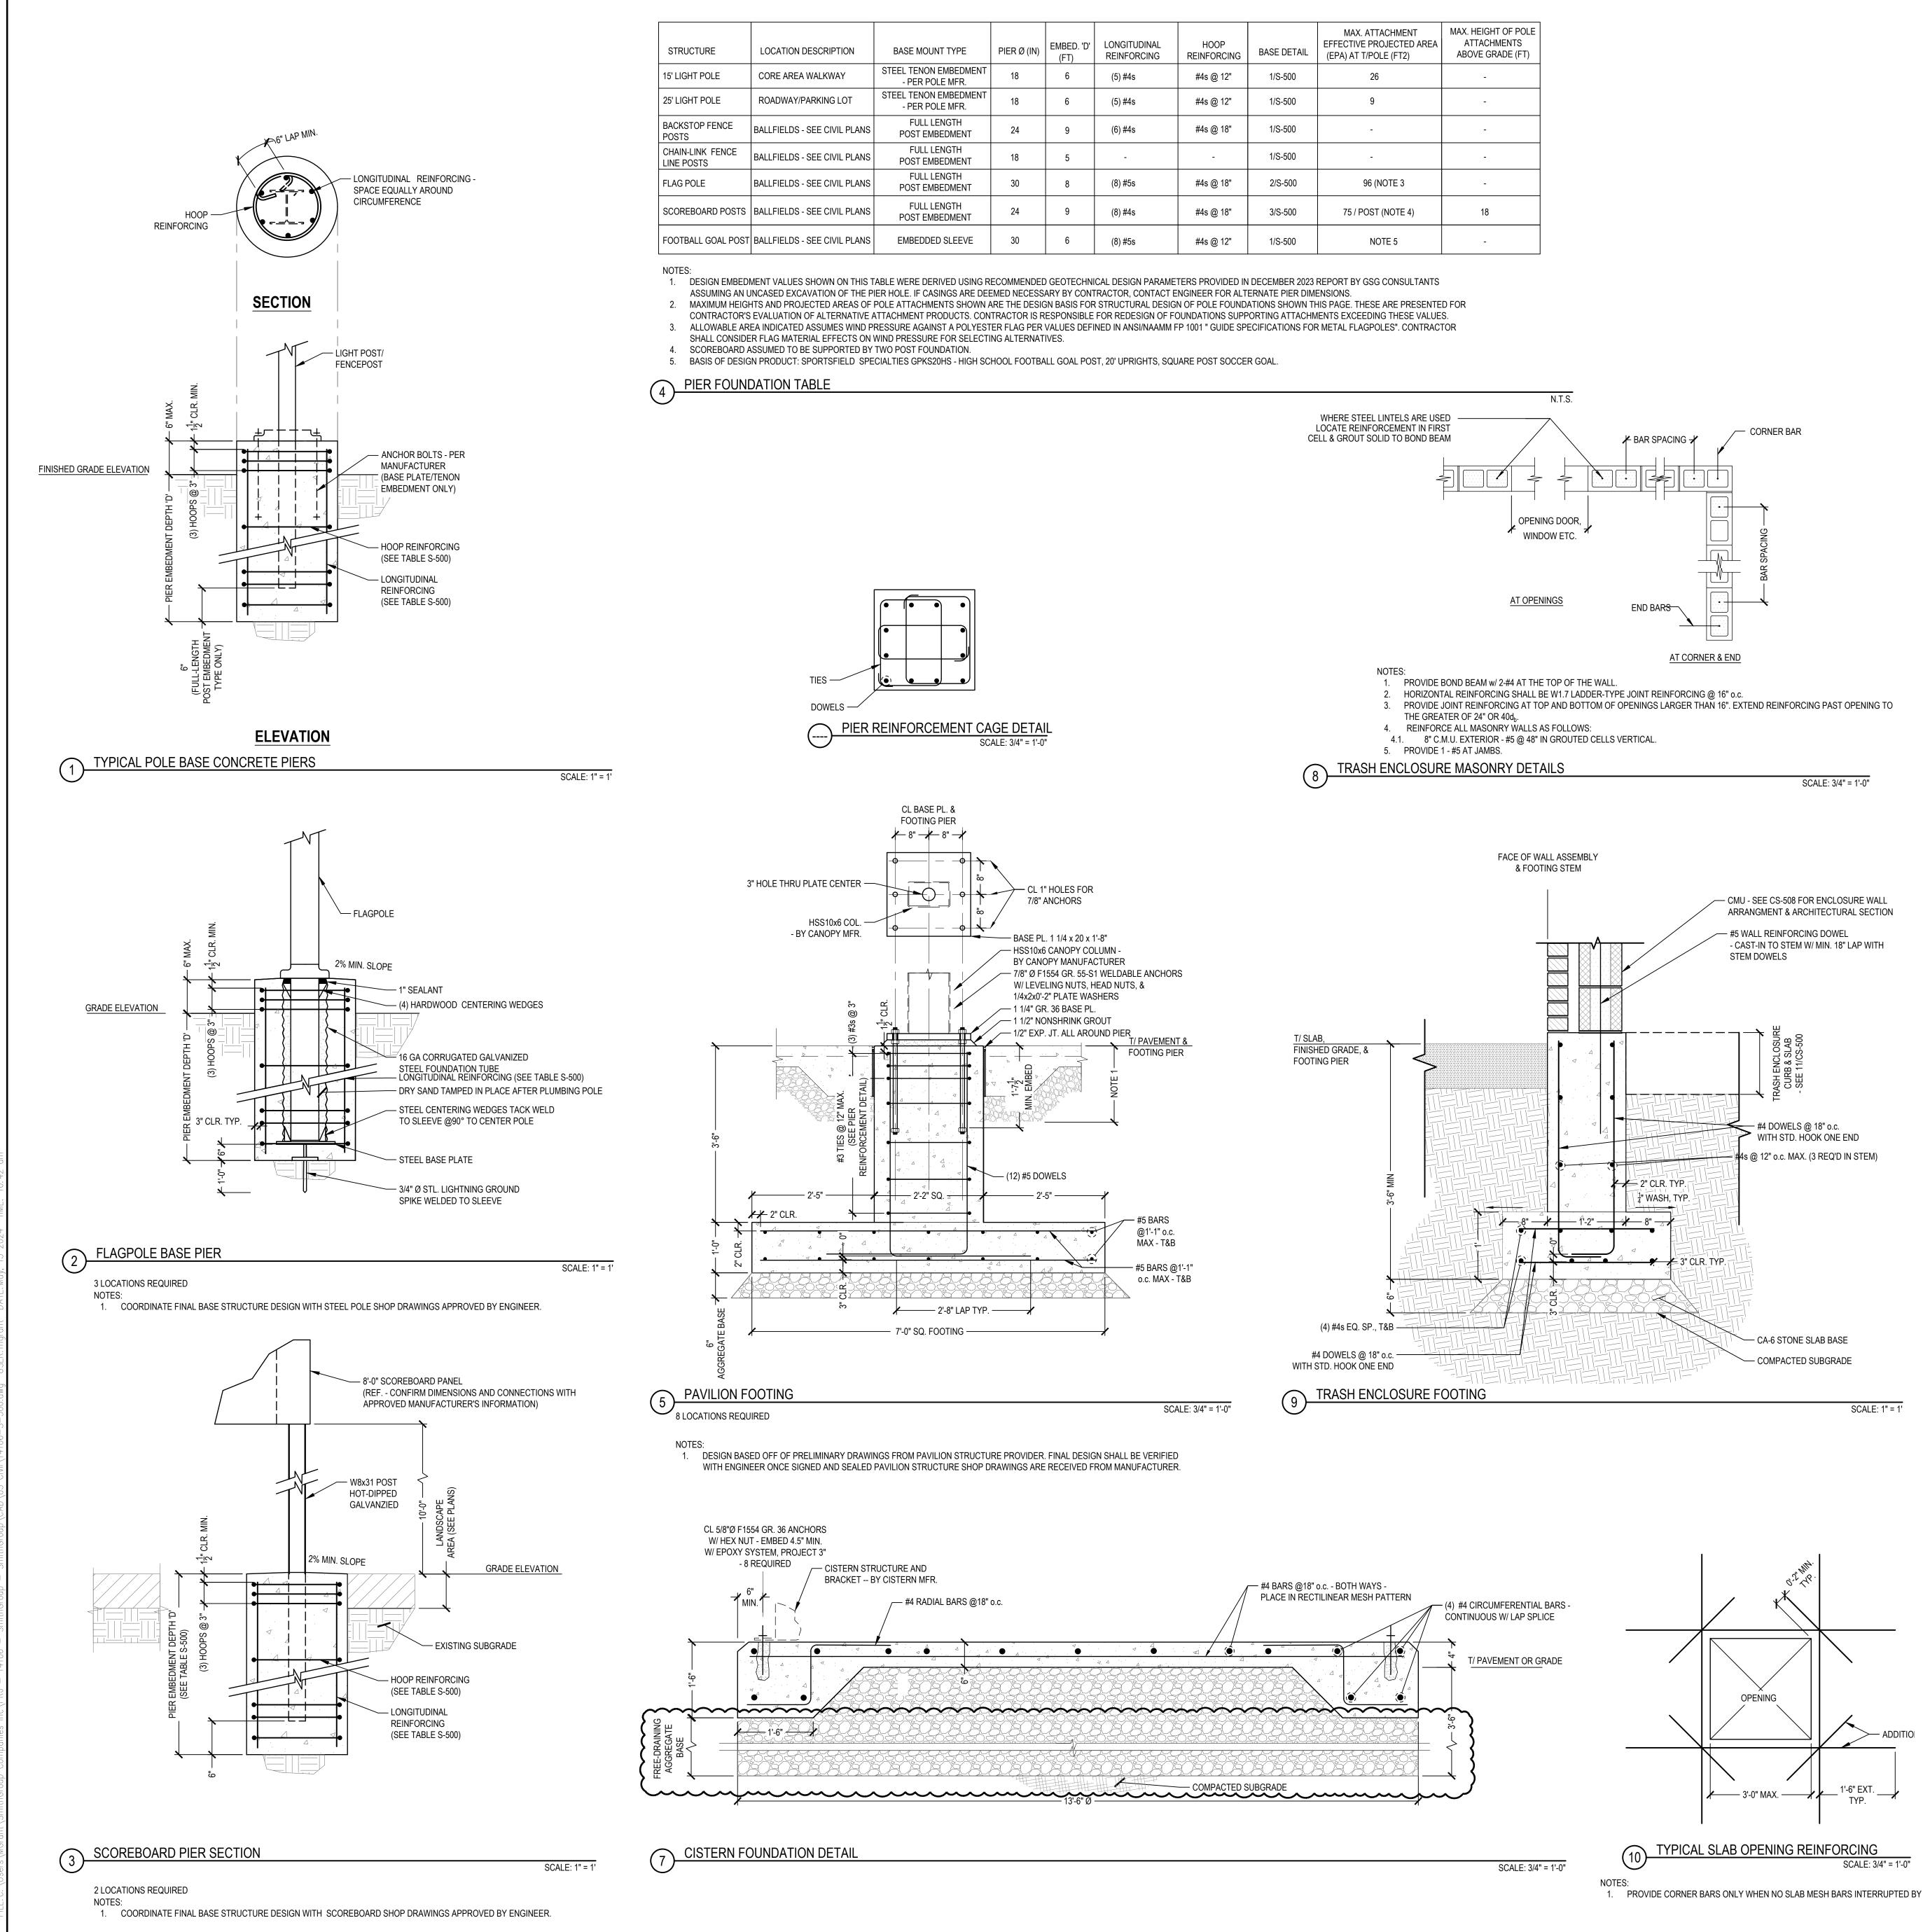

	LOCATION DESCRIPTION	BASE MOUNT TYPE	PIER Ø (IN)	EMBED. 'D' (FT)	LONGITUDINAL REINFORCING	HOOP REINFORCING	BASE DETAIL	MAX. ATTACHMENT EFFECTIVE PROJECTED AREA (EPA) AT T/POLE (FT2)	MAX. HEIGHT OF POLE ATTACHMENTS ABOVE GRADE (FT)
	CORE AREA WALKWAY	STEEL TENON EMBEDMENT - PER POLE MFR.	18	6	(5) #4s	#4s @ 12"	1/S-500	26	-
	ROADWAY/PARKING LOT	STEEL TENON EMBEDMENT - PER POLE MFR.	18	6	(5) #4s	#4s @ 12"	1/S-500	9	-
	BALLFIELDS - SEE CIVIL PLANS	FULL LENGTH POST EMBEDMENT	24	9	(6) #4s	#4s @ 18"	1/S-500	-	-
	BALLFIELDS - SEE CIVIL PLANS	FULL LENGTH POST EMBEDMENT	18	5	-	-	1/S-500	-	-
	BALLFIELDS - SEE CIVIL PLANS	FULL LENGTH POST EMBEDMENT	30	8	(8) #5s	#4s @ 18"	2/S-500	96 (NOTE 3	-
S	BALLFIELDS - SEE CIVIL PLANS	FULL LENGTH POST EMBEDMENT	24	9	(8) #4s	#4s @ 18"	3/S-500	75 / POST (NOTE 4)	18
ST	BALLFIELDS - SEE CIVIL PLANS	EMBEDDED SLEEVE	30	6	(8) #5s	#4s @ 12"	1/S-500	NOTE 5	-

1. PROVIDE CORNER BARS ONLY WHEN NO SLAB MESH BARS INTERRUPTED BY OPENING.

DESIGN CRITERIA

1. 2.	THE INTERNATIONAL BUILDING CODE/2015. DESIGN LOADS: DEAD LOADS: MATERIAL SELF WEIGHT LIVE LOADS: 250 PSF (SLABS SUBJECT TO VEHICULAR LOADING)
	SURCHARGE LOADS: 250 P.S.F. AT ACCESSIBLE PATHWAYS AT GRADE AROUND PARKING AREAS
3.	WIND LOAD: PAVILION & TRASH ENCLOSURE: BASIC WIND SPEED 115 MPH RISK CATEGORY II WIND EXPOSURE C ALL OTHER STRUCTURES: BASIC WIND SPEED 105 MPH RISK CATEGORY I WIND EXPOSURE C

4. SEISMIC LOAD: SEISMIC IMPORTANCE FACTOR: le = 1.0 SITE CLASS D Sd1 = 0.085gSds = 0.151g SEISMIC DESIGN CATEGORY B

STRUCTURAL SPECIAL INSPECTIONS:

- SPECIAL INSPECTIONS SHALL BE PROVIDED IN COMPLIANCE WITH IBC 2015, CHAPTER 17 AND AS NOTED IN THE SCHEDULE IN DIVISION 01 SPECIFICATIONS. THE CONTRACTOR SHALL SUBMIT A WRITTEN STATEMENT OF RESPONSIBILITY TO THE OWNER AND BUILDING CODE OFFICIAL PRIOR TO BEGINNING OF CONSTRUCTION WORK WHICH SHALL
- INCLUDE THE FOLLOWING AS A MINIMUM: A. ACKNOWLEDGEMENT OF RECEIPT OF STATEMENT OF SPECIAL INSPECTIONS AND AWARENESS OF THE REQUIREMENTS CONTAINED WITHIN. B. ACKNOWLEDGEMENT THAT CONTROL WILL BE EXERCISED TO OBTAIN CONFORMANCE WITH
- THE CONSTRUCTION DOCUMENTS APPROVED BY THE BUILDING CODE OFFICIAL C. QUALITY CONTROL PROCEDURES FOR EXERCISING CONTROL WITHIN THE CONTRACTOR'S ORGANIZATION, THE METHOD AND FREQUENCY OF REPORTING AND THE DISTRIBUTION OF
- REPORTS. D. IDENTIFICATION AND QUALIFICATIONS OF THE PERSON(S) EXERCISING SUCH CONTROL AND THEIR POSITION IN THE ORGANIZATION. SEE SPECIFICATIONS FOR ADDITIONAL INSPECTION REQUIREMENTS.

CONCRETE

- STANDARDS 1. A. ACI 318 BUILDING CODE REQUIREMENTS FOR REINFORCED CONCRETE (2014 EDITION).
- ALL DETAILING, FABRICATION AND ERECTION FOR REINFORCING BARS AND THEIR SUPPORT IN THE FORMS WITH ACCESSORIES MUST FOLLOW THE ACI "MANUAL OF STANDARD PRACTICE FOR DETAILING REINFORCED CONCRETE STRUCTURES", (ACI 315-
- LATEST) AND CRSI "MANUAL OF STANDARD PRACTICE" (LATEST EDITION). MINIMUM CONCRETE COVER, UNLESS NOTED OTHERWISE:
- A. UNFORMED SURFACE IN CONTACT WITH THE GROUND. 3 IN. B. FORMED SURFACES EXPOSED TO EARTH OR WEATHER #6 BAR AND LARGER.
- 2 IN. FORMED SURFACES EXPOSED TO EARTH OR WEATHER 1 1/2 IN. #5 BAR AND SMALLER. C. FORMED SURFACES NOT EXPOSED TO EARTH OR WEATHER:
- 1. WALLS, SLABS 3/4 IN. 2. BEAMS, GIRDERS AND COLUMNS 1 1/2 IN. (TO TIES OR STIRRUPS)
- CONCRETE SHALL HAVE A 28-DAY COMPRESSIVE STRENGTH AND DENSITY, IN ACCORDANCE WITH THE FOLLOWING:

ALL CONCRETE - AIR ENTRAINED

DEVELOPMENT LENGTHS AND LAP SPLICES SHALL BE IN ACCORDANCE WITH TABLE BELOW AND ACI 318 BUILDING 5. ACI 318 BUILDING CODE. REQUIREMENTS FOR REINFORCED CONCRETE (LATEST EDITION) WHERE CLASSES ARE NOT CALLED ON DRAWINGS, USE CLASS "B" SPLICES.

4500

145

CONCRETE REINFORCEMENT DEVELOPMENT LENGTHS (UNLESS NOTED OTHERWISE ON DRAWINGS)								
BAR SIZE	LENGTH OF LAPPED SPLICES FOR REINF. (INCHES)							
	*TOP BARS	OTHERS						
3	19	15						
4	25	19						
5	31	24						
6	37	29						
7	54	42						
8	62	48						

		ENT SPLICE LENGT WISE ON DRAWING					
BAR SIZE	LENGTH OF LAPPED SPLICES FOR REINF. (INCHES)						
	*TOP BARS	OTHERS					
3	25	20					
4	33	25					
5	41	32					
6	49	38					
7	71	55					
8	81	71					

SPLICE LENGTH NOTE * TOP BARS ARE HORIZONTAL BARS SO PLACED THAT MORE THAN 12" OF CONCRETE IS CAST IN THE MEMBER BELOW THE BAR. HORIZONTAL BARS IN WALLS ARE TO BE PROVIDED WITH LAP LENGTHS AS REQUIRED FOR TOP BARS. VERTICAL BARS MAY BE CONSIDERED AS OTHER BARS.

REINFORCING BARS SHALL BE ASTM A615-GRADE 60 STEEL, U.N.O. WELDED WIRE FABRIC SHALL CONFORM TO ASTM A185. WELDED WIRE FABRIC MUST LAP AT LEAST 2" SIDE AND 6" AT ENDS AND BE WIRED TOGETHER. ASTM A-706 REINFORCING BARS SHALL BE UTILIZED WHERE NOTED ON PLANS


FOUNDATION NOTES:


- 1. FOUNDATIONS HAVE BEEN DESIGNED BASED ON A SOILS REPORT DATED 12/19/2023 ISSUED BY GSG CONSULTANTS. SHALLOW AND MAT FOUNDATIONS: 2.
 - A. SPREAD AND STRIP FOOTINGS DESIGNED FOR A NET ALLOWABLE BEARING PRESSURE OF 3000 PSF FOR DEAD LOAD PLUS MAXIMUM LIVE LOAD.
 - B. ANY DISTURBED, LOOSE, OR SOFT MATERIAL THAT IS ENCOUNTERED IN FOUNDATION EXCAVATIONS SHOULD BE REMOVED PRIOR TO THE PLACEMENT OF CONCRETE.
 - C. MAT FOUNDATION SHALL BEAR ON CONTROLLED/ENGINEERED FILL WITH NEW ALLOWABLE PRESSURE OF 2000 PSF. SEE GEOTECHNICAL REPORT FOR OEVEREXCAVATIONS/PROOFROLLING, AND ENGINEERED FILL REQUIRED.
- ALL FILL SHALL BE PLACED IN EIGHT INCH LOOSE LIFTS (MAXIMUM) COMPACTED WITH VIBRATORY ROLLERS. FILL MATERIAL SHALL BE TESTED BY STANDARD PROCTOR DENSITY METHOD (ASTM D698) AND MUST QUALIFY AS SELECT, WITH LESS THAN 10% PASSING THROUGH THE NO. 200 SIEVE. SOIL SHALL BE PLACED WITH MOISTURE CONTENT AND ENERGY TO PROVIDE 92% OF MAXIMUM DRY DENSITY BELOW SLABS ON GRADE AND 95% BELOW FOOTINGS. IN PLACE DENSITY TESTS SHALL BE TAKEN FOR EACH 10,000 SF IN EACH LIFT. FOR ACCEPTABLE OF SOIL, AVERAGE DENSITY TEST MUST EXCEED THE SPECIFIED COMPACTION. NO TESTS SHALL BE PERMITTED TO FALL BELOW 88% COMPACTION BELOW SLABS ON
- GRADE OR 90% COMPACTION BELOW FOOTINGS. WHERE GRANULAR SOILS ARE ENCOUNTERED, EXCAVATIONS FOR FOUNDATIONS SHALL BE NO STEEPER THAN 1.5H:1.0V. OTHERWISE, EXCAVATIONS SHALL BE NO STEEPER THAN 1.0H:1.0V.


MISCELLANEOUS


- STRUCTURAL DRAWINGS ARE INTENDED TO BE USED WITH LANDSCAPE AND CIVIL 1. DRAWINGS. CONTRACTOR IS RESPONSIBLE FOR COORDINATING SUCH REQUIREMENTS INTO
- THEIR SHOP DRAWINGS AND WORK. THE CONTRACTOR IS RESPONSIBLE FOR LIMITING THE AMOUNT OF CONSTRUCTION LOAD IMPOSED UPON STRUCTURAL FRAMING. CONSTRUCTION LOADS SHALL NOT EXCEED THE DESIGN
- CAPACITY OF THE FRAMING AT THE TIME THE LOADS ARE IMPOSED. THE STRUCTURE IS DESIGNED TO FUNCTION AS A UNIT UPON COMPLETION. THE CONTRACTOR IS RESPONSIBLE FOR FURNISHING ALL TEMPORARY BRACING AND/OR SUPPORT THAT MAY BE REQUIRED AS THE RESULT OF THE CONTRACTOR'S CONSTRUCTION METHODS AND/OR SEQUENCES.
- DO NOT SCALE THESE DRAWINGS, USE DIMENSIONS. CONTRACTOR'S CONSTRUCTION AND/OR ERECTION SEQUENCES SHALL RECOGNIZE AND CONSIDER THE EFFECTS OF THERMAL MOVEMENTS OF STRUCTURAL ELEMENTS DURING THE
- CONSTRUCTION PERIOD. EXPANSION JOINTS SHOWN ON THE DRAWINGS HAVE BEEN DESIGNED TO ACCOMMODATE ANTICIPATED THERMAL MOVEMENT AFTER THE BUILDING IS COMPLETE.
- THE DESIGN AND ENGINEERING OF SHORING NOTED ON THE DRAWINGS AND IN THE SPECIFICATIONS OR REQUIRED BY THE CONTRACTOR'S CONSTRUCTION METHODS, AS WELL AS
- ITS CONSTRUCTION, SHALL BE THE RESPONSIBILITY OF THE CONTRACTOR. SEE PROJECT SPECIFICATIONS FOR ADDITIONAL INFORMATION.




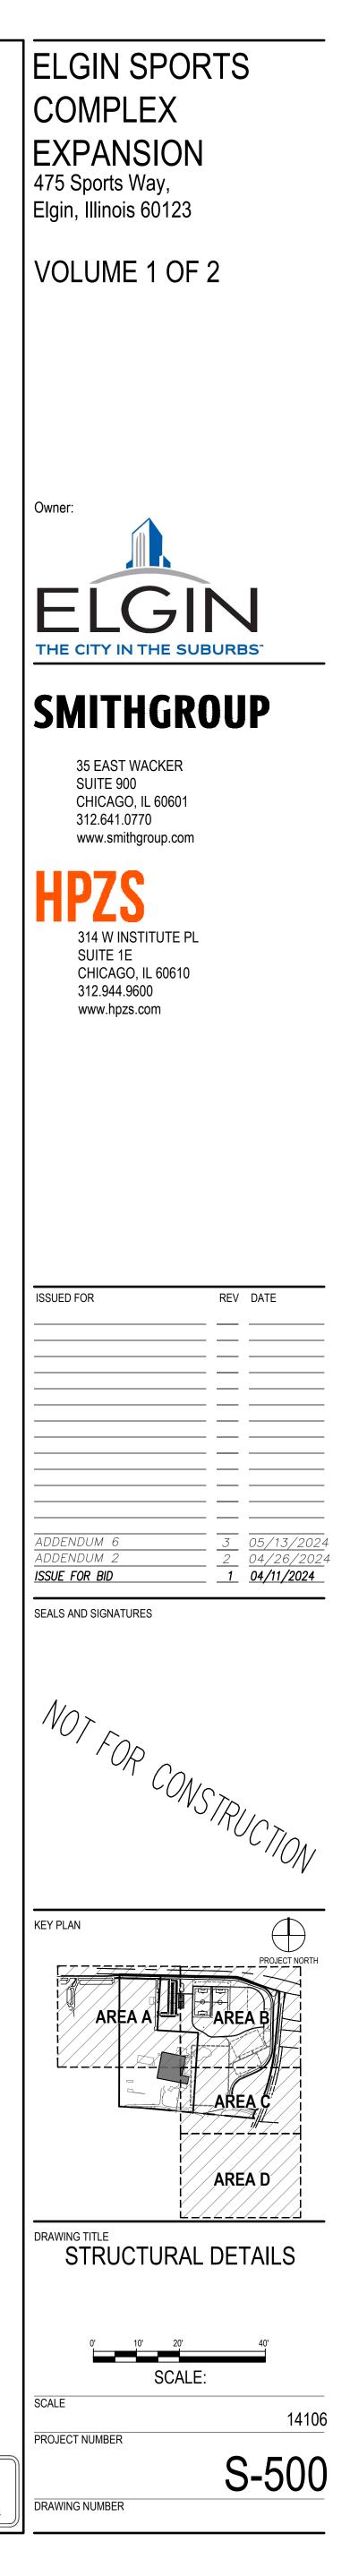

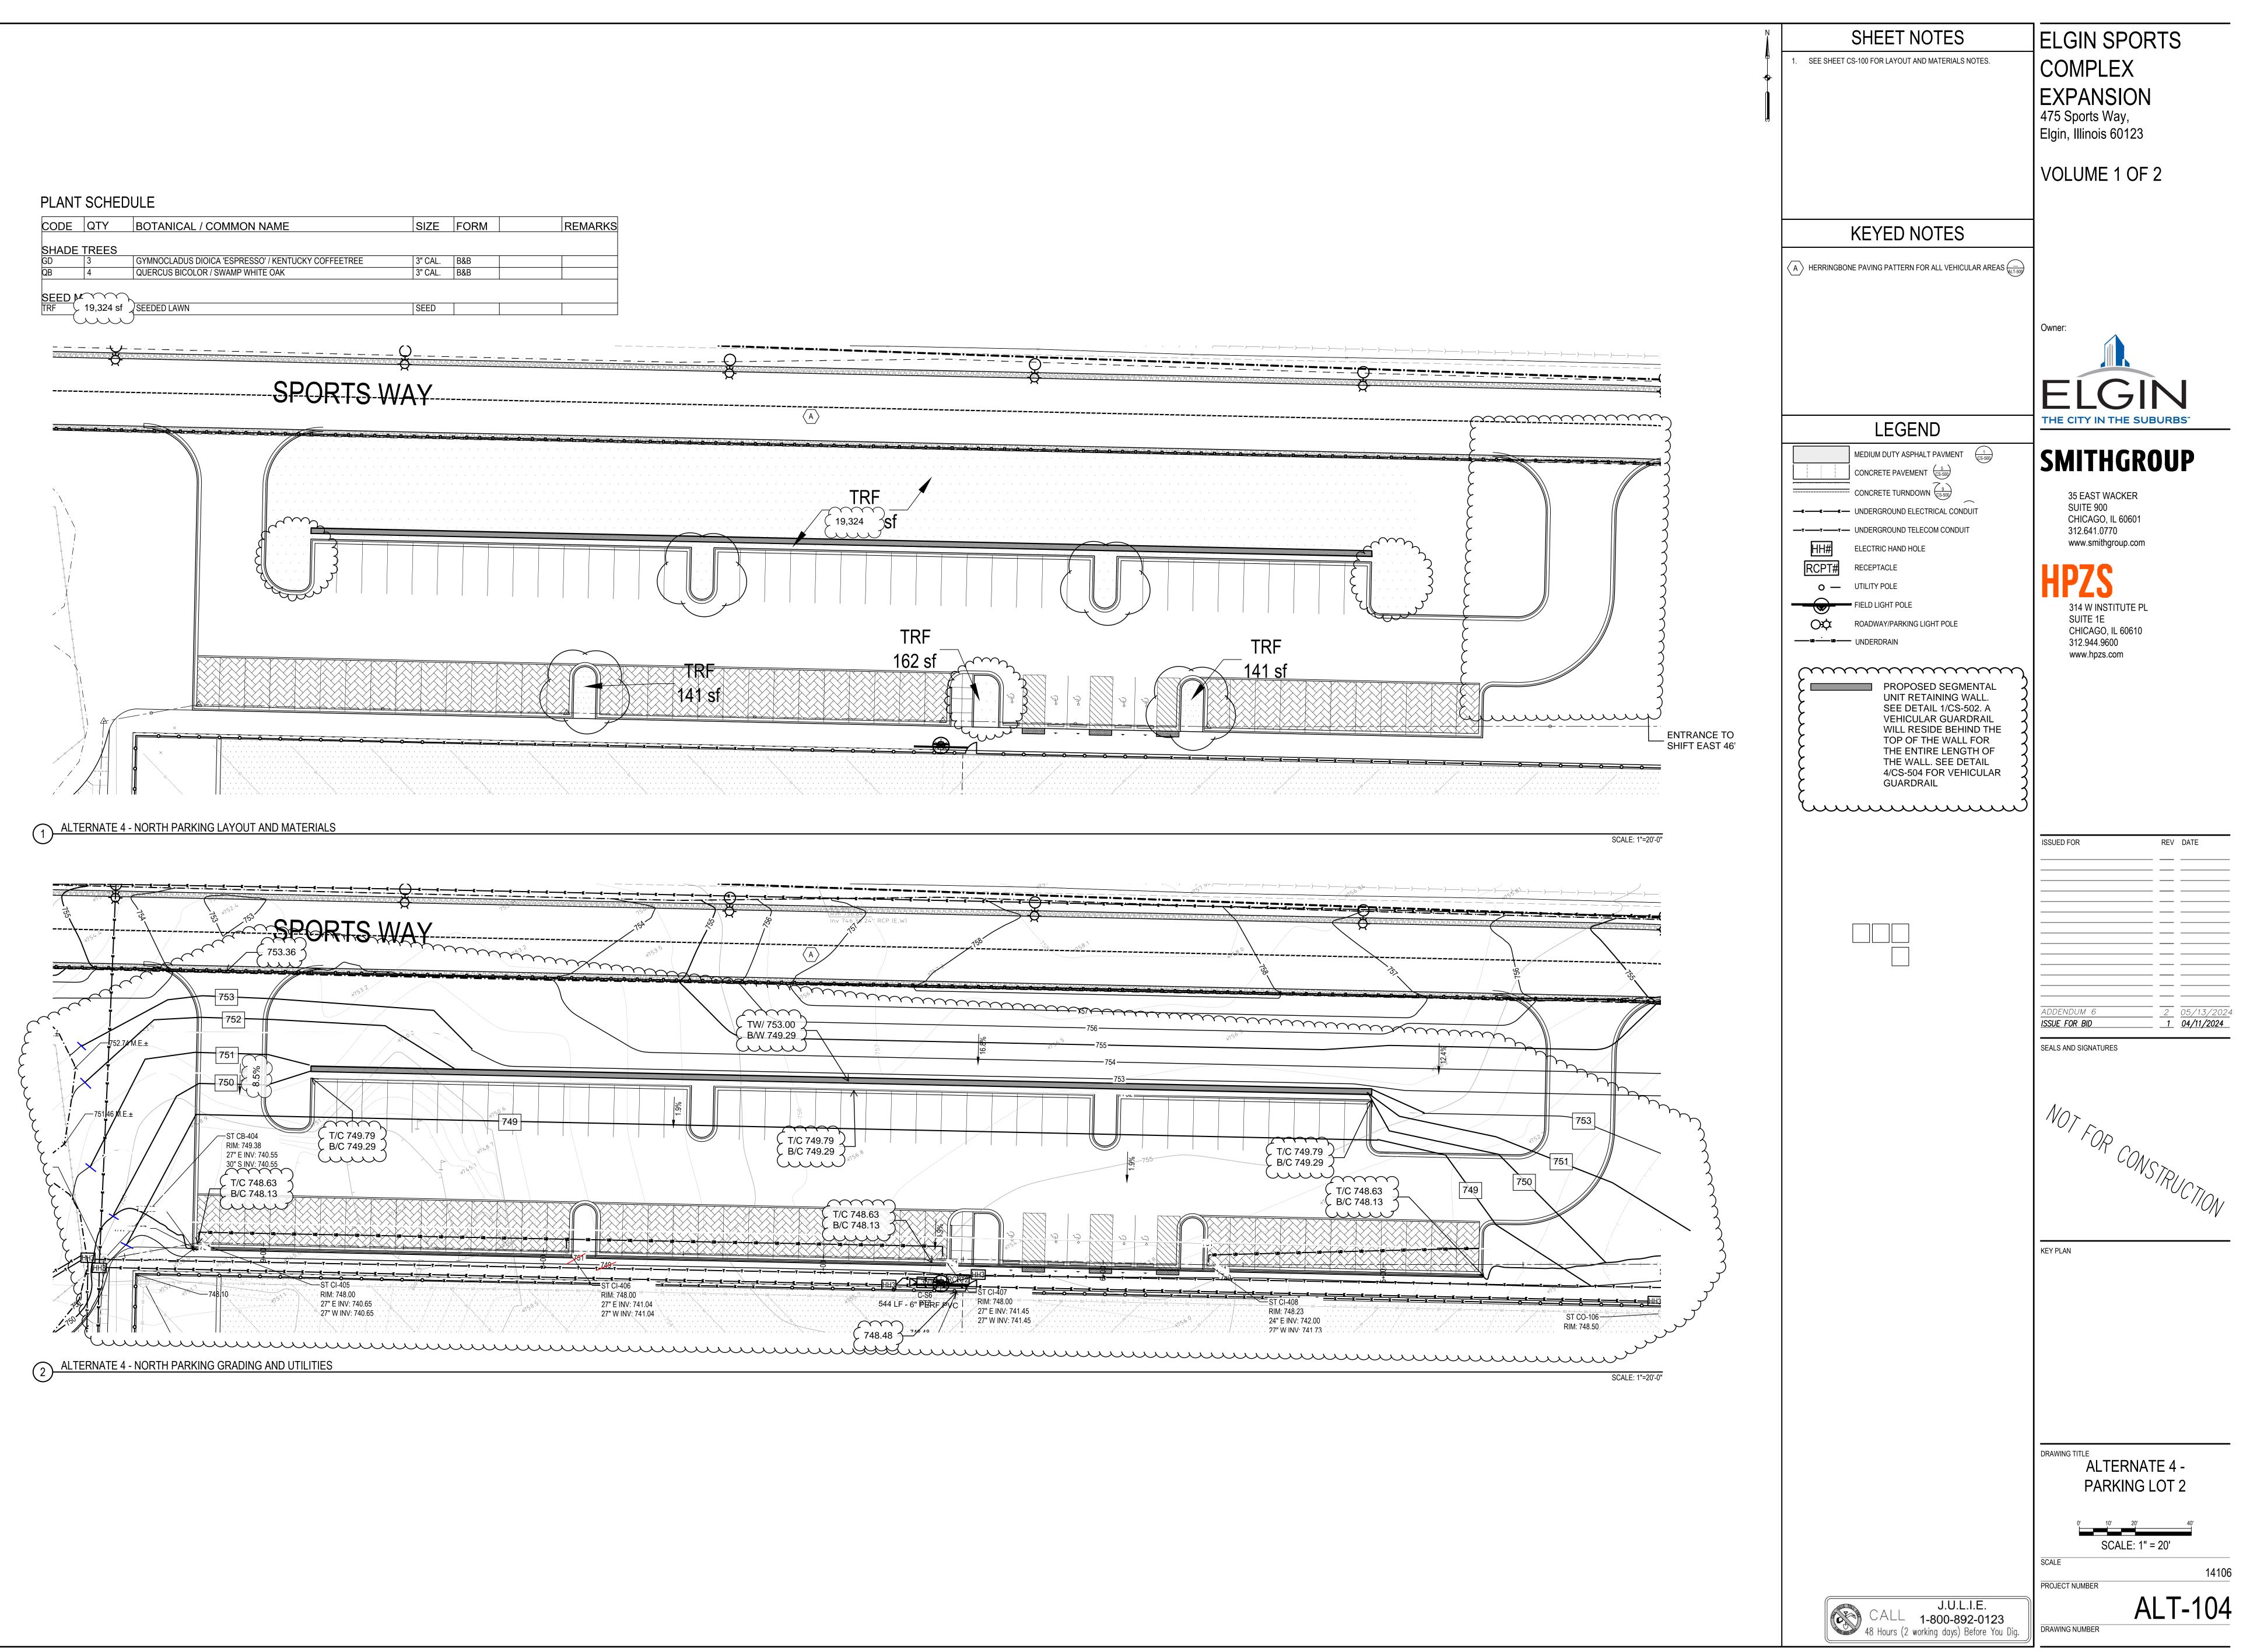

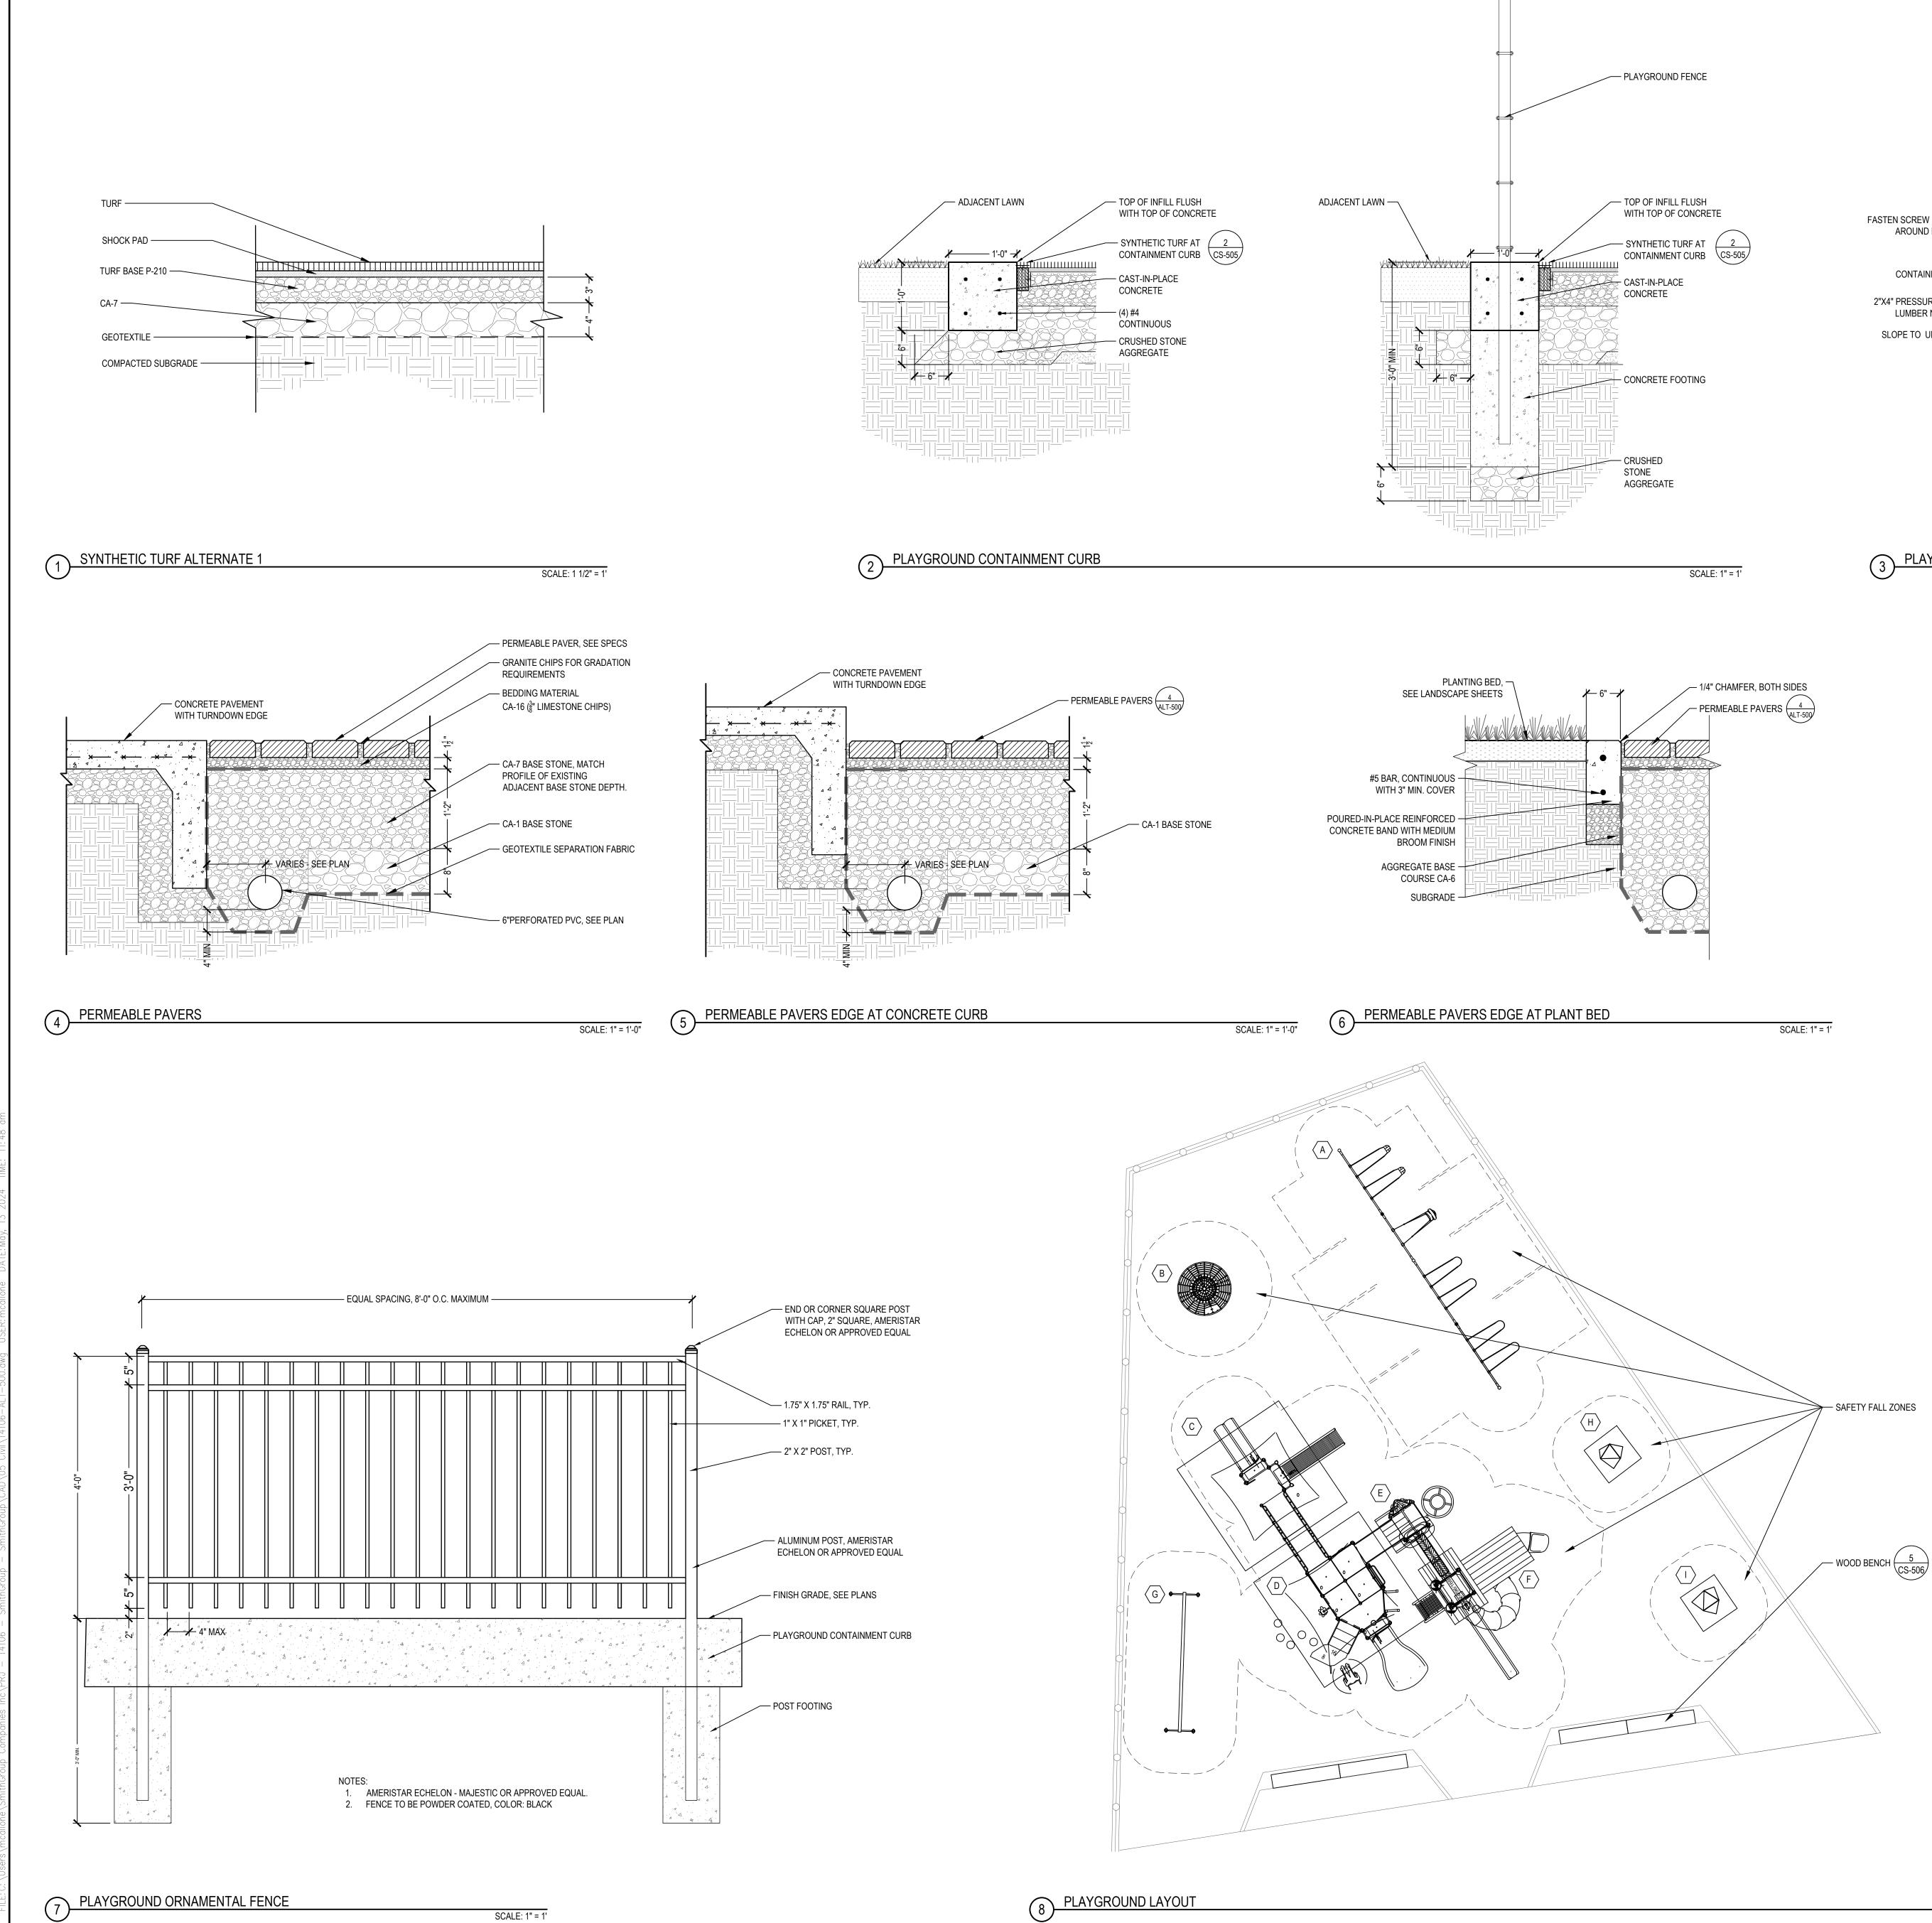

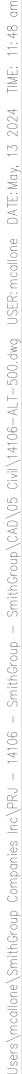

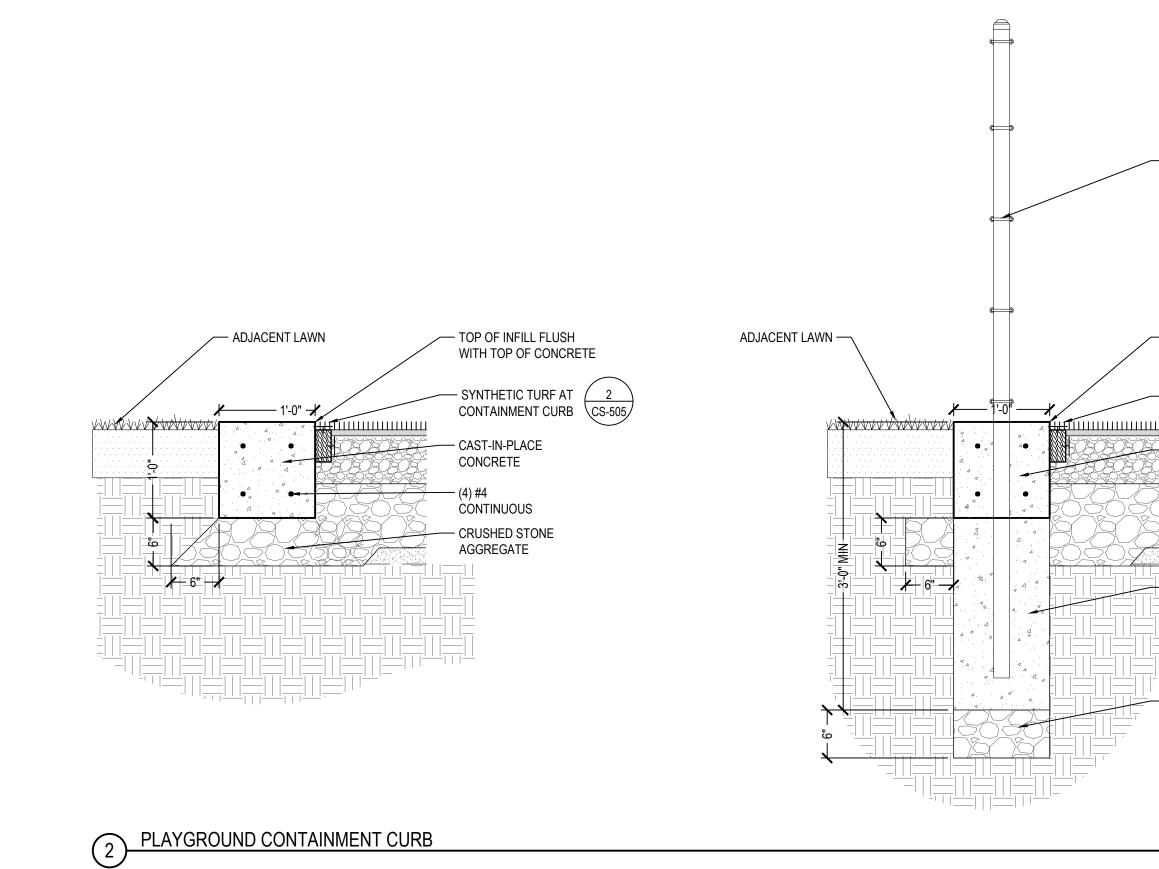



- PLAYGROUND TURF FASTEN SCREW EVERY 4"-6" \sim AROUND PERIMETER - 2LBS INFILL PER SQ. FT. — FOAM PAD, THICKNESS PER MANUFACTURER SPECIFICATIONS. CONTAINMENT CURB -2"X4" PRESSURE TREATED -LUMBER NAIL BOARD _____ 4" CA-7 SLOPE TO UNDERDRAIN ~ GEOTEXTILE FABRIC COMPACTED SUBGRADE _____


3 PLAYGROUND TURF

PLAYGROUND SCHEDULE												
KEY	ITEM	QTY	FALL HT	MANUFACTURER	CONTACT							
A	SWINGS	1	8 FT	LITTLE TIKES COMMERCIAL	PARKREATION (847)419-7744							
В	CONE SPINNER	1	10 FT	LITTLE TIKES COMMERCIAL	PARKREATION (847)419-7744							
С	ROLLER SLIDE AND DOUBLE WIDE SLIDE	1	4 FT	LITTLE TIKES COMMERCIAL	PARKREATION (847)419-7744							
D	INFINITY & DOUBLE WALL CLIMBERS, SLALOM SLIDE, COUNTER PANEL & TRANSFER STATION	1	4 FT	LITTLE TIKES COMMERCIAL	PARKREATION (847)419-7744							
E	SILO SCRAMBLE, ROCK CHALLENGE WALL, & OVERHEAD CLIMBER UNDER CATWALK BRIDGE	1	8 FT	LITTLE TIKES COMMERCIAL	PARKREATION (847)419-7744							
F	X TOWER	1	8 FT	LITTLE TIKES COMMERCIAL	PARKREATION (847)419-7744							
G	ZIPLINE	1	8 FT	LITTLE TIKES COMMERCIAL	PARKREATION (847)419-7744							
н	10' STONE BOULDER	1	10 FT	LITTLE TIKES COMMERCIAL	PARKREATION (847)419-7744							
I	12' STONE BOULDER	1	12 FT	LITTLE TIKES COMMERCIAL	PARKREATION (847)419-7744							

SCALE: 1 1/2" = 1'

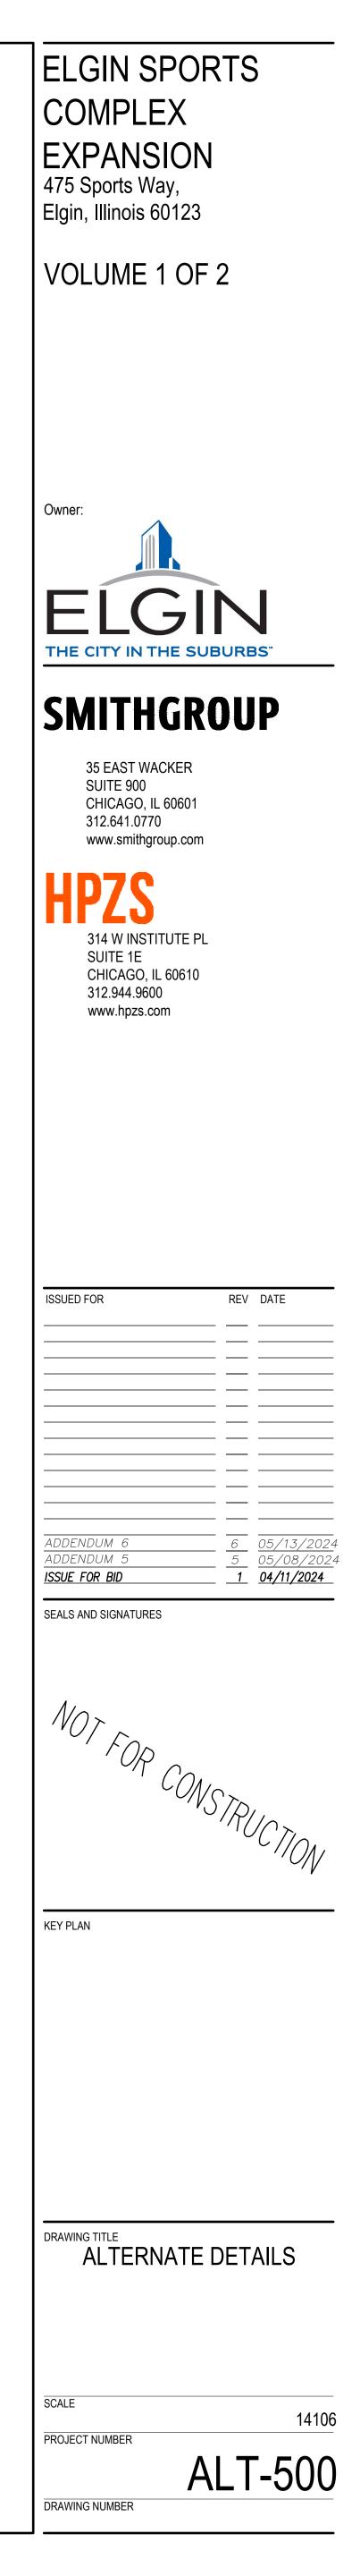

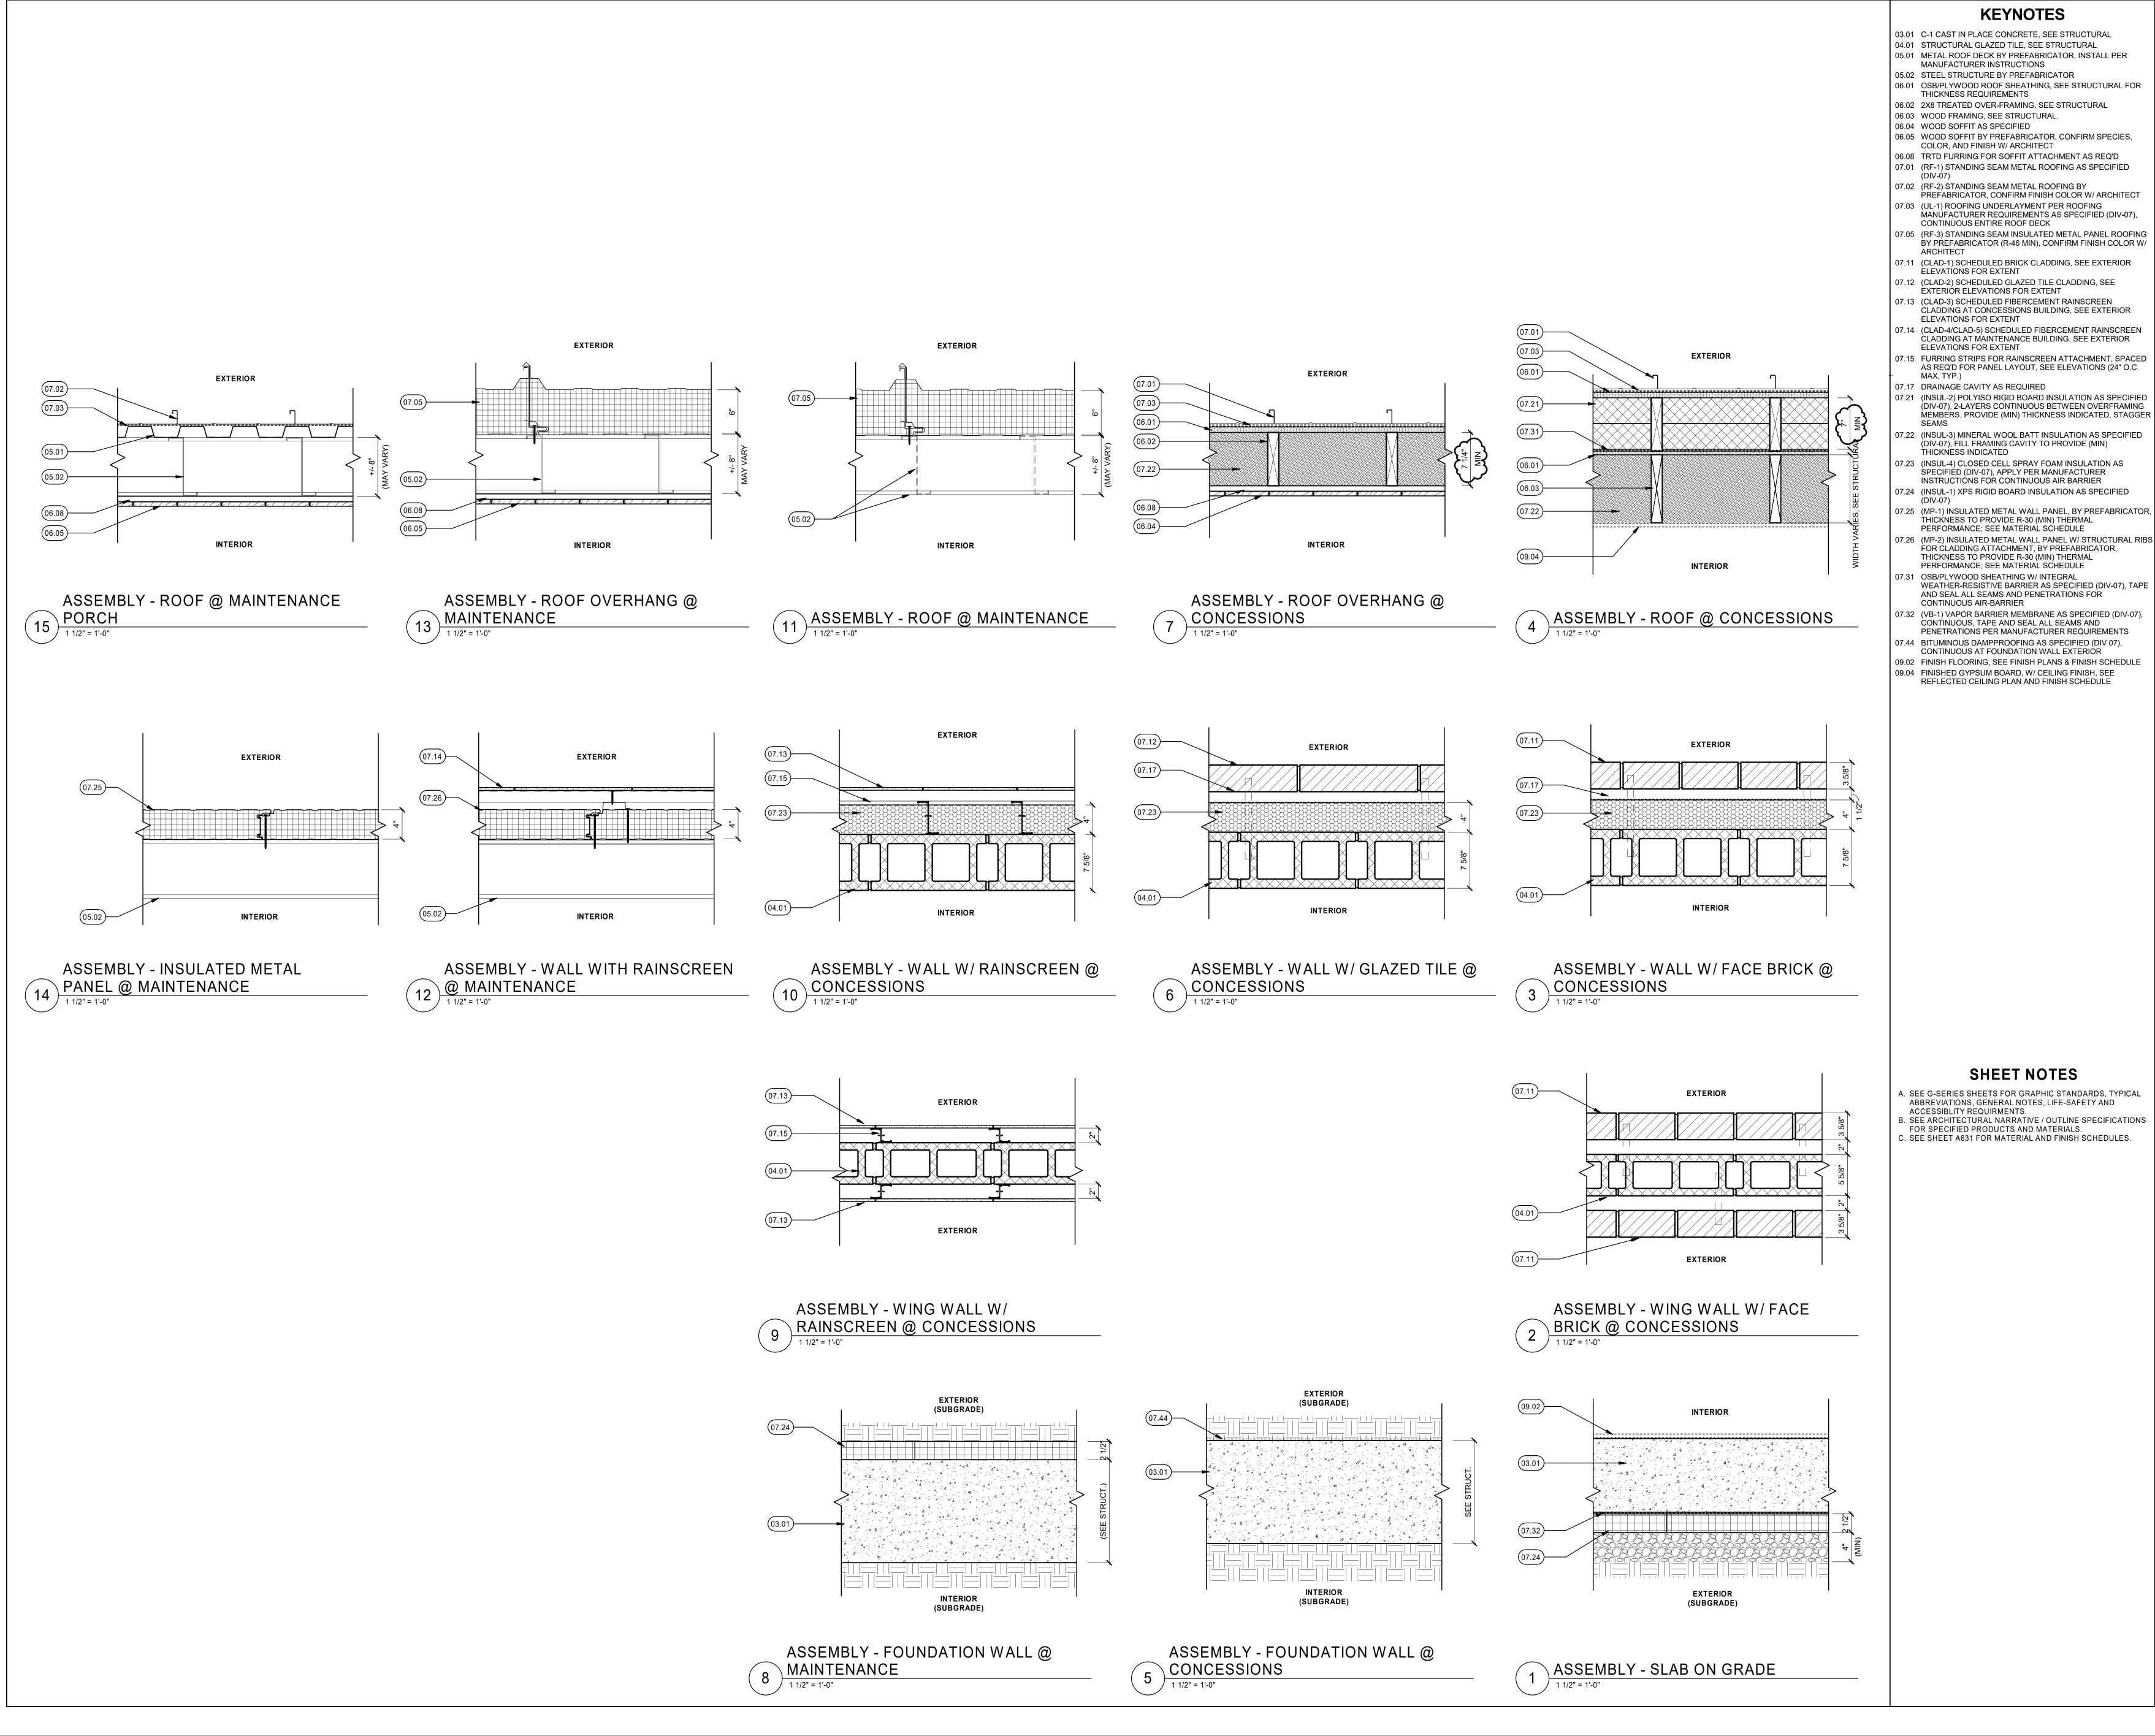


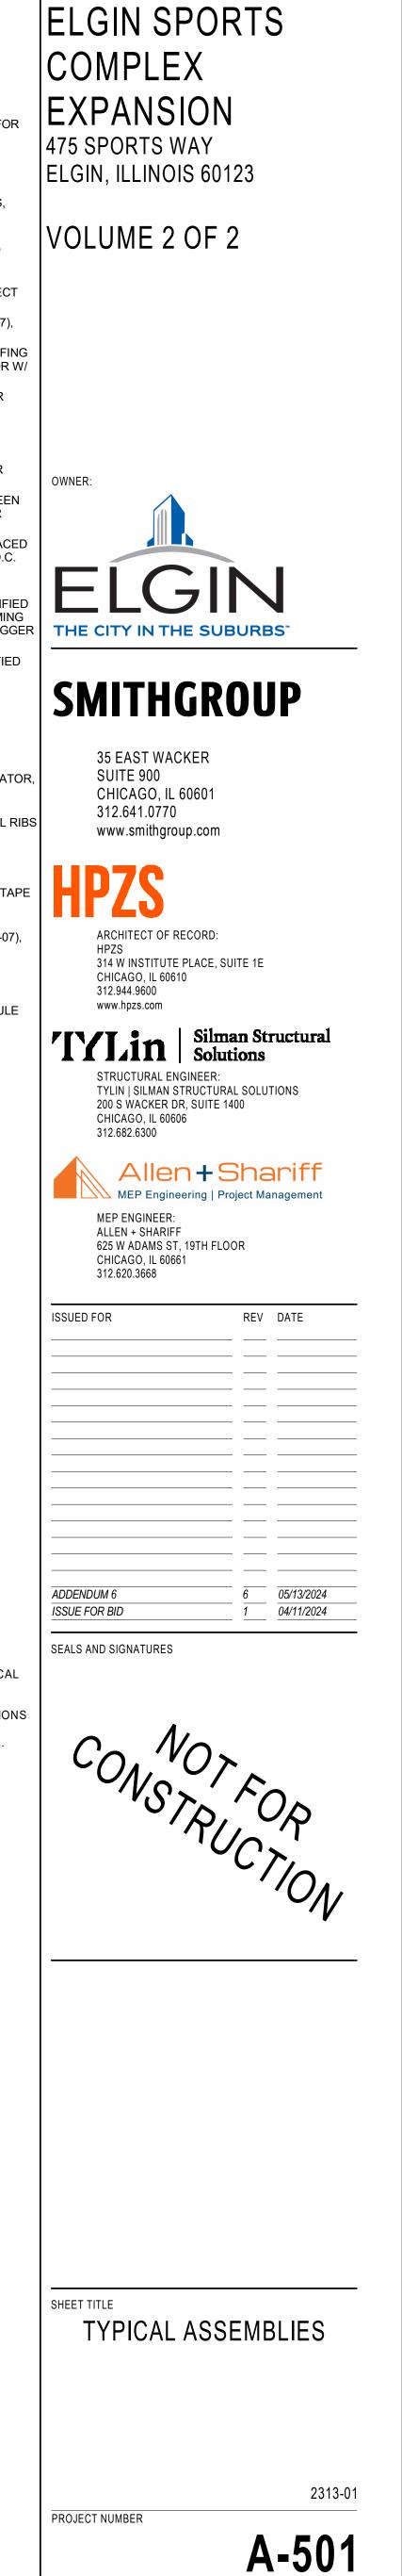

SHEET NUMBER

DIMENSIONS	OR FRAME CONSTRUCTION HARDWARE	
ROOM NAME WARK HEIGHT HOUTH	DOOR TYPE MATERIAL MATERIAL FINISH FINISH FINISH MATERIAL MATERIAL MATERIAL MATERIAL MATERIAL MATERIAL MATERIAL HEAD FINISH HEAD FINISH HEAD KNURLED KNURLED	
DNCESSIONS 100 3'-0" 7'-10" 1 3/4" BOH 101 2'-6" 7'-0" 1 3/4" MECH/ELEC 102 2'-6" 7'-0" 1 3/4" FAMILY 103 3'-0" 7'-10" 1 3/4" WOMEN'S RESTROOM 104 3'-0" 7'-10" 1 3/4" MEN'S RESTROOM 105 3'-0" 7'-10" 1 3/4"	FHM, INSULPT (MATCH EMT-1)1HM, INSULPT (MATCH EMT-1)3/A-53111/A-5317/A-531001YesINSULATED EXTERIOR DOORNHMPT (MATCH EMT-1)1HMPT (MATCH EMT-1)100NARROW LIGHTFHMPT (MATCH EMT-1)1HMPT (MATCH EMT-1)101YesFHM, INSULPT (MATCH EMT-1)1HM, INSULPT (MATCH EMT-1)101YesFHM, INSULPT (MATCH EMT-1)3/A-53111/A-5317/A-531003YesINSULATED EXTERIOR DOORFHM, INSULPT (MATCH EMT-1)3/A-53111/A-5317/A-531002YesINSULATED EXTERIOR DOOR	
CORRIDOR M100 3'-0" 7'-0" 1 3/4" OFFICE 1 M101 3'-0" 7'-0" 1 3/4" MECHANICAL ROOM M102 3'-0" 7'-0" 1 3/4" RESTROOM M103 3'-0" 7'-0" 1 3/4" STORAGE ROOM M103 3'-0" 7'-0" 1 3/4" OFFICE 2 M105 3'-0" 7'-0" 1 3/4" CORRIDOR M106A 3'-0" 7'-0" 1 3/4" EQUIPMENT STORAGE AREA M106B 3'-0" 7'-0" 1 3/4" EQUIPMENT STORAGE AREA M106C 17'-10" 8'-0" 1 1/2"	F HM, INSUL PT (MATCH EMT-1) 1 HM, INSUL PT (MATCH EMT-1) 7/A-532 9/A-532 8/A-532 001 Yes INSULATED EXTERIOR DOOR F HM PT (MATCH EMT-1) 1 HM PT (MATCH EMT-1) - - - 102 Yes INSULATED EXTERIOR DOOR F HM PT (MATCH EMT-1) 1 HM PT (MATCH EMT-1) - - - 102 Yes INSULATED EXTERIOR DOOR F HM PT (MATCH EMT-1) 1 HM PT (MATCH EMT-1) - - - 103 Yes F HM PT (MATCH EMT-1) 1 HM PT (MATCH EMT-1) - - - 103 Yes F HM PT (MATCH EMT-1) 1 HM PT (MATCH EMT-1) - - - 103 Yes F HM PT (MATCH EMT-1) 1 HM PT (MATCH EMT-1) - - - 102 Yes INSULATED EXTERIOR DOOR	2 <u>HEADER ISOMETRI</u>
		OPENING WIDTH UDH OBENING I
		F N
REFERENCE LOCATIONS	DOOR AND FRAME GENERAL NOTES	DIVISION 08 71 00 B
1.01 SEE G-SERIES SHEETS FOR GRAPHIC STANDARDS, TYPICAL ABBREVIATIONS, GENERAL NOTES, LIFE-SAFETY AND ACCESSIBLITY REQUIRMENTS.	 2.10 DOORS FROM 7'-6" TO 10'-0" TO RECEIVE 2 PAIRS OF HINGES 2.21 ALL DOORS WITH CLOSERS TO RECEIVE BALL BEARING HINGES. 2.11 CONTRACTOR TO SUBMIT CUTS OF ALL HARDWARE TO 2.22 ALL FIRE RATED DOORS TO RECEIVE BALL BEARING HINGES. 	EXTERIOR SET 001
1.02 REFER TO SHEET A-601 FOR PARTITION TYPE DETAILS.	ARCHITECT FOR APPROVAL PRIOR TO ORDERING. 2.23 ALL DOORS WITH ELECTRIC LOCKS TO RECEIVE AN ELECTRIC 2.12 PROVIDE RUBBER SILENCER PADS ON ALL DOOR BUCKS. 2.23 ALL DOORS WITH ELECTRIC LOCKS TO RECEIVE AN ELECTRIC	SEI 001 DOORS: 100, M100 4 HINGES 5 STS FBB191 4.5" X 1 STOREROOM LOCKSET 4 STOREROOM LOCKSET 4 STOREROOM LOCKSET 4 STOREROOM LOCKSET 4 STOREROOM LOCKSET
 ALL LOCKS TO BE KEYED AND MASTERED TO BUILDING KEY SYSTEM. TWO INDIVIDUAL KEYS TO BE SUPPLIED TO OWNER. ALL KEYING TO BE COMPATIBLE WITH BUILDING STANDARD 	2.13 ALL HARDWARE TO BE INSTALLED ACCORDING TO THE 2.24 ALL PAIR OF DOORS WITH ELECTRIC STRIKES TO RECEIVE AN 2.13 ALL HARDWARE TO BE INSTALLED ACCORDING TO THE 2.24 ALL PAIR OF DOORS WITH ELECTRIC STRIKES TO RECEIVE AN 2.13 STANDARDS OF MANUFACTURERS. 2.24 ALL PAIR OF DOORS WITH ELECTRIC STRIKES TO RECEIVE AN 2.13 STANDARDS OF MANUFACTURERS. 2.25 GENERAL CONTRACTOR TO SUPPLY ALL LOCKS AND PREPARE	1CYLINDERPRIMOS (MATCH (MATCH ()1LOCK ASTRAGAL50011DOOR CLOSERQDC120 R SHCNS1KICK PLATEK0050 10" X 2" LD'1PERIMETER SEAL161SA @ HEAD &
CYLINDER/ KEYING SYSTEM AND COORDINATED WITH BUILDING. BLDG STANDARD CYLINDER IS [6 PIN.] .03 ALL EXISTING TO REMAIN HOLLOW METAL CORE DOORS AND	2.14 ALL LOCKSET/LATCHSET LEVERS, KNOBS, OR PULLS TO [BE 3'-2" DOORS TO RECEIVE SECURITY DEVICES. A.F.F. TO CENTERLINE, U.O.N.] [MATCH EXISTING] 2.26 SECURITY VENDOR TO TERMINATE THE WIRING TO THE	1 DOOR SWEEP C697A 1 THRESHOLD AS REQUIRED (PE
FRAMES TO BE PAINTED SEMI-GLOSS TO MATCH ADJACENT WALL FINISH U.N.O.	 2.15 ALL FIRE RATED DOORS SHALL BE LABELED ACCORDINGLY AS REQUIRED BY CODE. 2.16 ALL DOUBLE DOORS TO HAVE RH ACTIVE, UNLESS OTHERWISE 2.17 WIRING TO BE SPECIFIED BY SECURITY VENDOR AND WILL BE RUN AND SUPPLIED BY CONSTRUCTION MANAGER. 	DOORS: 104, 105 4 HINGES STS FBB199 4.5" X 1 CLASSROOM DEADLOCK 48H-7R L/C 1 CYLINDER PRIMUS (MATCH O
 ALL HOLLOW METAL FRAMES TO BE WELDED. PROVIDE CAULK SEALANT AT ALL DOOR AND FRAME/WALL CONDITIONS. ALL DOOR AND FRAMES TO BE NEW, U.O.N 	NOTED. 2.28 SECURITY VENDOR TO COORDINATE ALL SECURITY DEVICES 2.17 THE GENERAL CONTRACTOR SHALL INSTALL DOORS COMPLETE WITH BUILDING SYSTEM. WITH ALL HARDWARE FITTINGS AND ACCESSORIES AS	1PUSH PLATE1802-25CC-PH1PULL PLATE1802-25CC-PL1DOOR CLOSERQDC115 R EDA1OVERHEAD STOPN1020 SERIES
ALL NEW ELECTRONIC HARDWARE TO BE TIED INTO BASE BLDG FIRE COMMAND STATION.	REQUIRED FOR SPECIFIC INSTALLATION. FURNISH ANY SPECIAL ITEMS REQUIRED FOR CODE COMPLIANCE AT SPECIAL DOOR LOCATIONS. 2.29 REFER TO SECURITY DRAWINGS FOR ELECTRONIC HARDWARE AND SECURITY COMPONENTS	1KICK PLATEKO050 10" X 2" LDV3SILENCER1229A1DOOR SWEEPC697A1THRESHOLDAS REQUIRED (PE
2.07 GC TO VERIFY FUNCTION OF ANY EXISTING PANIC HARDWARE TO BE IN OPERATIONAL CONDITION.	2.18 THE GENERAL CONTRACTOR SHALL EXAMINE THE DRAWINGS, SCHEDULE AND SPECIFICATIONS AND FURNISH PROPER HARDWARE FOR ALL OPENINGS WHETHER LISTED OR NOT. COMPLETE SHOP DRAWINGS TO BE PROVIDED TO ARCHITECT	SET 003 DOORS: 103 4 HINGES STS FBB199 4.5" X
 FOR GLASS DOORS BETWEEN 10'-0" TO 12'-0" HIGH USE 5/8" THICK TEMPERED GLASS. GENERAL CONTRACTOR TO VERIFY DOOR SWING. 	2.19 CORE DOORS AS REQUIRED TO RECEIVE ELECTRIC HARDWARE.	1PRIVACY SET45H-7T15M L/C VIB1CYLINDERPRIMUS (MATCH O1DOOR CLOSERQDC119 R SCNS1KICK PLATEKO050 10" X 2" LDW
	2.20 PAIR OF DOORS TO RECEIVED SPECIFIED HARDWARE ON EACH LEAF U.O.N.	3 SILENCER 1229A 1 DOOR SWEEP C697A 1 THRESHOLD AS REQUIRED (PEI SET 004
		SET 004DOORS: M106B3HINGES3EXIT DEVICE1EXIT DEVICE1RIM CYLINDER1DOOR CLOSER1DOOR CLOSER1KICK PLATE1PERIMETER SEAL1161SA @ HEAD & J1DOOR SWEEP2C697A1THRESHOLD2AS REQUIRED (PER
	WINDOW SCHEDULE	
TAGCOUNTOPERATIONSILLHEIGHTHEIGHTHEIGHT	WIDTHHEADSILLHEADJAMBGLASSWIDTHHEIGHTDETAILDETAILMANUFACTURERMODELTYPEFINISHREMARKS	
	5'-9" 10'-6" 7/A531 8/A531 6/A531 CASCADIA VG-3 5'-9" 11'-10" 7/A531 8/A531 6/A531 CASCADIA VG-3	
	5'-9" 10'-1 3/4" 7/A531 8/A531 6/A531 CASCADIA VG-3 7'-0" 7'-11 1/2" 2/A531 5/A531 1/A531 READY ACCESS 650 CUSTOM SIZE 3'-11 1/2" 7'-11 1/2" 2/A531 3/A531 1/A531 READY ACCESS 275LPSC CUSTOM SIZE	
A1 5 AWNING 8'-0" 2'-6" A2 5 AWNING 8'-1 3/4" 3'-8 1/4" A3 2 AWNING 8'-1 3/4" 2'-0" S1 1 SLIDING 2'-10" 5'-1 1/2" S2 1 SLIDING 2'-10" 5'-1 1/2"	5'-9" 10'-1 3/4" 7/A531 8/A531 6/A531 CASCADIA VG-3 VG-3 7'-0" 7'-11 1/2" 2/A531 5/A531 1/A531 READY ACCESS 650 CUSTOM SIZE 3'-11 1/2" 7'-11 1/2" 2/A531 3/A531 1/A531 READY ACCESS 275LPSC CUSTOM SIZE	

: Date: 5/13/2024

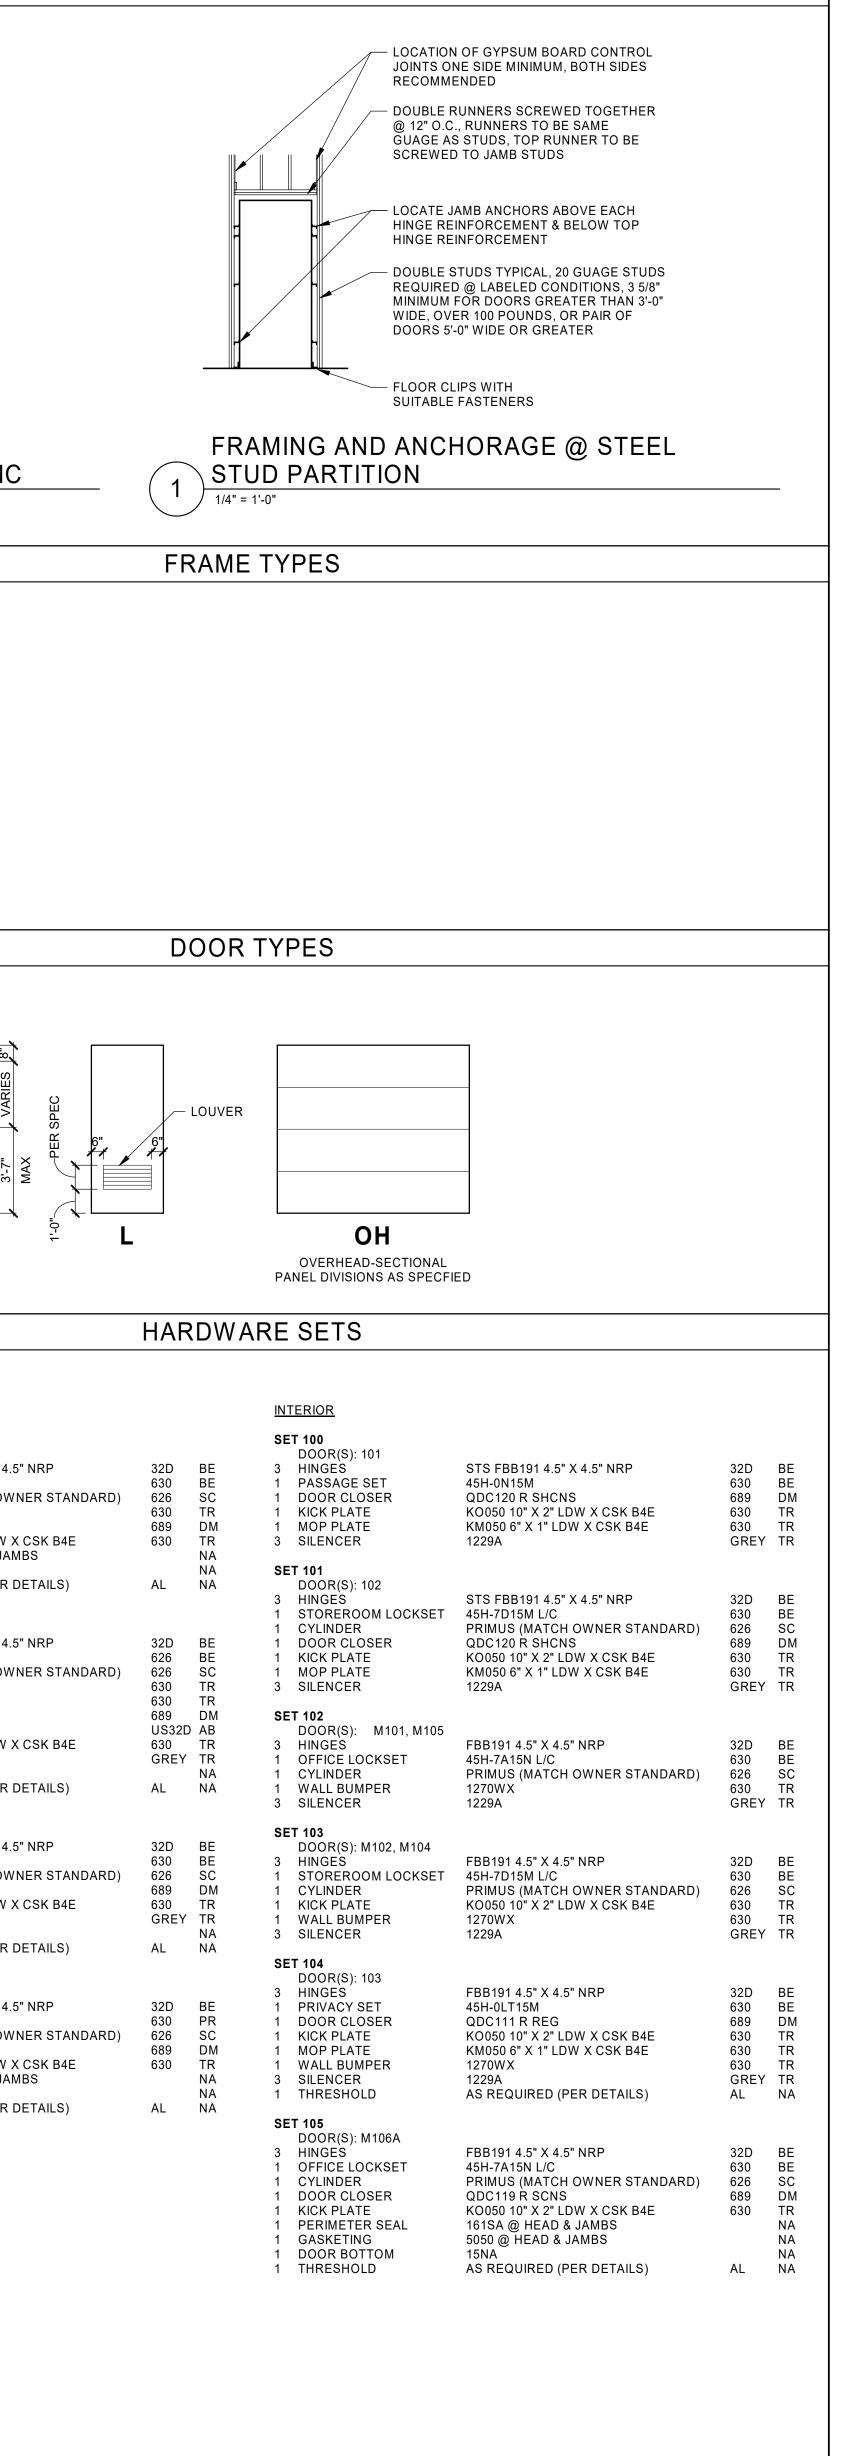

FRAME ASSEMBLY

KEYNOTES



														REFLECT	ED CEILING LIGI	HTING SCH	EDULE							
						INSTA	ALLATION			PERFORM	IANCE			FIXTURE FI	NISHES						CONTACT			
YPE ARK	MANUFACTURER	MOE		DESCRIPTION	N SIZE	METHOD			COLOR L TEMP O	LUMEN (OUTPUT /DIST			DUSING/ TRIM I	ENS COR	D/STEM SPECIALTY		INTEGRATED SENSOR	INTEGRAL AIR RETURN	OR EQUAL	NA	ME EMAIL	PHONE NUMBER	-	REMARKS
		IVIOL		DESCRIPTION											D/STEINI SPECIALIT		SENSOR		UK EQUAL	INA		NOWBEIN		REMARKS
F TO SH	IEET E701																							
S:	LAMP TEMPER	ATURE: [MATCH	EXISTING] [350	00K] IXTURE TRIMS WITH																				
	BALLASTS: GC	C/ ELECTRICAL SU	UB TO COORDI	INATE ALL BALLAST		IED DIMMING AN	D/OR LIGHTING	G CONTROL SYST	TEMS															
	<u>BALLASTS:</u> GC <u>MOUNTING:</u> G	C/ ELECTRICAL SU	UB TO COORDI DDITIONAL CEI	INATE ALL BALLAST ILING GRID TEES AI	TS WITH SPECIF	IED DIMMING AN																		
	<u>BALLASTS:</u> GC <u>MOUNTING:</u> G VOLTAGE: REF	C/ ELECTRICAL SU C TO PROVIDE AI FER TO ENGINEE	UB TO COORDI DDITIONAL CEI ERING DOCUME	INATE ALL BALLAST ILING GRID TEES AI ENTS	TS WITH SPECIF ND MAINS AS R	ED DIMMING AN	OCATION OF FIX	TURE AS SHOWN	N IN PLANS															
	<u>BALLASTS:</u> GC <u>MOUNTING:</u> G VOLTAGE: REF	C/ ELECTRICAL SU C TO PROVIDE AI FER TO ENGINEE	UB TO COORDI DDITIONAL CEI ERING DOCUME	INATE ALL BALLAST ILING GRID TEES AI ENTS	TS WITH SPECIF ND MAINS AS R	ED DIMMING AN	OCATION OF FIX	TURE AS SHOWN	N IN PLANS	RE] UON														
	<u>BALLASTS:</u> GC <u>MOUNTING:</u> G VOLTAGE: REF	C/ ELECTRICAL SU C TO PROVIDE AI FER TO ENGINEE	UB TO COORDI DDITIONAL CEI ERING DOCUME	INATE ALL BALLAST ILING GRID TEES AI	TS WITH SPECIF ND MAINS AS R	ED DIMMING AN	OCATION OF FIX	TURE AS SHOWN	N IN PLANS	RE] UON														
	<u>BALLASTS:</u> GC <u>MOUNTING:</u> G VOLTAGE: REF	C/ ELECTRICAL SU C TO PROVIDE AI FER TO ENGINEE	UB TO COORDI DDITIONAL CEI ERING DOCUME	INATE ALL BALLAST ILING GRID TEES AI ENTS	TS WITH SPECIF ND MAINS AS R	ED DIMMING AN	OCATION OF FIX	TURE AS SHOWN	N IN PLANS	RE] UON														
	<u>BALLASTS:</u> GC <u>MOUNTING:</u> G VOLTAGE: REF	C/ ELECTRICAL SU C TO PROVIDE AI FER TO ENGINEE	UB TO COORDI DDITIONAL CEI ERING DOCUME	INATE ALL BALLAST ILING GRID TEES AI ENTS	TS WITH SPECIF ND MAINS AS R	ED DIMMING AN	OCATION OF FIX	(TURE AS SHOWN O PLENUM REQU SURED TO [BOTTC	N IN PLANS UIREMENTS. OM OF FIXTURI												MATER	AL AND FINISH SCH	EDULE	
	<u>BALLASTS:</u> GC <u>MOUNTING:</u> G VOLTAGE: REF	C/ ELECTRICAL SU C TO PROVIDE AI FER TO ENGINEE <u>NUM:</u> ALL FIXTUR IXTURE INSTALL	UB TO COORDI DDITIONAL CEI ERING DOCUME	INATE ALL BALLAST ILING GRID TEES AI ENTS TALLED WITHIN TH : INSTALLATION HE	TS WITH SPECIF ND MAINS AS R	EQUIRED FOR LC	OCATION OF FIX	TURE AS SHOWN	N IN PLANS UIREMENTS. OM OF FIXTURI			WALLS					TAG	DESCRIPTION	MANU	FACTURER	MATER MODEL / SERIES	AL AND FINISH SCH		COMMENTS
BER	<u>BALLASTS:</u> GC <u>MOUNTING:</u> G VOLTAGE: REF	C/ ELECTRICAL SU C TO PROVIDE AI FER TO ENGINEE <u>NUM:</u> ALL FIXTUR IXTURE INSTALL	UB TO COORDI DDITIONAL CE RING DOCUME RES WHEN INS ATION HEIGHT:	INATE ALL BALLAST ILING GRID TEES AI ENTS TALLED WITHIN TH : INSTALLATION HE	TS WITH SPECIF ND MAINS AS R E CITY OF CHIC EIGHT FOR SUS	EQUIRED FOR LC	OCATION OF FIX Y WITH CHICAGO ES TO BE MEAS	TURE AS SHOWN O PLENUM REQU SURED TO [BOTTO ROOM FINISH	N IN PLANS UIREMENTS. OM OF FIXTURI I SCHEDULE		SOUTH		EAST			COMMENTS			MANU	FACTURER				
BER	BALLASTS: GC MOUNTING: G VOLTAGE: REF CHICAGO PLEN SUSPENDED F	C/ ELECTRICAL SU C TO PROVIDE AI FER TO ENGINEE <u>NUM:</u> ALL FIXTUR IXTURE INSTALL	UB TO COORDI DDITIONAL CE RING DOCUME RES WHEN INS ATION HEIGHT	INATE ALL BALLAST ILING GRID TEES AI ENTS TALLED WITHIN TH : INSTALLATION HE	TS WITH SPECIF ND MAINS AS R E CITY OF CHIC EIGHT FOR SUS	EQUIRED FOR LC	OCATION OF FIX Y WITH CHICAGO ES TO BE MEAS	(TURE AS SHOWN O PLENUM REQU SURED TO [BOTTO BOTTO BOOM FINISH	N IN PLANS UIREMENTS. OM OF FIXTURI		SOUTH				WEST FINISH	COMMENTS	CONC-2 CAST	DESCRIPTION	MANU	FACTURER				COMMENTS SURFACE DENSIFIER, SEALED FINISH
	BALLASTS: GC MOUNTING: G VOLTAGE: REF CHICAGO PLEN SUSPENDED F	C/ ELECTRICAL SU C TO PROVIDE AI FER TO ENGINEE <u>NUM:</u> ALL FIXTUR IXTURE INSTALL	UB TO COORDI DDITIONAL CE RING DOCUME RES WHEN INS ATION HEIGHT:	INATE ALL BALLAST ILING GRID TEES AI ENTS TALLED WITHIN TH : INSTALLATION HE	TS WITH SPECIF ND MAINS AS R E CITY OF CHIC EIGHT FOR SUS	EQUIRED FOR LC	OCATION OF FIX Y WITH CHICAGO ES TO BE MEAS	TURE AS SHOWN O PLENUM REQU SURED TO [BOTTO ROOM FINISH	N IN PLANS UIREMENTS. OM OF FIXTURI I SCHEDULE		SOUTH					COMMENTS	CONC-2 CAST- 03 CONCRETE	-IN-PLACE CONCRETE	MANU	FACTURER				SURFACE DENSIFIER, SEALED FINISH
NS	BALLASTS: GC MOUNTING: G VOLTAGE: REF CHICAGO PLEN SUSPENDED F	C/ ELECTRICAL SU C TO PROVIDE AI FER TO ENGINEE <u>NUM:</u> ALL FIXTUR IXTURE INSTALLA	UB TO COORDI DDITIONAL CE RING DOCUME RES WHEN INS ATION HEIGHT:	INATE ALL BALLAST ILING GRID TEES AI ENTS TALLED WITHIN THI : INSTALLATION HE FL	TS WITH SPECIF ND MAINS AS R E CITY OF CHIC EIGHT FOR SUS	EQUIRED FOR LC AGO TO COMPLY PENDED FIXTURE B/ MATERIAL	ASE	TURE AS SHOWN O PLENUM REQU SURED TO [BOTTO BOTTO BOTTO BOTT	N IN PLANS UIREMENTS. OM OF FIXTUR ISCHEDULE	MATERIAL	South L Finish	MATERIAL	FINISH	MATERIAL	FINISH	COMMENTS	CONC-2 CAST 03 CONCRETE CONC-1 CAST		MANU	FACTURER				
NS	BALLASTS: GC MOUNTING: GI VOLTAGE: REF CHICAGO PLEN SUSPENDED F ROOM NAME	C/ ELECTRICAL SU C TO PROVIDE AI FER TO ENGINEE <u>NUM:</u> ALL FIXTUR IXTURE INSTALLA	UB TO COORDI DDITIONAL CE RING DOCUME RES WHEN INS ATION HEIGHT:	INATE ALL BALLAST ILING GRID TEES AI ENTS TALLED WITHIN THI : INSTALLATION HE FL MATERIAL	TS WITH SPECIF ND MAINS AS R E CITY OF CHIC EIGHT FOR SUS OOR FINISH	EQUIRED FOR LC AGO TO COMPLY PENDED FIXTURE MATERIAL	OCATION OF FIX Y WITH CHICAGO ES TO BE MEAS ASE FINISH	TURE AS SHOWN O PLENUM REQU SURED TO [BOTTO BOTTO BOTTO BOTTO MATERIAL	N IN PLANS UIREMENTS. OM OF FIXTUR ISCHEDULE	MATERIAL SGT-1	SOUTH L FINISH	MATERIAL SGT-1	FINISH	SGT-1	GLAZED	COMMENTS	CONC-2 CAST 03 CONCRETE CONC-1 CAST 04 MASONRY	-IN-PLACE CONCRETE		FACTURER		PRODUCT / COD	E COLOR / FINISH	SURFACE DENSIFIER, SEALED FINISH
INS	BALLASTS: GC MOUNTING: GI VOLTAGE: REF CHICAGO PLEN SUSPENDED F ROOM NAME	C/ ELECTRICAL SU C TO PROVIDE AI FER TO ENGINEE <u>NUM:</u> ALL FIXTUR IXTURE INSTALL/ MATERIAL	UB TO COORDI DDITIONAL CE RING DOCUME RES WHEN INS ATION HEIGHT:	INATE ALL BALLAST ILING GRID TEES AI ENTS TALLED WITHIN TH : INSTALLATION HE FL MATERIAL	IS WITH SPECIF ND MAINS AS R E CITY OF CHIC EIGHT FOR SUS OOR FINISH	EQUIRED FOR LC AGO TO COMPLY PENDED FIXTURE MATERIAL PER SCHEDULE PER SCHEDULE	ASE PER SCHEDULE PER SCHEDULE	TURE AS SHOWN O PLENUM REQU SURED TO [BOTTO BOTTO BOTTO BOTTO MATERIAL	N IN PLANS UIREMENTS. OM OF FIXTURI I SCHEDULE IORTH GLAZED GLAZED	MATERIAL SGT-1 SGT-1	SOUTH L FINISH GLAZED GLAZED	SGT-1 SGT-1	GLAZED GLAZED	SGT-1 SGT-1	GLAZED GLAZED	COMMENTS	CONC-2 CAST 03 CONCRETE CONC-1 CAST 04 MASONRY CLAD-1 BRICK	-IN-PLACE CONCRETE -IN-PLACE CONCRETE K VENEER	GLEN-GERY	FACTURER			COLOR / FINISH	SURFACE DENSIFIER, SEALED FINISH
DNS (E	BALLASTS: GC MOUNTING: G VOLTAGE: REF CHICAGO PLEN SUSPENDED F SUSPENDED F ROOM NAME	C/ ELECTRICAL SU C TO PROVIDE AI FER TO ENGINEE <u>NUM:</u> ALL FIXTUR IXTURE INSTALLA MATERIAL PER RCP PER RCP PER RCP PER RCP	UB TO COORDI DDITIONAL CE RING DOCUME RES WHEN INS ATION HEIGHT:	INATE ALL BALLAST ILING GRID TEES AI ENTS TALLED WITHIN TH : INSTALLATION HE MATERIAL CONC CONC CONC	IS WITH SPECIF ND MAINS AS R E CITY OF CHIC EIGHT FOR SUS OOR FINISH CONC-1 CONC-2 CONC-2	EQUIRED FOR LC AGO TO COMPLY PENDED FIXTURE MATERIAL PER SCHEDULE PER SCHEDULE PER SCHEDULE	ASE PER SCHEDULE PER SCHEDULE PER SCHEDULE	TURE AS SHOWN O PLENUM REQU BURED TO [BOTTO BOTTO BOTTO BOTTO MATERIAL SGT-1 SGT-1 SGT-1 SGT-1	N IN PLANS UIREMENTS. OM OF FIXTURI I SCHEDULE IORTH GLAZED GLAZED EXPOSED	MATERIAL SGT-1 SGT-1 SGT-1 SGT-1	SOUTH L FINISH GLAZED GLAZED GLAZED	SGT-1 SGT-1 SGT-1 SGT-1	GLAZED GLAZED GLAZED GLAZED	SGT-1	FINISH GLAZED GLAZED GLAZED	COMMENTS	CONC-2 CAST 03 CONCRETE CONC-1 CAST 04 MASONRY CLAD-1 BRICK CLAD-2 GLAZ	-IN-PLACE CONCRETE -IN-PLACE CONCRETE K VENEER ED TILE RAINSCREEN	GLEN-GERY ELGIN BUTLER	FACTURER		PRODUCT / COD	COLOR / FINISH	SURFACE DENSIFIER, SEALED FINISH EPOXY FINISH -
DNS C E F	BALLASTS: GC MOUNTING: G VOLTAGE: REF CHICAGO PLEN SUSPENDED F SUSPENDED F SUSPENDED F	C/ ELECTRICAL SU C TO PROVIDE AI FER TO ENGINEE <u>NUM:</u> ALL FIXTUR IXTURE INSTALLA MATERIAL PER RCP PER RCP PER RCP PER RCP PER RCP	UB TO COORDI DDITIONAL CE RING DOCUME RES WHEN INS ATION HEIGHT:	INATE ALL BALLAST ILING GRID TEES AI ENTS TALLED WITHIN TH : INSTALLATION HE MATERIAL CONC CONC CONC CONC	IS WITH SPECIF ND MAINS AS R E CITY OF CHIC EIGHT FOR SUS OOR FINISH CONC-1 CONC-2 CONC-2 CONC-1	EQUIRED FOR LC AGO TO COMPLY PENDED FIXTURE MATERIAL PER SCHEDULE PER SCHEDULE PER SCHEDULE PER SCHEDULE	ASE PER SCHEDULE PER SCHEDULE PER SCHEDULE PER SCHEDULE PER SCHEDULE	TURE AS SHOWN O PLENUM REQU SURED TO [BOTTO BOTTO BOTTO BOTTO MATERIAL SGT-1 SGT-1 SGT-1 SGT-1 SGT-1	N IN PLANS UIREMENTS. OM OF FIXTURI I SCHEDULE IORTH GLAZED GLAZED EXPOSED	MATERIAL SGT-1 SGT-1 SGT-1 SGT-1 SGT-1 SGT-1	SOUTH FINISH GLAZED GLAZED GLAZED GLAZED	SGT-1 SGT-1 SGT-1 SGT-1 SGT-1 SGT-1	GLAZED GLAZED GLAZED GLAZED GLAZED	SGT-1 SGT-1	FINISH GLAZED GLAZED GLAZED GLAZED GLAZED	COMMENTS	CONC-2 CAST 03 CONCRETE CONC-1 CAST 04 MASONRY CLAD-1 BRICK CLAD-2 GLAZ	-IN-PLACE CONCRETE -IN-PLACE CONCRETE K VENEER	GLEN-GERY	FACTURER		BW SERIES 8W SERIES 8W SERIES	COLOR / FINISH NAPA VALLEY SMOOTH IRONSPOT SPICY WHITE SPICY WHITE	SURFACE DENSIFIER, SEALED FINISH EPOXY FINISH - PROVIDE COVE BASES, BULLNOSE CORNER SHAPE
DNS E F	BALLASTS: GC MOUNTING: GI VOLTAGE: REF CHICAGO PLEN SUSPENDED F SUSPENDED F	C/ ELECTRICAL SU C TO PROVIDE AI FER TO ENGINEE <u>NUM:</u> ALL FIXTUR IXTURE INSTALLA MATERIAL PER RCP PER RCP PER RCP PER RCP PER RCP PER RCP PER RCP	UB TO COORDI DDITIONAL CE RING DOCUME RES WHEN INS ATION HEIGHT:	INATE ALL BALLAST ILING GRID TEES AI ENTS TALLED WITHIN THI : INSTALLATION HE MATERIAL CONC CONC CONC CONC CONC	IS WITH SPECIF ND MAINS AS R E CITY OF CHIC EIGHT FOR SUS OOR FINISH CONC-1 CONC-2 CONC-2 CONC-1 CONC-1	IED DIMMING AN EQUIRED FOR LC AGO TO COMPLY PENDED FIXTURE MATERIAL PER SCHEDULE PER SCHEDULE PER SCHEDULE PER SCHEDULE PER SCHEDULE PER SCHEDULE	ASE PER SCHEDULE PER SCHEDULE PER SCHEDULE PER SCHEDULE PER SCHEDULE PER SCHEDULE	TURE AS SHOWN O PLENUM REQU SURED TO [BOTTO BOTTO BOTTO BOTTO SURED TO [BOTTO BOTTO BOTTO MATERIAL	N IN PLANS UIREMENTS. OM OF FIXTURI I SCHEDULE IORTH GLAZED GLAZED EXPOSED	MATERIAL SGT-1 SGT-1 SGT-1 SGT-1 SGT-1 SGT-1 SGT-1 SGT-1	SOUTH L FINISH GLAZED GLAZED GLAZED GLAZED GLAZED	SGT-1 SGT-1 SGT-1 SGT-1 SGT-1 SGT-1 SGT-1	GLAZED GLAZED GLAZED GLAZED GLAZED	SGT-1 SGT-1	FINISH GLAZED GLAZED GLAZED GLAZED GLAZED	COMMENTS	CONC-2 CAST 03 CONCRETE CONC-1 CAST 04 MASONRY CLAD-1 BRICK CLAD-2 GLAZ SGT-1 STRU	-IN-PLACE CONCRETE -IN-PLACE CONCRETE K VENEER ED TILE RAINSCREEN	GLEN-GERY ELGIN BUTLER	FACTURER		PRODUCT / COD	COLOR / FINISH NAPA VALLEY SMOOTH IRONSPOT SPICY WHITE SPICY WHITE	SURFACE DENSIFIER, SEALED FINISH EPOXY FINISH -
ONS C E F V	BALLASTS: GC MOUNTING: G VOLTAGE: REF CHICAGO PLEN SUSPENDED F SUSPENDED F SUSPENDED F	C/ ELECTRICAL SU C TO PROVIDE AI FER TO ENGINEE <u>NUM:</u> ALL FIXTUR IXTURE INSTALLA MATERIAL PER RCP PER RCP PER RCP PER RCP PER RCP	UB TO COORDI DDITIONAL CE RING DOCUME RES WHEN INS ATION HEIGHT:	INATE ALL BALLAST ILING GRID TEES AI ENTS TALLED WITHIN TH : INSTALLATION HE MATERIAL CONC CONC CONC CONC	IS WITH SPECIF ND MAINS AS R E CITY OF CHIC EIGHT FOR SUS OOR FINISH CONC-1 CONC-2 CONC-2 CONC-1	IED DIMMING AN EQUIRED FOR LC AGO TO COMPLY PENDED FIXTURE MATERIAL PER SCHEDULE PER SCHEDULE PER SCHEDULE PER SCHEDULE PER SCHEDULE PER SCHEDULE	ASE PER SCHEDULE PER SCHEDULE PER SCHEDULE PER SCHEDULE PER SCHEDULE	TURE AS SHOWN O PLENUM REQU SURED TO [BOTTO BOTTO BOTTO BOTTO SURED TO [BOTTO BOTTO BOTTO MATERIAL	N IN PLANS UIREMENTS. OM OF FIXTURI I SCHEDULE IORTH GLAZED GLAZED	MATERIAL SGT-1 SGT-1 SGT-1 SGT-1 SGT-1 SGT-1	SOUTH FINISH GLAZED GLAZED GLAZED GLAZED	SGT-1 SGT-1 SGT-1 SGT-1 SGT-1 SGT-1	GLAZED GLAZED GLAZED GLAZED	MATERIAL SGT-1 SGT-1 SGT-1 SGT-1 SGT-1 SGT-1	FINISH GLAZED GLAZED GLAZED	COMMENTS	CONC-2 CAST 03 CONCRETE CONC-1 CAST 04 MASONRY CLAD-1 BRICK CLAD-2 GLAZI SGT-1 STRU 05 METALS	-IN-PLACE CONCRETE -IN-PLACE CONCRETE K VENEER ED TILE RAINSCREEN	GLEN-GERY ELGIN BUTLER ELGIN BUTLER ELGIN BUTLER	FACTURER		BW SERIES 8W SERIES 8W SERIES	COLOR / FINISH NAPA VALLEY SMOOTH IRONSPOT SPICY WHITE SPICY WHITE	SURFACE DENSIFIER, SEALED FINISH EPOXY FINISH - PROVIDE COVE BASES, BULLNOSE CORNER SHAPE LOCATIONS
E N F	BALLASTS: GC MOUNTING: GI VOLTAGE: REF CHICAGO PLEN SUSPENDED F SUSPENDED F	C/ ELECTRICAL SU C TO PROVIDE AI FER TO ENGINEE <u>NUM:</u> ALL FIXTUR IXTURE INSTALLA MATERIAL PER RCP PER RCP PER RCP PER RCP PER RCP PER RCP PER RCP	UB TO COORDI DDITIONAL CE RING DOCUME RES WHEN INS ATION HEIGHT:	INATE ALL BALLAST ILING GRID TEES AI ENTS TALLED WITHIN THI : INSTALLATION HE MATERIAL CONC CONC CONC CONC CONC	IS WITH SPECIF ND MAINS AS R E CITY OF CHIC EIGHT FOR SUS OOR FINISH CONC-1 CONC-2 CONC-2 CONC-1 CONC-1	IED DIMMING AN EQUIRED FOR LC AGO TO COMPLY PENDED FIXTURE MATERIAL PER SCHEDULE PER SCHEDULE PER SCHEDULE PER SCHEDULE PER SCHEDULE PER SCHEDULE	ASE PER SCHEDULE PER SCHEDULE PER SCHEDULE PER SCHEDULE PER SCHEDULE PER SCHEDULE	CTURE AS SHOWN O PLENUM REQU SURED TO [BOTTO BOTTO BOTTO BOTTO BOTTO MATERIAL SGT-1 SGT-1 SGT-1 SGT-1 SGT-1 SGT-1 SGT-1	N IN PLANS UIREMENTS. OM OF FIXTURI I SCHEDULE IORTH GLAZED GLAZED EXPOSED	MATERIAL SGT-1 SGT-1 SGT-1 SGT-1 SGT-1 SGT-1 SGT-1 SGT-1	SOUTH L FINISH GLAZED GLAZED GLAZED GLAZED GLAZED GLAZED	SGT-1 SGT-1 SGT-1 SGT-1 SGT-1 SGT-1 SGT-1	GLAZED GLAZED GLAZED GLAZED GLAZED	MATERIAL SGT-1 SGT-1 SGT-1 SGT-1 SGT-1 SGT-1	FINISH GLAZED GLAZED GLAZED GLAZED GLAZED	COMMENTS	CONC-2 CAST 03 CONCRETE CONC-1 CAST 04 MASONRY CLAD-1 BRICK CLAD-2 GLAZI SGT-1 STRU 05 METALS EMT-1 BRAK	-IN-PLACE CONCRETE -IN-PLACE CONCRETE K VENEER ED TILE RAINSCREEN ICTRAL GLAZED TILE	GLEN-GERY ELGIN BUTLER	FACTURER		BW SERIES 8W SERIES 8W SERIES	COLOR / FINISH	SURFACE DENSIFIER, SEALED FINISH EPOXY FINISH - PROVIDE COVE BASES, BULLNOSE CORNER SHAPE
ONS E F N NCE	BALLASTS: GC MOUNTING: GI VOLTAGE: REF CHICAGO PLEN SUSPENDED F SUSPENDED F	C/ ELECTRICAL SU C TO PROVIDE AI FER TO ENGINEE <u>NUM:</u> ALL FIXTUR IXTURE INSTALLA MATERIAL PER RCP PER RCP PER RCP PER RCP PER RCP PER RCP PER RCP PER RCP PER RCP	UB TO COORDI DDITIONAL CE RING DOCUME RES WHEN INS ATION HEIGHT:	INATE ALL BALLAST ILING GRID TEES AI ENTS TALLED WITHIN THI : INSTALLATION HE MATERIAL CONC CONC CONC CONC CONC CONC CONC CON	IS WITH SPECIF ND MAINS AS R E CITY OF CHIC EIGHT FOR SUS OOR FINISH CONC-1 CONC-2 CONC-2 CONC-1 CONC-1	EQUIRED FOR LC AGO TO COMPLY PENDED FIXTURE MATERIAL PER SCHEDULE PER SCHEDULE PER SCHEDULE PER SCHEDULE PER SCHEDULE PER SCHEDULE PER SCHEDULE PER SCHEDULE	ASE PER SCHEDULE	ROOM FINISH SURED TO [BOTTO BORED TO [BOTTO ROOM FINISH SGT-1 SGT-1 SGT-1 SGT-1 SGT-1 SGT-1 SGT-1 SGT-1 SGT-1 SGT-1	N IN PLANS UIREMENTS. OM OF FIXTUR ISCHEDULE IORTH GLAZED GLAZED GLAZED GLAZED GLAZED GLAZED GLAZED	MATERIAL SGT-1 SGT-1 SGT-1 SGT-1 SGT-1 SGT-1 SGT-1 SGT-1 SGT-1	SOUTH L FINISH GLAZED GLAZED GLAZED GLAZED GLAZED GLAZED	SGT-1 SGT-1 SGT-1 SGT-1 SGT-1 SGT-1 SGT-1	GLAZED GLAZED GLAZED GLAZED GLAZED	MATERIAL SGT-1 SGT-1 SGT-1 SGT-1 SGT-1 SGT-1 SGT-1 GYP-1	FINISH GLAZED GLAZED GLAZED GLAZED GLAZED	COMMENTS	CONC-2 CAST 03 CONCRETE CONC-1 CAST 04 MASONRY CLAD-1 BRICK CLAD-2 GLAZI SGT-1 STRU 05 METALS EMT-1 BRAK EMT-5 ROOF MT-1 STAIN	-IN-PLACE CONCRETE -IN-PLACE CONCRETE K VENEER ED TILE RAINSCREEN ICTRAL GLAZED TILE KE METAL, FLASHING, AND TRIM F ACCESSS HATCH NLESS STEEL	GLEN-GERY ELGIN BUTLER ELGIN BUTLER LINETEC NYSTROM -	FACTURER		BW SERIES 8W SERIES 8W SERIES	COLOR / FINISH	SURFACE DENSIFIER, SEALED FINISH EPOXY FINISH - PROVIDE COVE BASES, BULLNOSE CORNER SHAPE LOCATIONS
ONS C E N F NCE	BALLASTS: GC MOUNTING: GI VOLTAGE: REH CHICAGO PLEN SUSPENDED F SUSPENDED F SUSPENDED F SUSPENDED F SUSPENDED F	C/ ELECTRICAL SU C TO PROVIDE AI FER TO ENGINEE <u>NUM:</u> ALL FIXTUR IXTURE INSTALL/ MATERIAL PER RCP PER RCP	UB TO COORDI DDITIONAL CE RING DOCUME RES WHEN INS ATION HEIGHT:	INATE ALL BALLAST ILING GRID TEES AI ENTS TALLED WITHIN THI : INSTALLATION HE MATERIAL CONC CONC CONC CONC CONC CONC CONC CON	IS WITH SPECIF ND MAINS AS R E CITY OF CHIC EIGHT FOR SUS OOR FINISH CONC-1 CONC-2 CONC-2 CONC-1 CONC-1 CONC-1 CONC-1	EQUIRED FOR LC AGO TO COMPLY PENDED FIXTURE MATERIAL PER SCHEDULE PER SCHEDULE PER SCHEDULE PER SCHEDULE PER SCHEDULE PER SCHEDULE PER SCHEDULE PER SCHEDULE PER SCHEDULE BER SCHEDULE	ASE PER SCHEDULE PER SCHEDULE PER SCHEDULE PER SCHEDULE PER SCHEDULE PER SCHEDULE	ROOM FINISH SGT-1 SGT-1 SGT	N IN PLANS UIREMENTS. OM OF FIXTURI I SCHEDULE IORTH GLAZED GLAZED GLAZED GLAZED GLAZED GLAZED GLAZED GLAZED	MATERIAL SGT-1	SOUTH L FINISH GLAZED GLAZED GLAZED GLAZED GLAZED GLAZED	MATERIAL SGT-1 SGT-1 SGT-1 SGT-1 SGT-1 SGT-1 SGT-1	GLAZED GLAZED GLAZED GLAZED GLAZED	MATERIAL SGT-1 SGT-1 SGT-1 SGT-1 SGT-1 SGT-1 SGT-1 SGT-1 SGT-1	FINISH GLAZED GLAZED GLAZED GLAZED GLAZED	COMMENTS	CONC-2 CAST 03 CONCRETE CONC-1 CAST 04 MASONRY CLAD-1 BRICK CLAD-2 GLAZI SGT-1 STRU 05 METALS EMT-1 BRAK EMT-5 ROOF MT-1 STAIN STL-1 STRU	-IN-PLACE CONCRETE -IN-PLACE CONCRETE K VENEER ED TILE RAINSCREEN ICTRAL GLAZED TILE KE METAL, FLASHING, AND TRIM F ACCESSS HATCH VLESS STEEL ICTURAL STEEL, SEE STRUCTURAL	GLEN-GERY ELGIN BUTLER ELGIN BUTLER LINETEC NYSTROM -	FACTURER		BW SERIES 8W SERIES 8W SERIES	COLOR / FINISH	SURFACE DENSIFIER, SEALED FINISH EPOXY FINISH - PROVIDE COVE BASES, BULLNOSE CORNER SHAPE LOCATIONS REFER TO DRAWINGS FOR PROFILE AND DIMENSIO
DNS C E F V C E C C C C C C C C C C C C C C C C C	BALLASTS: GC MOUNTING: GI VOLTAGE: REH CHICAGO PLEN SUSPENDED F SUSPENDED F ROOM NAME ROOM NAME	C/ ELECTRICAL SU C TO PROVIDE AI FER TO ENGINEE <u>NUM:</u> ALL FIXTUR IXTURE INSTALL/ MATERIAL PER RCP PER RCP	UB TO COORDI DDITIONAL CE RING DOCUME RES WHEN INS ATION HEIGHT:	INATE ALL BALLAST ILING GRID TEES AI ENTS TALLED WITHIN THI : INSTALLATION HE MATERIAL CONC CONC CONC CONC CONC CONC CONC CON	IS WITH SPECIF ND MAINS AS R E CITY OF CHIC EIGHT FOR SUS OOR FINISH CONC-1 CONC-1 CONC-1 CONC-1 CONC-1 CONC-1 CONC-1 CONC-2 CONC-2 CONC-2 CONC-2 CONC-2 CONC-2	IED DIMMING AN EQUIRED FOR LC AGO TO COMPLY PENDED FIXTURE MATERIAL PER SCHEDULE PER SCHEDULE PER SCHEDULE PER SCHEDULE PER SCHEDULE PER SCHEDULE PER SCHEDULE PER SCHEDULE BEN SCHEDULE	ASE PER SCHEDULE PER SCHEDULE PER SCHEDULE PER SCHEDULE PER SCHEDULE PER SCHEDULE PER SCHEDULE PER SCHEDULE PER SCHEDULE PER SCHEDULE	CURE AS SHOWN O PLENUM REQU SURED TO [BOTTO BOTTO BOTTO SGT-1 SGT-1 SGT-	N IN PLANS UIREMENTS. OM OF FIXTUR ISCHEDULE IORTH GLAZED GLAZED GLAZED GLAZED GLAZED GLAZED GLAZED	SGT-1 SGT-1 SGT-1 SGT-1 SGT-1 SGT-1 SGT-1 SGT-1 SGT-1 SGT-1 SGT-1 SGT-1 SGT-1 SGT-1 SGT-1 SGT-1	SOUTH L FINISH GLAZED GLAZED GLAZED GLAZED GLAZED GLAZED	MATERIAL SGT-1 SGT-1 SGT-1 SGT-1 SGT-1 SGT-1 SGT-1 GYP-1 GYP-1 GYP-1	GLAZED GLAZED GLAZED GLAZED GLAZED	MATERIAL SGT-1 SGT-1 SGT-1 SGT-1 SGT-1 SGT-1 SGT-1 GYP-1 GYP-1 EXPOSED	FINISH GLAZED GLAZED GLAZED GLAZED GLAZED GLAZED GLAZED P-1	COMMENTS	CONC-2 CAST 03 CONCRETE CONC-1 CAST 04 MASONRY CLAD-1 BRICK CLAD-2 GLAZI SGT-1 STRU 05 METALS EMT-1 BRAK EMT-5 ROOF MT-1 STAIN STL-1 STRU 06 WOODS, PLAST	-IN-PLACE CONCRETE -IN-PLACE CONCRETE K VENEER ED TILE RAINSCREEN ICTRAL GLAZED TILE E METAL, FLASHING, AND TRIM F ACCESSS HATCH NLESS STEEL ICTURAL STEEL, SEE STRUCTURAL TICS, COMPOSITES	GLEN-GERY ELGIN BUTLER ELGIN BUTLER LINETEC NYSTROM -		MODEL / SERIES	BW SERIES 8W SERIES 8W SERIES	COLOR / FINISH	SURFACE DENSIFIER, SEALED FINISH EPOXY FINISH - PROVIDE COVE BASES, BULLNOSE CORNER SHAPE LOCATIONS REFER TO DRAWINGS FOR PROFILE AND DIMENSIO
ONS	BALLASTS: GC MOUNTING: GI VOLTAGE: REH CHICAGO PLEN SUSPENDED F SUSPENDED F SUSPENDE SUSPENDE SU	C/ ELECTRICAL SU C TO PROVIDE AI FER TO ENGINEE <u>NUM:</u> ALL FIXTUR IXTURE INSTALL/ MATERIAL PER RCP PER RCP	UB TO COORDI DDITIONAL CE RING DOCUME RES WHEN INS ATION HEIGHT:	INATE ALL BALLAST ILING GRID TEES AI ENTS TALLED WITHIN THI : INSTALLATION HE MATERIAL CONC CONC CONC CONC CONC CONC CONC CON	IS WITH SPECIF ND MAINS AS R E CITY OF CHIC EIGHT FOR SUS OOR FINISH CONC-1 CONC-1 CONC-1 CONC-1 CONC-1 CONC-1 CONC-1 CONC-2 CONC-2 CONC-2	 IED DIMMING AN EQUIRED FOR LC AGO TO COMPLY PENDED FIXTURI MATERIAL PER SCHEDULE B-1 B-1 B-1 	ASE PER SCHEDULE PER SCHEDULE	ROOM FINISH SGT-1 SGT-1 SGT	N IN PLANS UIREMENTS. OM OF FIXTUR ISCHEDULE IORTH GLAZED GLAZED GLAZED GLAZED GLAZED GLAZED GLAZED	MATERIAL SGT-1 SGT-1 SGT-1 SGT-1 SGT-1 SGT-1 SGT-1 SGT-1 SGT-1 SGT-1 SGT-1 SGT-1 SGT-1 SGT-1 SGT-1 SGT-1 SGT-1	SOUTH FINISH GLAZED GLAZED GLAZED GLAZED GLAZED GLAZED P-1 P-1	MATERIAL SGT-1 SGT-1 SGT-1 SGT-1 SGT-1 SGT-1 SGT-1 GYP-1 GYP-1	GLAZED GLAZED GLAZED GLAZED GLAZED	MATERIAL SGT-1 SGT-1 SGT-1 SGT-1 SGT-1 SGT-1 SGT-1 SGT-1 GYP-1 EXPOSED GYP-1 GYP-1	FINISH GLAZED GLAZED GLAZED GLAZED GLAZED GLAZED GLAZED P-1 P-1	COMMENTS	CONC-2CAST03 CONCRETECONC-1CAST04 MASONRYCLAD-1BRICHCLAD-2GLAZHSGT-1STRU05 METALSEMT-1BRAKHEMT-5ROOFMT-1STAINSTL-1STRU06 WOODS, PLASTCLAD-3FIBER	-IN-PLACE CONCRETE -IN-PLACE CONCRETE K VENEER ED TILE RAINSCREEN ICTRAL GLAZED TILE KE METAL, FLASHING, AND TRIM F ACCESSS HATCH NLESS STEEL ICTURAL STEEL, SEE STRUCTURAL ICS, COMPOSITES RCEMENT RAINSCREEN CLADDING	GLEN-GERY ELGIN BUTLER ELGIN BUTLER LINETEC NYSTROM - - EQUITONE		MODEL / SERIES	BW SERIES 8W SERIES 8W SERIES	COLOR / FINISH	SURFACE DENSIFIER, SEALED FINISH EPOXY FINISH - PROVIDE COVE BASES, BULLNOSE CORNER SHAPE LOCATIONS REFER TO DRAWINGS FOR PROFILE AND DIMENSIO
DNS E F VCE C C F C C F C C F C C	BALLASTS: GC MOUNTING: GI VOLTAGE: REH CHICAGO PLEN SUSPENDED F SUSPENDED F SUSPENDE SUSPENDE SU	C/ ELECTRICAL SU C TO PROVIDE AI FER TO ENGINEE <u>NUM:</u> ALL FIXTUR IXTURE INSTALL/ MATERIAL PER RCP PER RCP	UB TO COORDI DDITIONAL CE RING DOCUME RES WHEN INS ATION HEIGHT:	INATE ALL BALLAST ILING GRID TEES AI ENTS TALLED WITHIN THI : INSTALLATION HE MATERIAL CONC CONC CONC CONC CONC CONC CONC CON	IS WITH SPECIF ND MAINS AS R E CITY OF CHIC EIGHT FOR SUS OOR FINISH CONC-1 CONC-1 CONC-1 CONC-1 CONC-1 CONC-1 CONC-1 CONC-1 CONC-2 CONC-2 CONC-2 CONC-2 CONC-2 CONC-2 CONC-2 CONC-2 CONC-2	 IED DIMMING AN EQUIRED FOR LC AGO TO COMPLY PENDED FIXTURI MATERIAL PER SCHEDULE B-1 B-1 B-1 	ASE PER SCHEDULE PER SCHEDULE	CURE AS SHOWN O PLENUM REQU SURED TO [BOTTO BOTTO BOTTO BOTTO BOTTO SGT-1 SGT-1 SGT-	N IN PLANS UIREMENTS. OM OF FIXTUR ISCHEDULE IORTH GLAZED GLAZED GLAZED GLAZED GLAZED GLAZED GLAZED	MATERIAL SGT-1 SGT-1 SGT	SOUTH FINISH GLAZED GLAZED GLAZED GLAZED GLAZED GLAZED P-1 P-1	MATERIAL SGT-1 SGT-1 SGT-1 SGT-1 SGT-1 SGT-1 SGT-1 GYP-1 GYP-1 GYP-1	GLAZED GLAZED GLAZED GLAZED GLAZED	MATERIAL SGT-1 SGT-1 SGT-1 SGT-1 SGT-1 SGT-1 SGT-1 SGT-1 GYP-1 GYP-1 EXPOSED GYP-1 GYP-1 GYP-1 GYP-1	FINISH GLAZED GLAZED GLAZED GLAZED GLAZED GLAZED GLAZED P-1 P-1		CONC-2 CAST 03 CONCRETE CONC-1 CAST 04 MASONRY CLAD-1 BRICK CLAD-2 GLAZI SGT-1 STRU 05 METALS EMT-1 BRAK EMT-5 ROOF MT-1 STAIN STL-1 STRU 06 WOODS, PLAST CLAD-3 FIBER CLAD-4 FIBER	-IN-PLACE CONCRETE -IN-PLACE CONCRETE K VENEER ED TILE RAINSCREEN ICTRAL GLAZED TILE KE METAL, FLASHING, AND TRIM F ACCESSS HATCH VLESS STEEL ICTURAL STEEL, SEE STRUCTURAL TICS, COMPOSITES RCEMENT RAINSCREEN CLADDING RCEMENT RAINSCREEN CLADDING	GLEN-GERY ELGIN BUTLER ELGIN BUTLER ELGIN BUTLER LINETEC NYSTROM - EQUITONE EQUITONE EQUITONE		MODEL / SERIES	BW SERIES 8W SERIES 8W SERIES	E COLOR / FINISH COLOR / FINISH NAPA VALLEY SMOOTH IRONSPOT SPICY WHITE SPICY WHITE BLACK ANO-305 AE N074 N359	SURFACE DENSIFIER, SEALED FINISH EPOXY FINISH - PROVIDE COVE BASES, BULLNOSE CORNER SHAPE LOCATIONS REFER TO DRAWINGS FOR PROFILE AND DIMENSIO
DNS	BALLASTS: GC MOUNTING: GI VOLTAGE: REH CHICAGO PLEN SUSPENDED F SUSPENDED F SUSPENDED F CHICAGO PLEN SUSPENDED F SUSPENDED F SUSPENDE F SUSPENDE F SUSPENDE SUSPENDE SUSPENDE F SUSPENDE F SUSPENDE F	C/ ELECTRICAL SU C TO PROVIDE AI FER TO ENGINEE <u>NUM:</u> ALL FIXTUR IXTURE INSTALL/ MATERIAL PER RCP PER RCP	UB TO COORDI DDITIONAL CE RING DOCUME RES WHEN INS ATION HEIGHT P-1 P-1 P-1 P-1 P-1 P-1 P-1 P-1 P-1 P-1	INATE ALL BALLAST ILING GRID TEES AI ENTS TALLED WITHIN TH : INSTALLATION HE MATERIAL CONC CONC CONC CONC CONC CONC CONC CON	IS WITH SPECIF ND MAINS AS R E CITY OF CHIC EIGHT FOR SUS OOR FINISH CONC-1 CONC-2 CONC-1 CONC-1 CONC-1 CONC-1 CONC-1 CONC-2 CONC-2 CONC-2 CONC-2 CONC-2 CONC-2 CONC-2 CONC-2 CONC-2 CONC-2 CONC-2 CONC-2 CONC-2 CONC-2 CONC-2 CONC-2	EQUIRED FOR LC AGO TO COMPLY PENDED FIXTURE MATERIAL PER SCHEDULE PER SCHEDULE PER SCHEDULE PER SCHEDULE PER SCHEDULE PER SCHEDULE PER SCHEDULE PER SCHEDULE PER SCHEDULE B-1 B-1 B-1 B-1 B-1 B-1 B-1 B-1 B-1 B-1	ASE PER SCHEDULE PER SCHEDULE	CTURE AS SHOWN O PLENUM REQU SURED TO [BOTTO BOTTO BOTTO BOTTO BOTTO SGT-1 SGT-1 SGT	N IN PLANS UIREMENTS. OM OF FIXTURI ISCHEDULE IORTH GLAZED GLAZED GLAZED GLAZED GLAZED FINISH P-1 P-1 P-1 P-1 P-1 P-1 P-1 P-	SGT-1 SGT-1 SOUTH FINISH GLAZED GLAZED GLAZED GLAZED GLAZED GLAZED P-1 P-1 EXPOSED P-1 EXPOSED P-1	MATERIAL SGT-1 SGT-	GLAZED GLAZED GLAZED GLAZED GLAZED GLAZED GLAZED P-1 P-1 P-1 P-1 P-1 P-1 P-1 P-1 P-1 P-1	MATERIAL SGT-1 EXPOSED GYP-1 GYP-1 GYP-1 GYP-1 GYP-1 GYP-1	FINISH GLAZED GLAZED GLAZED GLAZED GLAZED GLAZED GLAZED GLAZED P-1 P-1		CONC-2CAST03 CONCRETECONC-1CAST04 MASONRYCLAD-1BRICKCLAD-2GLAZISGT-1STRU05 METALSEMT-1BRAKEMT-5ROOFMT-1STAINSTL-1STRU06 WOODS, PLASTCLAD-3FIBERCLAD-5FIBER	-IN-PLACE CONCRETE -IN-PLACE CONCRETE K VENEER ED TILE RAINSCREEN ICTRAL GLAZED TILE E METAL, FLASHING, AND TRIM F ACCESSS HATCH NLESS STEEL ICTURAL STEEL, SEE STRUCTURAL TICS, COMPOSITES RCEMENT RAINSCREEN CLADDING RCEMENT RAINSCREEN CLADDING RCEMENT RAINSCREEN CLADDING	GLEN-GERY ELGIN BUTLER ELGIN BUTLER ELGIN BUTLER LINETEC NYSTROM - - - EQUITONE EQUITONE EQUITONE EQUITONE		MODEL / SERIES	BW SERIES 8W SERIES 8W SERIES	E COLOR / FINISH COLOR / FINISH NAPA VALLEY SMOOTH IRONSPOT SPICY WHITE SPICY WHITE BLACK ANO-305 AE BLACK ANO-305 AE N074 N359 LA60	SURFACE DENSIFIER, SEALED FINISH EPOXY FINISH - PROVIDE COVE BASES, BULLNOSE CORNER SHAPE LOCATIONS REFER TO DRAWINGS FOR PROFILE AND DIMENSIO COMMERCIAL STAINLESS STEEL COUNTER -
IS (E F V X E (C C C C C C C C C C C C C	BALLASTS: GC MOUNTING: GI VOLTAGE: REH CHICAGO PLEN SUSPENDED F SUSPENDED F SUSPENDED F CHICAGO PLEN SUSPENDED F SUSPENDED F SUSPENDE F SUSPENDE F SUSPENDE F SUSPENDE F SUSPENDE F SUSPENDE F SUSPEND	C/ ELECTRICAL SU C TO PROVIDE AI FER TO ENGINEE <u>NUM:</u> ALL FIXTUR IXTURE INSTALL/ MATERIAL PER RCP PER RCP	UB TO COORDI DDITIONAL CE RING DOCUME RES WHEN INS ATION HEIGHT:	INATE ALL BALLAST ILING GRID TEES AI ENTS TALLED WITHIN TH : INSTALLATION HE MATERIAL CONC CONC CONC CONC CONC CONC CONC CON	IS WITH SPECIF ND MAINS AS R E CITY OF CHIC EIGHT FOR SUS OOR FINISH CONC-1 CONC-1 CONC-1 CONC-1 CONC-1 CONC-1 CONC-1 CONC-1 CONC-2 CONC-2 CONC-2 CONC-2 CONC-2 CONC-2 CONC-2 CONC-2 CONC-2	EQUIRED FOR LC AGO TO COMPLY PENDED FIXTURE MATERIAL PER SCHEDULE PER SCHEDULE PER SCHEDULE PER SCHEDULE PER SCHEDULE PER SCHEDULE PER SCHEDULE PER SCHEDULE PER SCHEDULE B-1 B-1 B-1 B-1 B-1 B-1 B-1 B-1 B-1 B-1	ASE PER SCHEDULE PER SCHEDULE	CTURE AS SHOWN O PLENUM REQU SURED TO [BOTTO BOTTO BOTTO BOTTO BOTTO SGT-1 SGT-1 SGT	N IN PLANS UIREMENTS. OM OF FIXTUR ISCHEDULE IORTH GLAZED GLAZED GLAZED GLAZED GLAZED GLAZED GLAZED	MATERIAL SGT-1 SGT-1 SGT	SOUTH L FINISH GLAZED GLAZED GLAZED GLAZED GLAZED GLAZED P-1 P-1 EXPOSED P-1	MATERIAL SGT-1 SGT-1 SGT-1 SGT-1 SGT-1 SGT-1 SGT-1 GYP-1 GYP-1 GYP-1 GYP-1 GYP-1 GYP-1	GLAZED GLAZED GLAZED GLAZED GLAZED	MATERIAL SGT-1 SGT-1 SGT-1 SGT-1 SGT-1 SGT-1 SGT-1 SGT-1 GYP-1 GYP-1 EXPOSED GYP-1 GYP-1 GYP-1 GYP-1	FINISH GLAZED GLAZED GLAZED GLAZED GLAZED GLAZED GLAZED GLAZED P-1 P-1	COMMENTS	CONC-2 CAST 03 CONCRETE CONC-1 CAST 04 MASONRY CLAD-1 BRICK CLAD-2 GLAZI SGT-1 STRU 05 METALS EMT-1 BRAK EMT-5 ROOF MT-1 STAIN STL-1 STRU 06 WOODS, PLAST CLAD-3 FIBER CLAD-5 FIBER EWD-4 3" WO	-IN-PLACE CONCRETE -IN-PLACE CONCRETE K VENEER ED TILE RAINSCREEN ICTRAL GLAZED TILE KE METAL, FLASHING, AND TRIM F ACCESSS HATCH VLESS STEEL ICTURAL STEEL, SEE STRUCTURAL TICS, COMPOSITES RCEMENT RAINSCREEN CLADDING RCEMENT RAINSCREEN CLADDING	GLEN-GERY ELGIN BUTLER ELGIN BUTLER ELGIN BUTLER LINETEC NYSTROM - EQUITONE EQUITONE EQUITONE	ER PRODUCTS	MODEL / SERIES	BW SERIES 8W SERIES 8W SERIES	E COLOR / FINISH COLOR / FINISH NAPA VALLEY SMOOTH IRONSPOT SPICY WHITE SPICY WHITE BLACK ANO-305 AE N074 N359	SURFACE DENSIFIER, SEALED FINISH EPOXY FINISH - PROVIDE COVE BASES, BULLNOSE CORNER SHAILOCATIONS REFER TO DRAWINGS FOR PROFILE AND DIMENS

	ROOM FINISH SCHEDULE															
		CE	EILING	FL	FLOOR		ASE				N	VALLS				
ROOM NUMBER	ROOM NAME	MATERIAL	FINISH	MATERIAL	FINISH	MATERIAL	FINISH		NORTH	SC	DUTH	E	AST	W	EST	COMMENTS
			riviori		TIMOT		TINIST	MATE	RIAL FINISH	MATERIAL	FINISH	MATERIAL	FINISH	MATERIAL	FINISH	
CONCESSIONS																
100	CONCESSIONS	PER RCP	P-1	CONC	CONC-1	PER SCHEDULE	PER SCHEDULE	SGT-1	GLAZED	SGT-1	GLAZED	SGT-1	GLAZED	SGT-1	GLAZED	
101	ВОН	PER RCP	P-1	CONC	CONC-2	PER SCHEDULE	PER SCHEDULE	SGT-1	GLAZED	SGT-1	GLAZED	SGT-1	GLAZED	SGT-1	GLAZED	
102	MECH/ELEC	PER RCP	P-1	CONC	CONC-2	PER SCHEDULE	PER SCHEDULE	SGT-1	EXPOSED	SGT-1	GLAZED	SGT-1	GLAZED	SGT-1	GLAZED	
103	FAMILY	PER RCP	P-1	CONC	CONC-1	PER SCHEDULE	PER SCHEDULE	SGT-1	GLAZED	SGT-1	GLAZED	SGT-1	GLAZED	SGT-1	GLAZED	
104	WOMEN'S RESTROOM	PER RCP	P-1	CONC	CONC-1	PER SCHEDULE	PER SCHEDULE	SGT-1	GLAZED	SGT-1	GLAZED	SGT-1	GLAZED	SGT-1	GLAZED	
105	MEN'S RESTROOM	PER RCP	P-1	CONC	CONC-1	PER SCHEDULE	PER SCHEDULE	SGT-1	GLAZED	SGT-1	GLAZED	SGT-1	GLAZED	SGT-1	GLAZED	
MAINTENANCE																
M100	CORRIDOR	PER RCP	P-1	CONC	CONC-2	B-1	PER SCHEDULE	GYP-1	P-1	SGT-1	P-1	GYP-1	P-1	GYP-1	P-1	
M101	OFFICE 1	PER RCP	P-1	CONC	CONC-2	B-1	PER SCHEDULE	GYP-1	P-1	GYP-1	P-1	GYP-1	P-1	GYP-1	P-1	
M102	MECHANICAL ROOM	PER RCP	P-1	CONC	CONC-2	B-1	PER SCHEDULE	GYP-1	P-1	EXPOSED	EXPOSED	GYP-1	P-1	EXPOSED	EXPOSED	
M103	RESTROOM	PER RCP	P-1	CONC	CONC-1	B-1	PER SCHEDULE	GYP-1	P-1	GYP-1	P-1	GYP-1	P-1	GYP-1	P-1	
M104	STORAGE ROOM	PER RCP	P-1	CONC	CONC-2	B-1	PER SCHEDULE	GYP-1	P-1	EXPOSED	EXPOSED	GYP-1	P-1	GYP-1	P-1	
M105	OFFICE 2	PER RCP	P-1	CONC	CONC-2	B-1	PER SCHEDULE	GYP-1	P-1	GYP-1	P-1	GYP-1	P-1	GYP-1	P-1	
M106	EQUIPMENT STORAGE AREA	PER RCP	EXPOSED	CONC	CONC-1	B-1	PER SCHEDULE	EXPOSED	EXPOSED	EXPOSED	EXPOSED	EXPOSED	EXPOSED	GYP-1	P-1	FRP PANELLING @ SERVICE SIN PLAN

	DESCRIPTION			MATERIAL AND FINISH SCHEDULE										
		MANUFACTURER	MODEL / SERIES	PRODUCT / CODE	COLOR / FINISH	COMMENTS								
02 000000	CAST-IN-PLACE CONCRETE					SURFACE DENSIFIER, SEALED FINISH								
03 CONCRE	TE													
CONC-1	CAST-IN-PLACE CONCRETE					EPOXY FINISH								
04 MASONR	Y													
CLAD-1	BRICK VENEER	GLEN-GERY			NAPA VALLEY SMOOTH IRONSPOT	-								
	GLAZED TILE RAINSCREEN	ELGIN BUTLER		8W SERIES	SPICY WHITE									
SGT-1	STRUCTRAL GLAZED TILE	ELGIN BUTLER		8W SERIES	SPICY WHITE	PROVIDE COVE BASES, BULLNOSE CORNER SHAPES AT ALL LOCATIONS								
05 METALS				un										
EMT-1	BRAKE METAL, FLASHING, AND TRIM	LINETEC			BLACK ANO-305 AE	REFER TO DRAWINGS FOR PROFILE AND DIMENSIONS								
EMT-5	ROOF ACCESSS HATCH	NYSTROM												
MT-1	STAINLESS STEEL	-	-			COMMERCIAL STAINLESS STEEL COUNTER								
STL-1	STRUCTURAL STEEL, SEE STRUCTURAL					-								
06 WOODS,	PLASTICS, COMPOSITES													
CLAD-3	FIBERCEMENT RAINSCREEN CLADDING	EQUITONE	NATURA		N074									
CLAD-4	FIBERCEMENT RAINSCREEN CLADDING	EQUITONE	NATURA		N359									
CLAD-5	FIBERCEMENT RAINSCREEN CLADDING	EQUITONE	LUNARA		LA60									
	3" WOOD SOFFIT	MONTANA TIMBER PRODUCTS	TONGUE AND GROOVE/ 6"		YELLOWSTONE / WIREBRUSHED	CONCEALED FASTENERS								
	PLYWOOD SHEATHING	COLUMBIA FOREST	PUREBOND											
	OSB ROOF SHEATHING W/ INTEGRATED WRB	HUBER ENGINEERED WOODS	ZIP SYSTEM SHEATHING	TBD		SPECIFIED THICKNESS IS AVAILABLE IN RED/BROWN ZIP PANELS ONLY								
PL-2	TOILET PARTITIONS	BRADLEY CORPORATION	EURO STYLE RESTROOM PARTITIONS	PHENOLIC LT - FLOAT SERIES	MANHATTEN 12204									
SS-1	SOLID SURFACE	CORIAN	SOLID SURFACE		SUEDE	PROVIDE EASED EDGE								
07 THERMA	L AND MOISTURE PROTECTION													
GYP-1	GYPSUM BOARD	-				-								
INSUL-1	EXTRUDED POLYSTYRENE INSULATION					-								
INSUL-2	RIGID INSULATION, POLYISOCYANURATE					-								
	MINERAL WOOL BATT INSULATION	ROCKWOOL	COMFORTBATT			WALL AND ROOF CAVITIES WHERE INDICATED; R-23 AT WALLS, R=35 (MIN) AT ROOFS; ACOUSTICT BATT WHERE INDICATED								
INSUL-4	CLOSED CELL SPRAY FOAM INSULATION	NATURAL POLYMERS, OR EQ.	ULTRA-PURE, OR EQ.			LOW-GWP HFO BLOWING AGENT; PROVIDE THICKNESS REQUIRED FOR CONTINUOUS AIR BARRIER								
INSUL-5	RIGID INSULATION, THERMOSET PHENOLIC CORE	KINGSPAN, OR EQ.				INTEGRAL INSULATION AT INSULATED WALL AND ROOF PANELS, AS SCHEDULED								
MP-1	INSULATED METAL PANEL	KINGSPAN, OR EQ.	KARRIER, OR EQ.	4" CORE (INSUL-5)	(KINGSPAN) GRIZZLE GRAY - REVIEW COLOR SAMPLES W/ ARCHITECT PRIOR TO FABRICATION	BY PREFABRICATOR; PROVIDE R-30 (MIN) THERMAL PERFORMANCE								
MP-2	INSULATED METAL PANEL	KINGSPAN, OR EQ.	KARRIER, OR EQ., VERTICAL FLAT RAIL	4" CORE (INSUL-5)	(KINGSPAN) GRIZZLE GRAY - REVIEW COLOR SAMPLES W/ ARCHITECT PRIOR TO FABRICATION	BY PREFABRICATOR; PROVIDE R-30 (MIN) THERMAL PERFORMANCE								
RF-1	STANDING SEAM METAL ROOFING	AEP SPAN			MATCH (KINGSPAN) PEPPERCORN - REVIEW COLOR SAMPLES W/ ARCHITECT PRIOR TO FABRICATION	PRODUCT MUST BE ALLOWED BY MANUFACTURER TO BE INSTALLED ON PITCHES AS LOW AS 1/4":12" FOR INSTALLATION AT LOW-SLOPE LOCATIONS, INCLUDING DRAINAGE CRICKETS WHERE INDICATED								
RF-2	STANDING SEAM METAL ROOFING	TBD			MATCH (KINGSPAN) PEPPERCORN - REVIEW COLOR SAMPLES W/ ARCHITECT PRIOR TO FABRICATION	BY PREFABRICATOR; MUST BE ALLOWED BY MANUFACTURER TO BE INSTALLED ON PITCHES AS LOW AS 1":12"								
RF-3	STANDING SEAM INSULATED PANEL ROOFING	KINGSPAN, OR EQ.	KINGSEAM, OR EQ.	6" CORE (INSUL-5)	(KINGSPAN) PEPPERCORN - REVIEW COLOR SAMPLES W/ ARCHITECT PRIOR TO FABRICATION	BY PREFABRICATOR; PROVIDE R-46 (MIN) THERMAL PERFORMANCE								
UL-1	ROOFING UNDERLAYMENT	AEP SPAN	UNDERLAYMENT HT											
09 FINISHES		'		1		,								
B-1	WALL BASE	ROPPE	CONTOURS PROFILED WALL BASE SYSTEM	PV4060	BLACK	4 1/4" HEIGHT								
T-1	PORCELAIN TILE	MILE STONE	AREA 51	1104033	WHITE	40" WAINSCOT AT MAINTENANCE RESTROOM								

